

**LAND-MARK SURVEYING**

**Mark L. Miritz**

Wisconsin Registered Land Surveyor S-2582

N9330 Knuteson Drive  
Whitewater, WI 53190  
Phone: (262) 495-3284  
FAX : (262) 495-8421  
LAND-MARKSURVEYING.COM

**PLAT OF SURVEY**

LOTS 11 THROUGH 14, BLOCK 7,  
FOREST BEACH SUBDIVISION,  
LOCATED IN PART OF THE NW 1/4  
OF SECTION 9, TOWN 3 NORTH,  
RANGE 15 EAST, RICHMOND  
TOWNSHIP, WALWORTH COUNTY,  
WISCONSIN

ORDERED BY:  
SCHAUDER BUILDING, INC.  
4115 U.S. HIGHWAY 51 NORTH  
JANESVILLE, WI 53545-9674

OWNER: MICHELLE L. BROWN



**LOT 10**

**LOT 15**

**LOT 11**

**TAX KEY CFB-46**  
18,187 SQ. FT.

**LOT 12**

**LOT 13**

**LOT 14**

**LOT 8**

**LOT 9**


**LOT 10**

**LOT 11**

**LAKE DRIVE**

**FOREST STREET VACATED**

**VACATED BIRCH STREET**

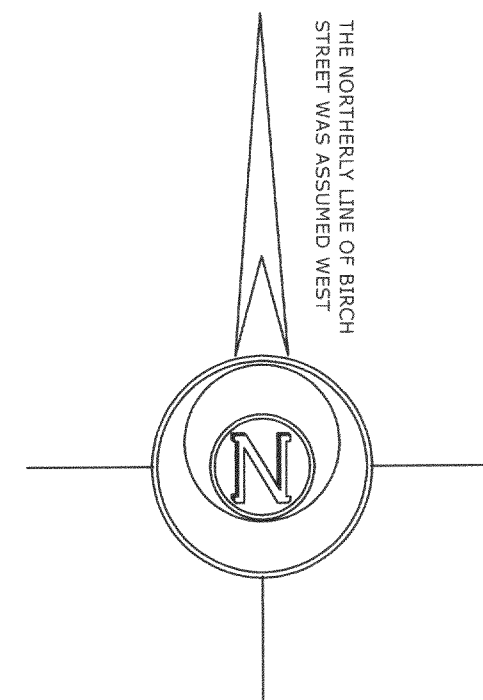

**LEGEND**

- FOUND IRON ROD
- FOUND IRON PIPE
- FOUND CONCRETE MONUMENT
- SET IRON ROD, 24" LONG, WEIGHING 1.5 LBS./LINEAL FT., 3/4" DIA.
- RECORDED AS DIMENSION
- EXISTING FENCE

SCALE: 1" = 30 FEET

"I hereby certify that the above described property has been surveyed by me or under my direction and that the above map is a true representation thereof and shows the size and location of the property, its exterior boundaries, the location of all visible structures and dimensions of all principal buildings thereon, boundary fences, apparent easements, roadways and visible encroachments, if any."  
"This survey is made for the use of the present owners of the property, and also those who purchase, mortgage, or guarantee the title thereto within one year from date hereof."

**MARK L. MIRITZ**  
WISCONSIN REGISTERED  
LAND SURVEYOR S-2582

DATE: MARCH 15, 2005 JOB NO. 04.1104

REVISED NOV. 4, 2005 TO  
SHOW RELOCATED GARAGE  
& FOUNDATION AS BUILT

CFB-46

315-938