

ABERNATHY and ASSOCIATES

Kenneth B. Abernathy Jr.

Wisconsin Registered Land Surveyor S-1594



Rt. 3, Box 273
Elkhorn, Wisconsin 53121
Phone: (414) 723-4260 (office)
(414) 723-4813 (residence)

PLAT OF SURVEY

THE EAST 1/2 OF LOT 3, LOT 4
AND LOT 5, BLOCK 21, 2ND MAP
OF INTERLAKEN SUBDIVISION,
LOCATED IN SECTION 3, TOWN 3
NORTH, RANGE 16 EAST, SUGAR
CREEK TOWNSHIP, WALWORTH
COUNTY, WISCONSIN.

ORDERED BY:
MYRON MATHISON
CENTURY 21 AFFILIATED
50 WEST GENEVA ST.
P.O. BOX 367
WILLIAMS BAY, WI. 53191

OWNER: KEVIN PLOSZAJ

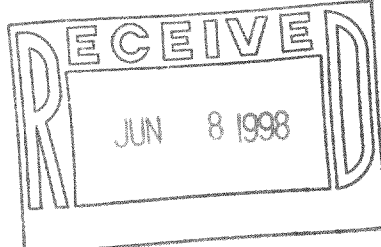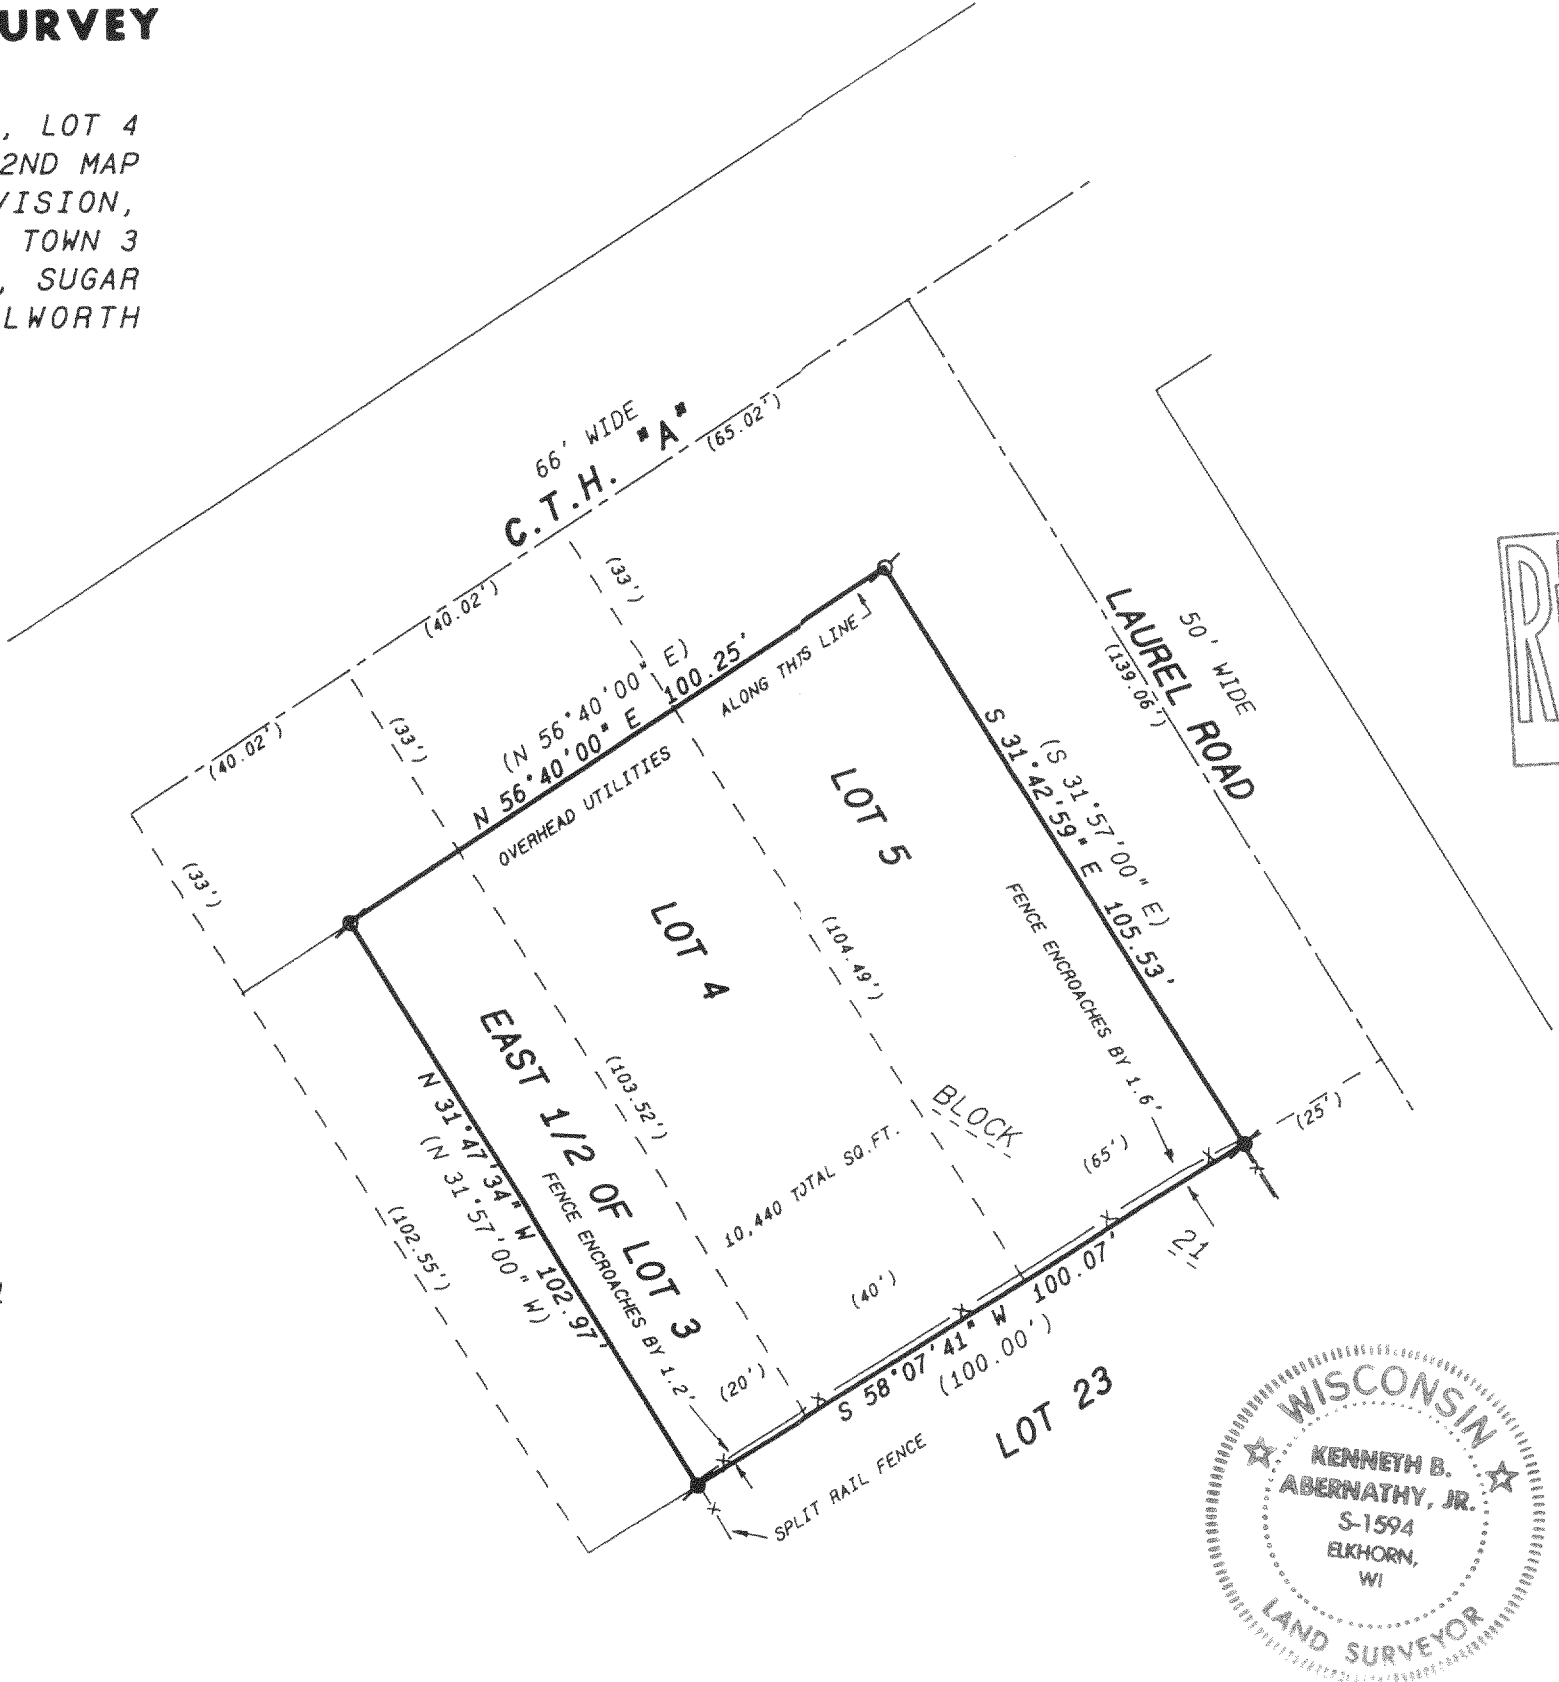

SCALE: 1"=30 FEET

Legend

- FOUND IRON PIPE
- FOUND IRON ROD
- FOUND BRASS CAPPED MONUMENT
- FOUND CONCRETE MONUMENT
- CHISEL CUT IN CONCRETE
- SET IRON ROD, 24" LONG, WEIGHING 1.5 LBS./LINEAL FT., 3/4" DIA.
- SET IRON ROD, 30" LONG, WEIGHING 4.5 LBS./LINEAL FT., 1-11/16" DIA.
- (xx) RECORDED AS DIMENSION
- x-x- EXISTING FENCE

"I hereby certify that I have surveyed the above described property and that the above map is a true representation thereof and shows the size and location of the property, its exterior boundaries, the location of all visible structures and dimensions of all principal buildings thereon, boundary fences, apparent easements, roadways and visible encroachments, if any."
"This survey is made for the use of the present owners of the property, and also those who purchase, mortgage, or guarantee the title thereto within one year from date hereof."

Kenneth B. Abernathy Jr.

KENNETH B. ABERNATHY, JR.
WISCONSIN REGISTERED LAND SURVEYOR,
S-1594

Date: 6-1-98 Job No. 98.522



316-1025
GI-257C