


LOT 8 OF "SYLVAN TRACE SUBDIVISION" LOCATED IN SECTION 2, TOWN 3 NORTH, RANGE 16 EAST, IN THE TOWN OF SUGAR CREEK, COUNTY OF WALWORTH, STATE OF WISCONSIN.

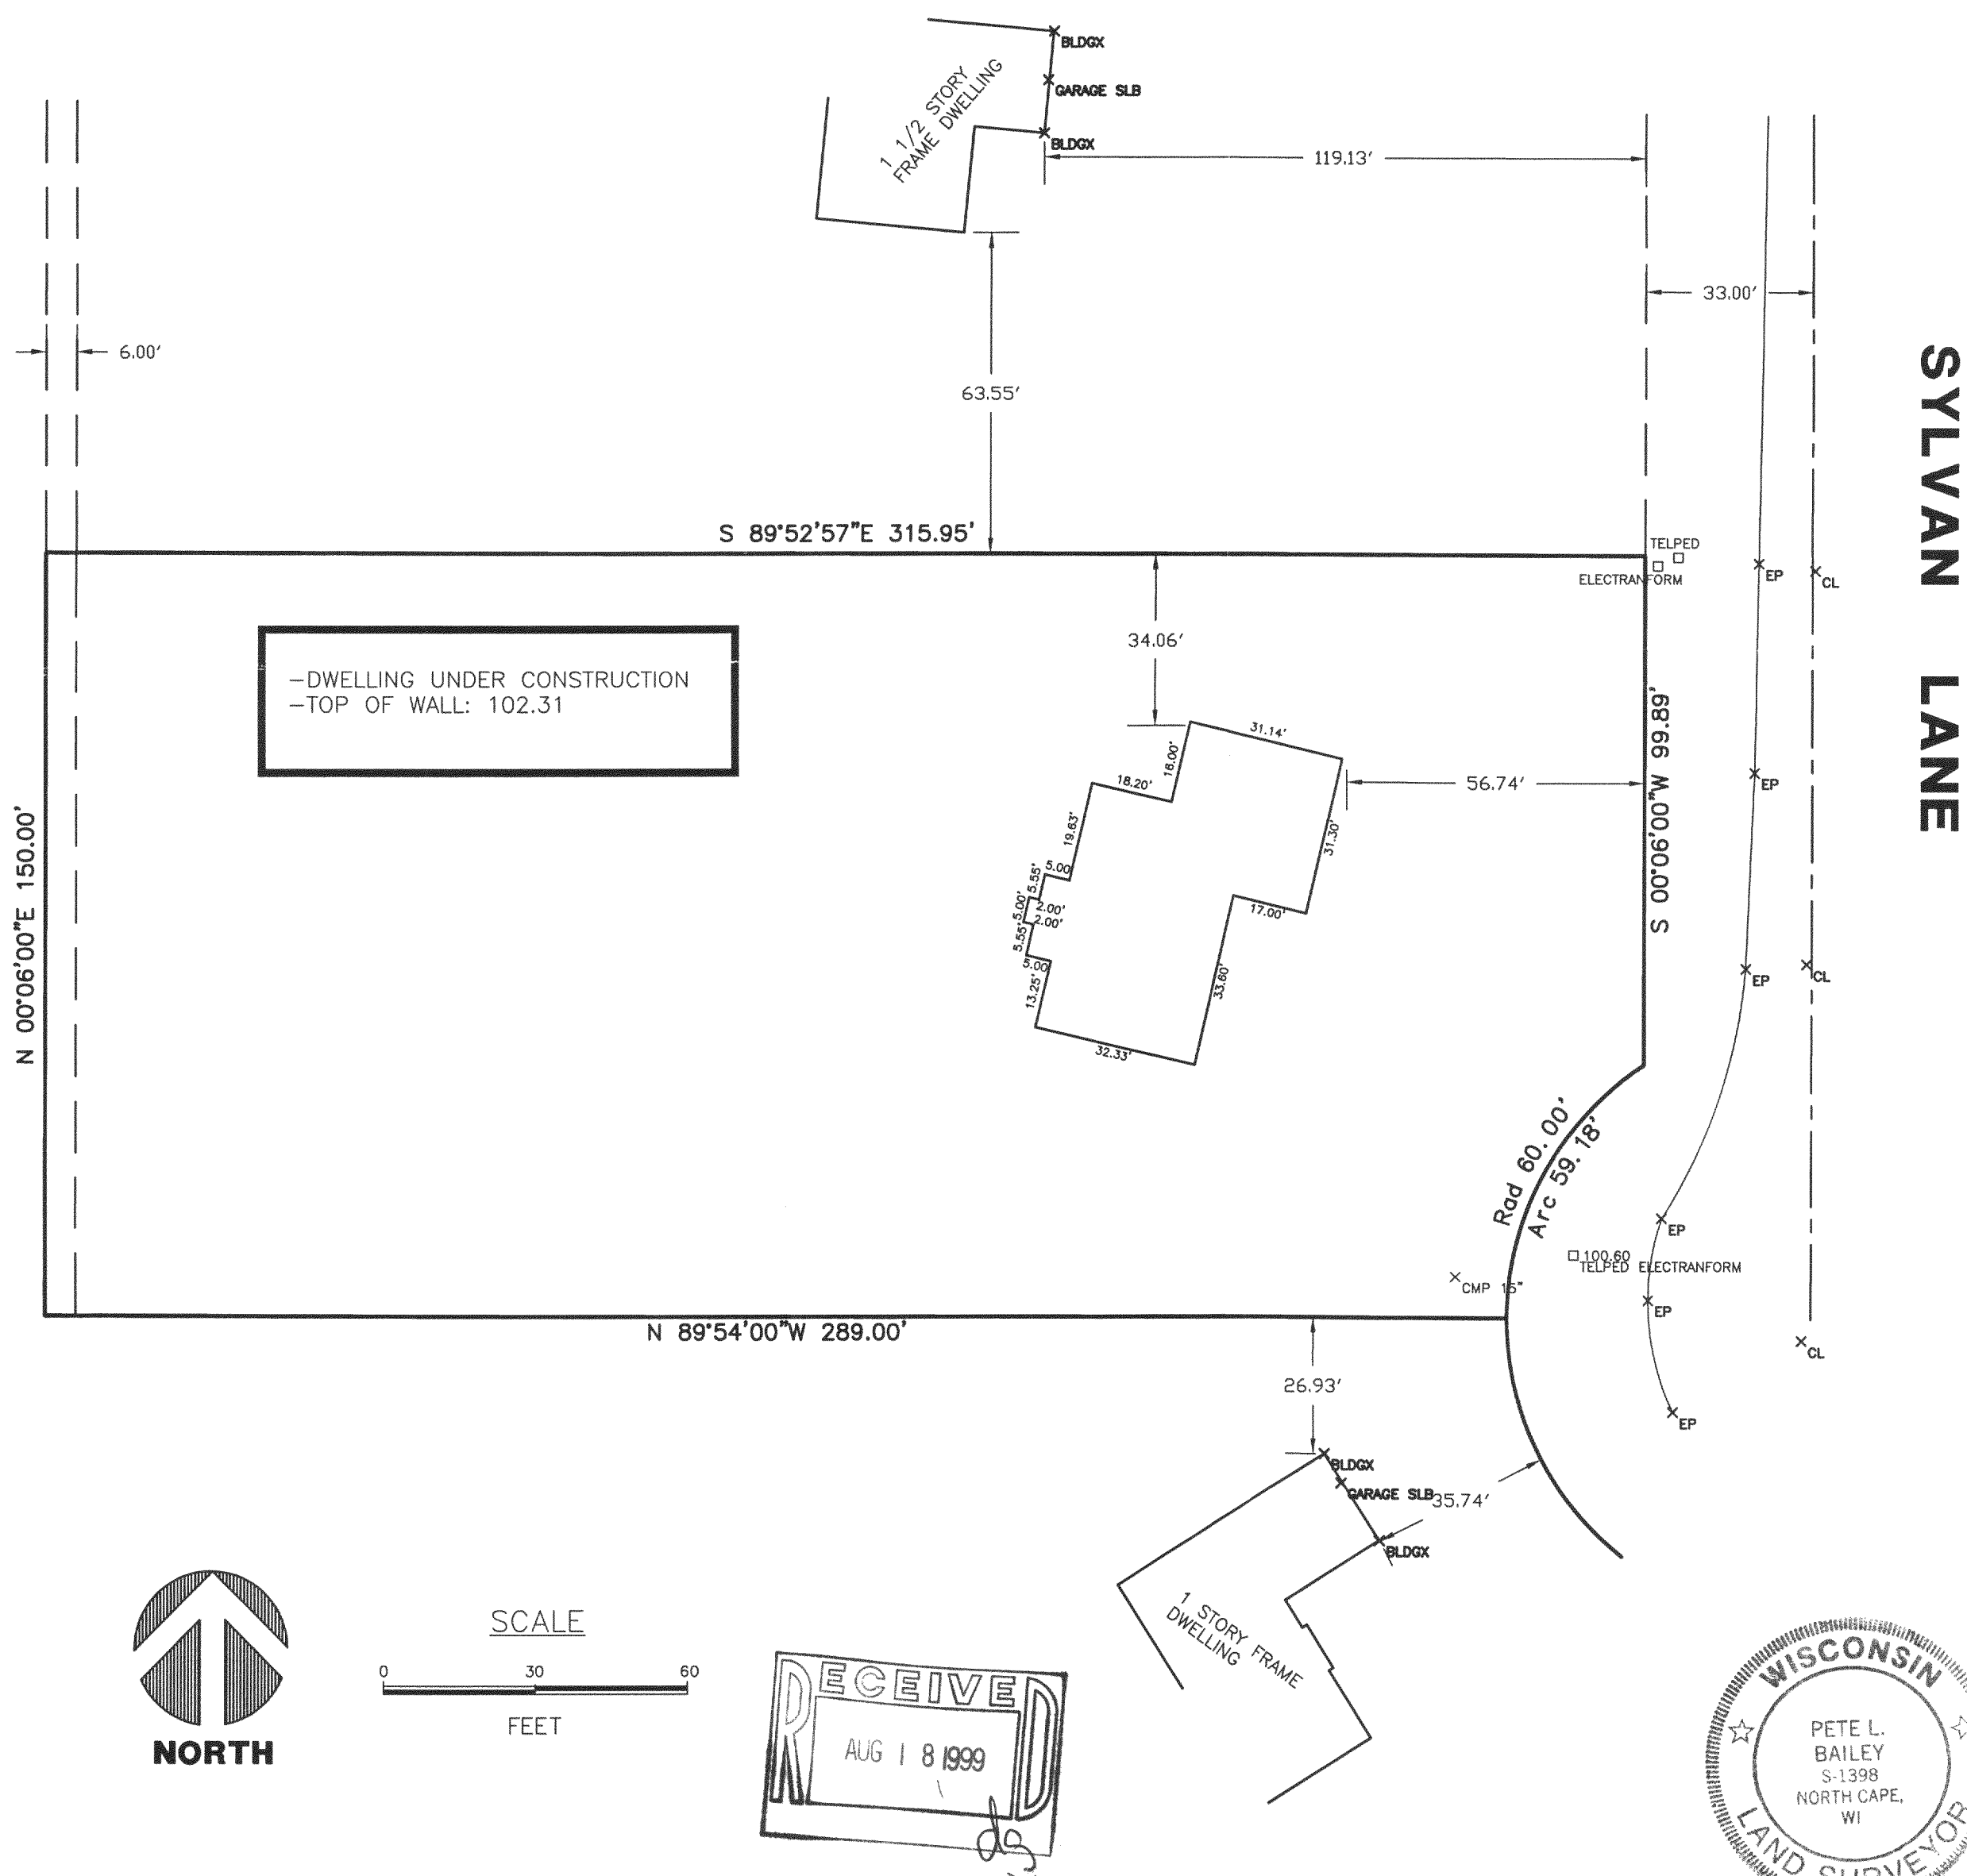

|                                                                                          |          |
|------------------------------------------------------------------------------------------|----------|
| <b>AMERICAN SURVEYING COMPANY, INC.</b>                                                  |          |
| 12207 C.T.H. "K" FRANKSVILLE, WISCONSIN 53126<br>TEL. (414) 835-4774 FAX: (414) 835-2379 |          |
| DRAWN BY:                                                                                | PLB      |
| CHECKED BY:                                                                              | PLB      |
| PLOT SCALE:                                                                              | 1 = 30   |
| DATE:                                                                                    | 05/05/99 |
| JOB NO.:                                                                                 | 99.032   |
| DWG. FILE:                                                                               | JN99098  |
| REVISIONS:                                                                               | DATE     |

**TOWN OF SUGAR CREEK**

**PROJECT:**

**PLAT OF SURVEY / STAKE OUT SURVEY**

**OWNERS, ROBIN & KAREN HANCOCK**

**PREPARED FOR: BADGER HOME BUILDERS, INC.**

**Sheet**

**1**

**of**

**1**

STATE OF WISCONSIN  
COUNTY OF RACINE

I HEREBY CERTIFY THAT I HAVE SURVEYED THE ABOVE DESCRIBED PROPERTY AND THE ABOVE MAP IS A TRUE REPRESENTATION THEREOF AND SHOWS THE SIZE AND LOCATION OF THE PROPERTY, ITS EXTERIOR BOUNDARIES, THE LOCATION OF ALL VISIBLE STRUCTURE AND DIMENSIONS OF ALL PRINCIPLE BUILDINGS THEREON, BOUNDARY FENCES, APPARENT EASEMENTS, ROADWAYS AND VISIBLE ENCROACHMENTS, IF ANY.

THIS SURVEY IS MADE FOR THE PRESENT OWNERS OF THE PROPERTY, AND ALSO THOSE WHO PURCHASE, MORTGAGE, OR GUARANTEE THE TITLE THEREOF WITHIN ONE (1) YEAR FROM THE DATE THEREOF.

DATED AT: NORTH CAPE, THIS 5TH DAY OF APRIL, 1999.

*P. L. Bailey*

AMERICAN SURVEYING COMPANY, INC.  
PETE L. BAILEY, RLS NO. 1398  
RECERIFIED this 21ST day of JULY, 1999.



65T-8 316-1113