

ABERNATHY and ASSOCIATES

Kenneth B. Abernathy Jr.

Wisconsin Registered Land Surveyor S-1594

Rt. 3, Box 273
Elkhorn, Wisconsin 53121
Phone: (414) 723-4260 (office)
(414) 723-7209 (FAX)

PLAT OF SURVEY

LOT 33 OF SYLVAN TRACE
SUBDIVISION, LOCATED IN
SECTION 2, TOWN 3 NORTH,
RANGE 16 EAST, WALWORTH
COUNTY, WISCONSIN.



OWNERS: CHARLOTTE A. McHUGH
VINCENT J. McHUGH
3837 NORTH BELL AVE.
CHICAGO, IL. 60618-3811

ORDERED BY: MARY GOSTOMSKI
REALTY CENTER
27 S. BROAD ST.
ELKHORN, WI. 53121

LOT 34


DETAIL OF RESIDENCE

SCALE 1" = 20 FEET

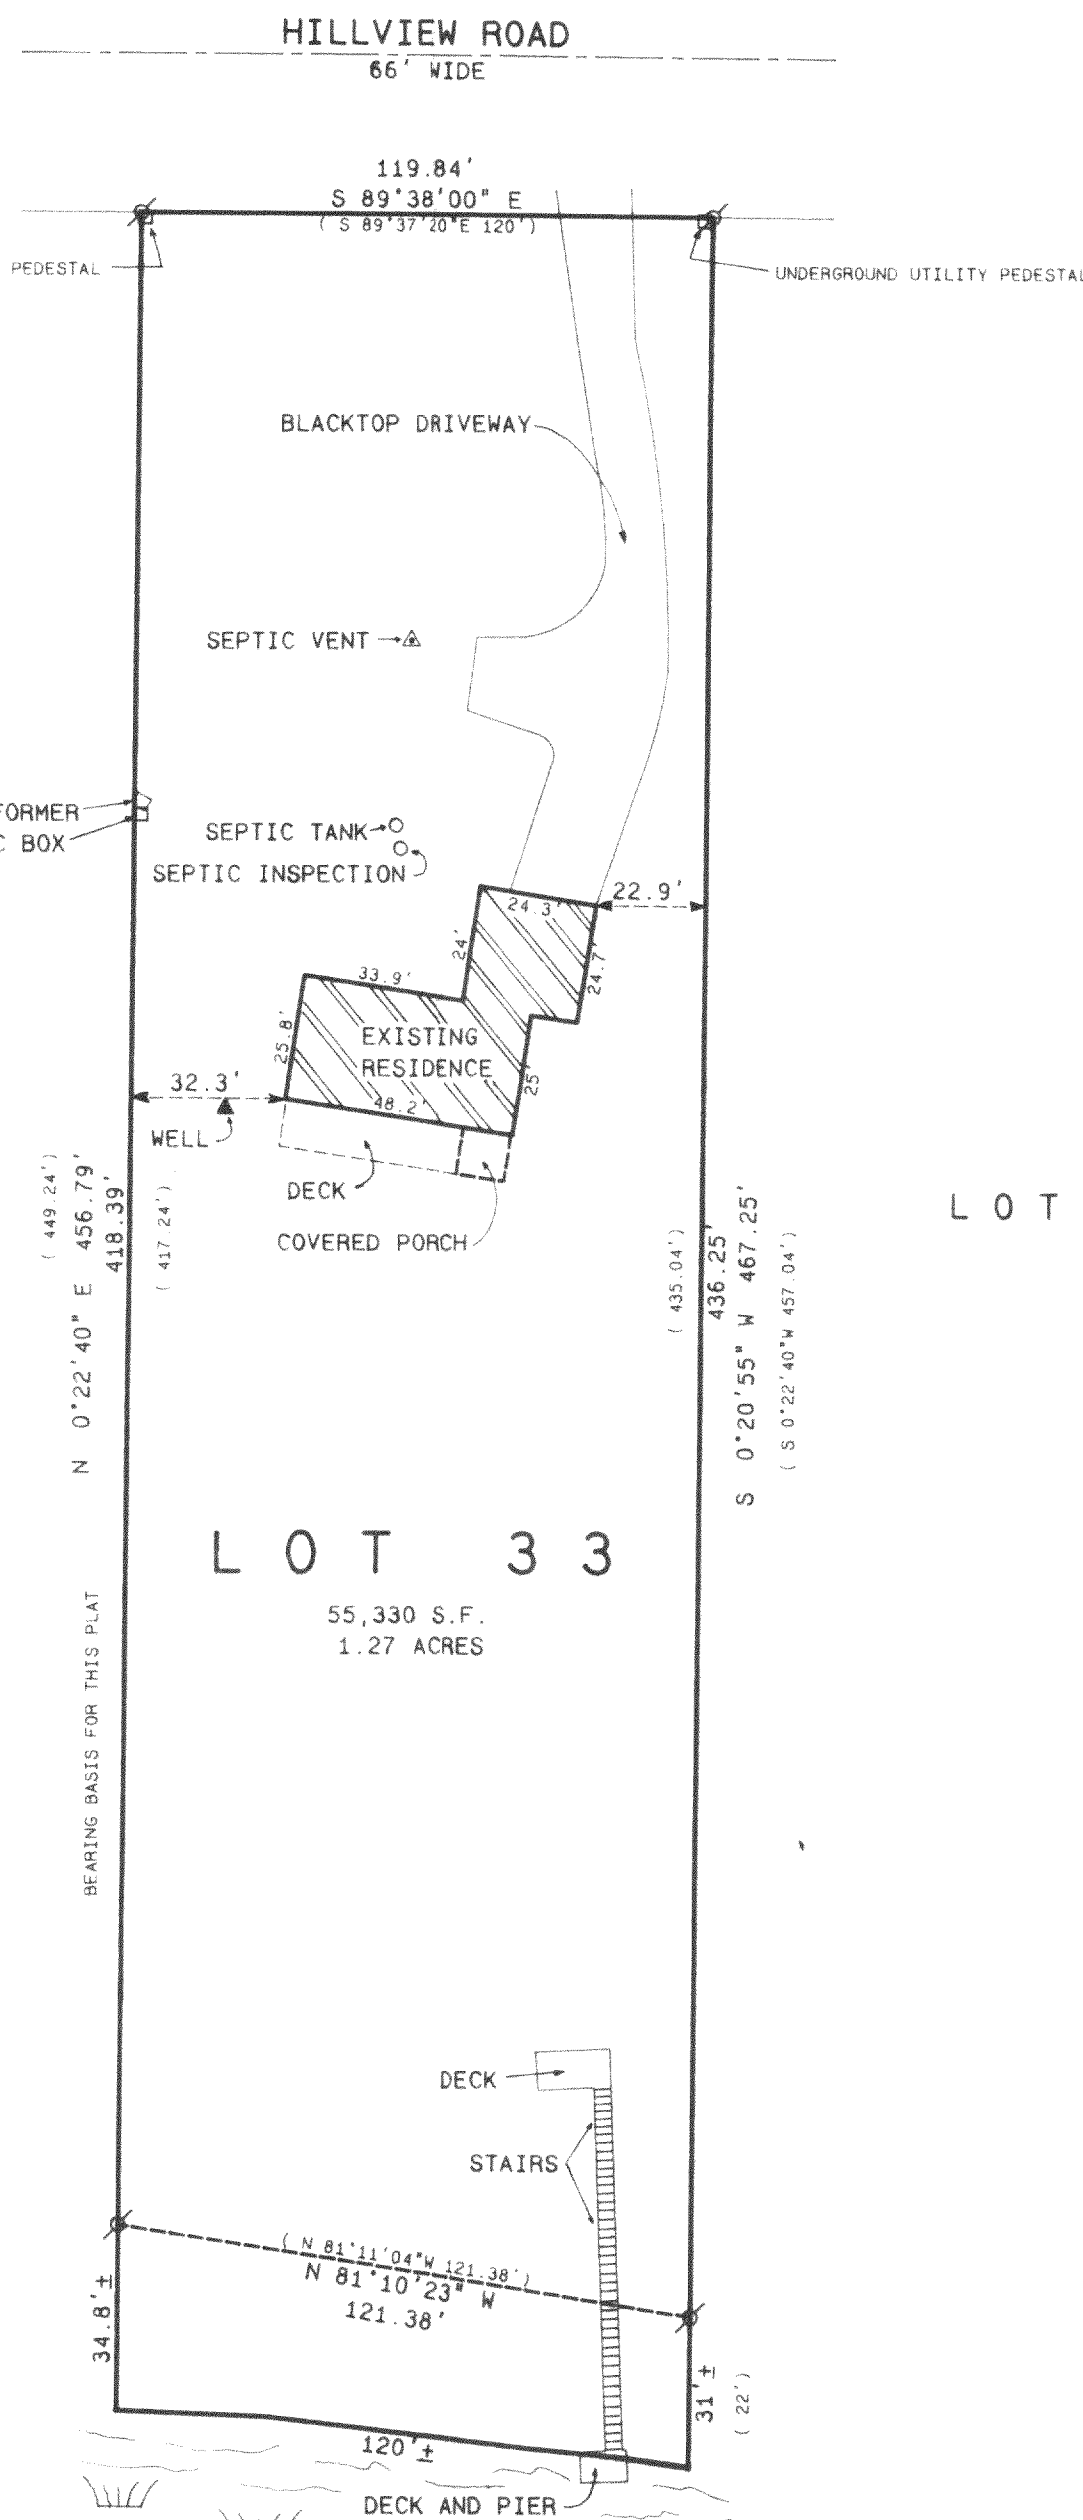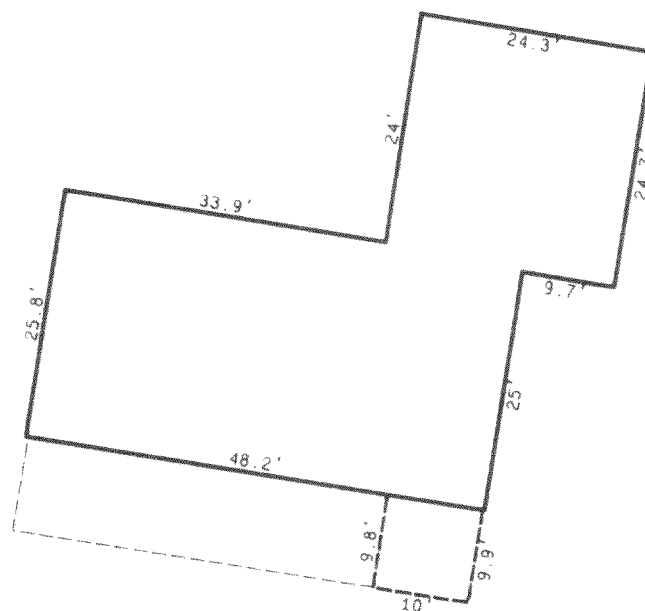

LAKE WANDAEWEGA

100 YEAR FLOOD ELEV. = 888.50'
LOCATED BETWEEN MEANDER LINE AND SHORLINE

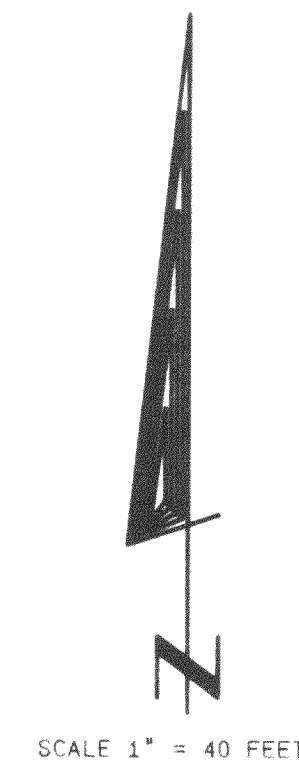


SCALE 1" = 40 FEET


LOT 32

Legend

- FOUND IRON PIPE
- FOUND IRON ROD
- FOUND BRASS CAPPED MONUMENT
- FOUND CONCRETE MONUMENT
- CHISEL CUT IN CONCRETE
- SET IRON ROD, 24" LONG, WEIGHING 1.5 LBS., LINEAL FT., 3/4" DIA.
- SET IRON ROD, 30" LONG, WEIGHING 4.5 LBS., LINEAL FT., 1-11/16" DIA.
- RECORDED AS DIMENSION
- EXISTING FENCE

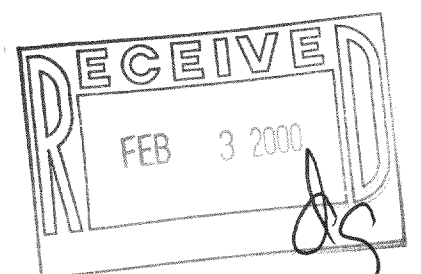

SCALE: 1" = 40 FEET

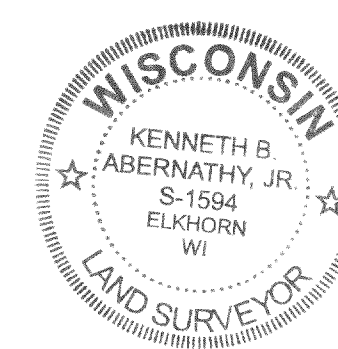

"I hereby certify that the above described property has been surveyed by me or under my direction and that the above map is a true representation thereof and shows the size and location of the property, its exterior boundaries, the location of all visible structures and dimensions of all principal buildings thereon, boundary fences, apparent easements, roadways and visible encroachments, if any."
"This survey is made for the use of the present owners of the property, and also those who purchase, mortgage, or guarantee the title thereto within one year from date hereof."

Kenneth B. Abernathy, Jr.
KENNETH B. ABERNATHY, JR.
WISCONSIN REGISTERED LAND SURVEYOR,
S-1594

Date: 1/11/00 Job No. 99.12.11

316-1146

GST-33