


ABELL
SURVEYING & MAPPING

1140 SEQUOIA STREET • DELAVAN, WISCONSIN 53115
262-728-6737

PLAT OF SURVEY OF

LOT 8, BLOCK 10, COOL HILL PARK ADDITION NO. 1,
T3N.R16E, WALWORTH COUNTY, WISCONSIN.

ORDERED BY: RICHARD HOWARTH
850 N. WISCONSIN ST.
ELKHORN, WI 53121

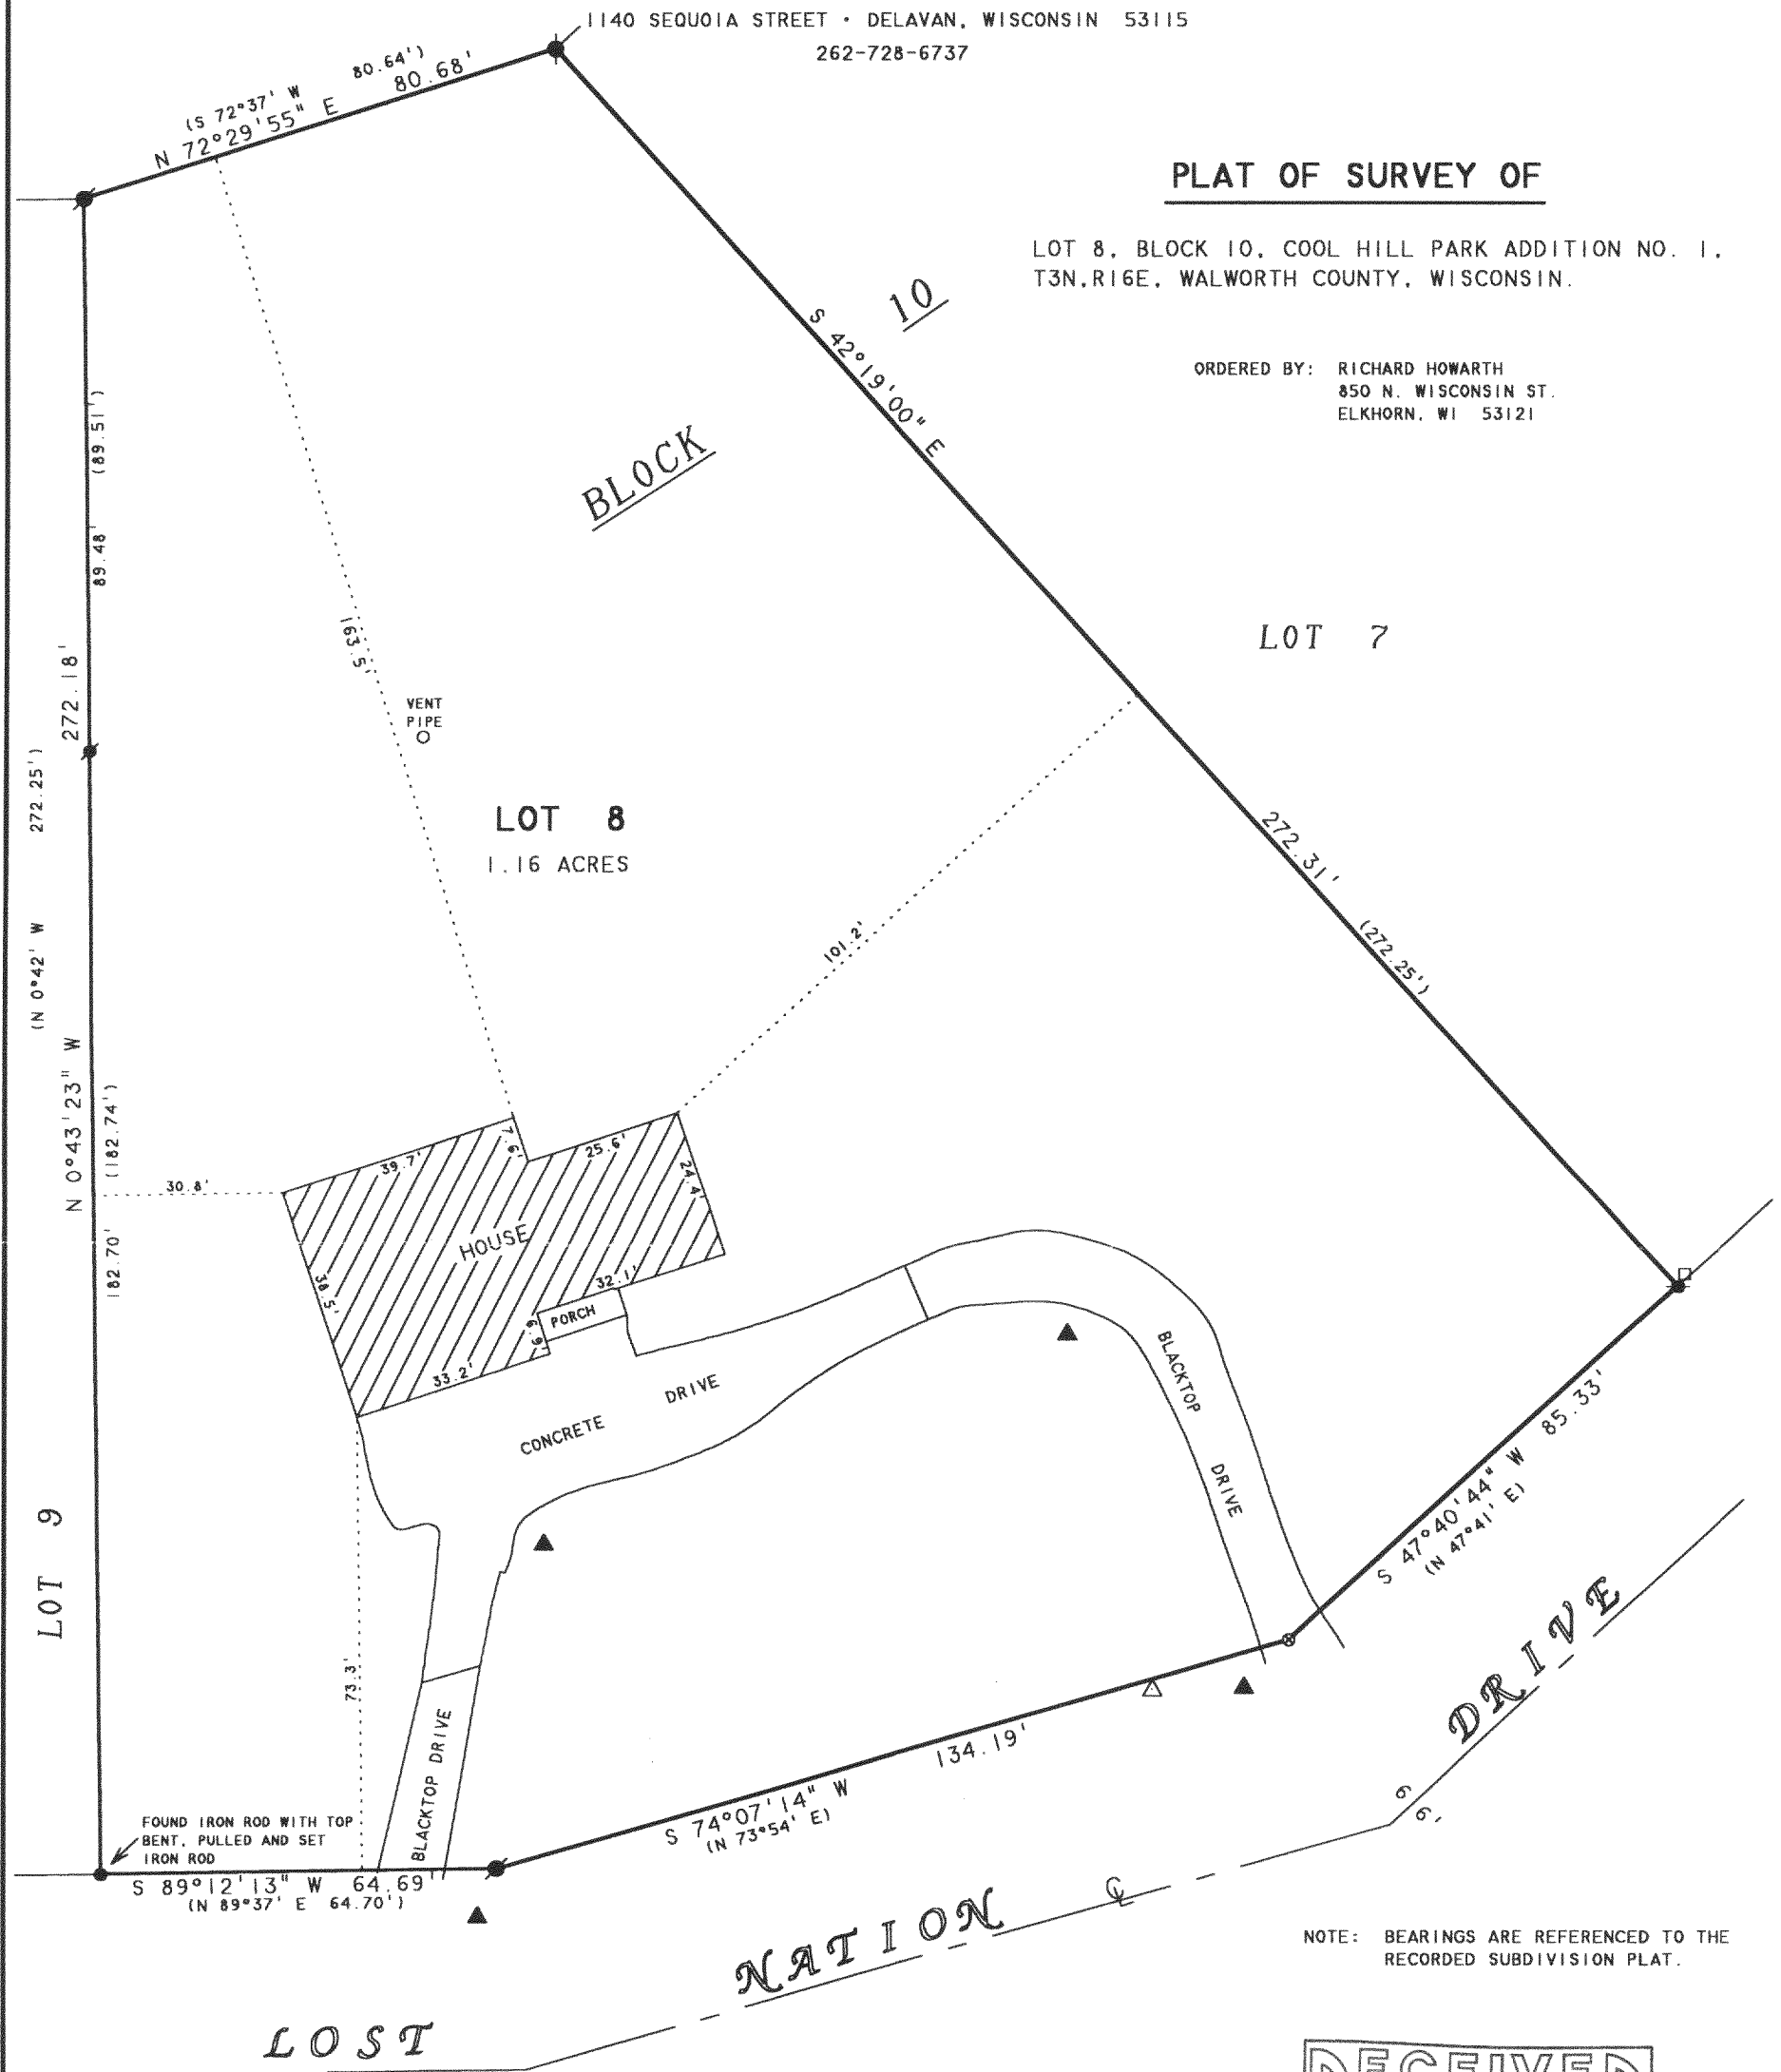

LOST


N



SCALE 1"=30'

LEGEND

- - IRON ROD FOUND
- - IRON BAR FOUND
- - 3/4" DIA. IRON ROD SET
- ⊗ - PK NAIL SET
- ▲ - YARD LIGHT
- △ - UTILITY POLE
- - UTILITY PED
- () - RECORDED AS

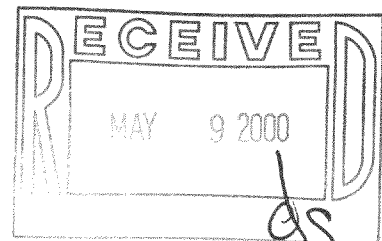

I, DAVID F. ABELL, DO HEREBY CERTIFY THAT I HAVE SURVEYED THE PROPERTY HEREON DESCRIBED ACCORDING TO THE OFFICAL RECORDS AND THAT THE PLAT HEREON IS A CORRECT REPRESENTATION OF THE PROPERTY LINES TO THE BEST OF MY KNOWLEDGE AND BELIEF.

David F. Abell

DAVID F. ABELL
WISCONSIN REGISTERED LAND SURVEYOR, S-1596

March 9, 2000

DATE: _____ JOB NUMBER - 99060
NOTE: THIS IS NOT A CERTIFIED COPY UNLESS SEALED.

GCHA-8

316-1170