


GEORGE T. DUNHAM  
SURVEYING & SUBDIVIDING  
DELAVER, WISCONSIN

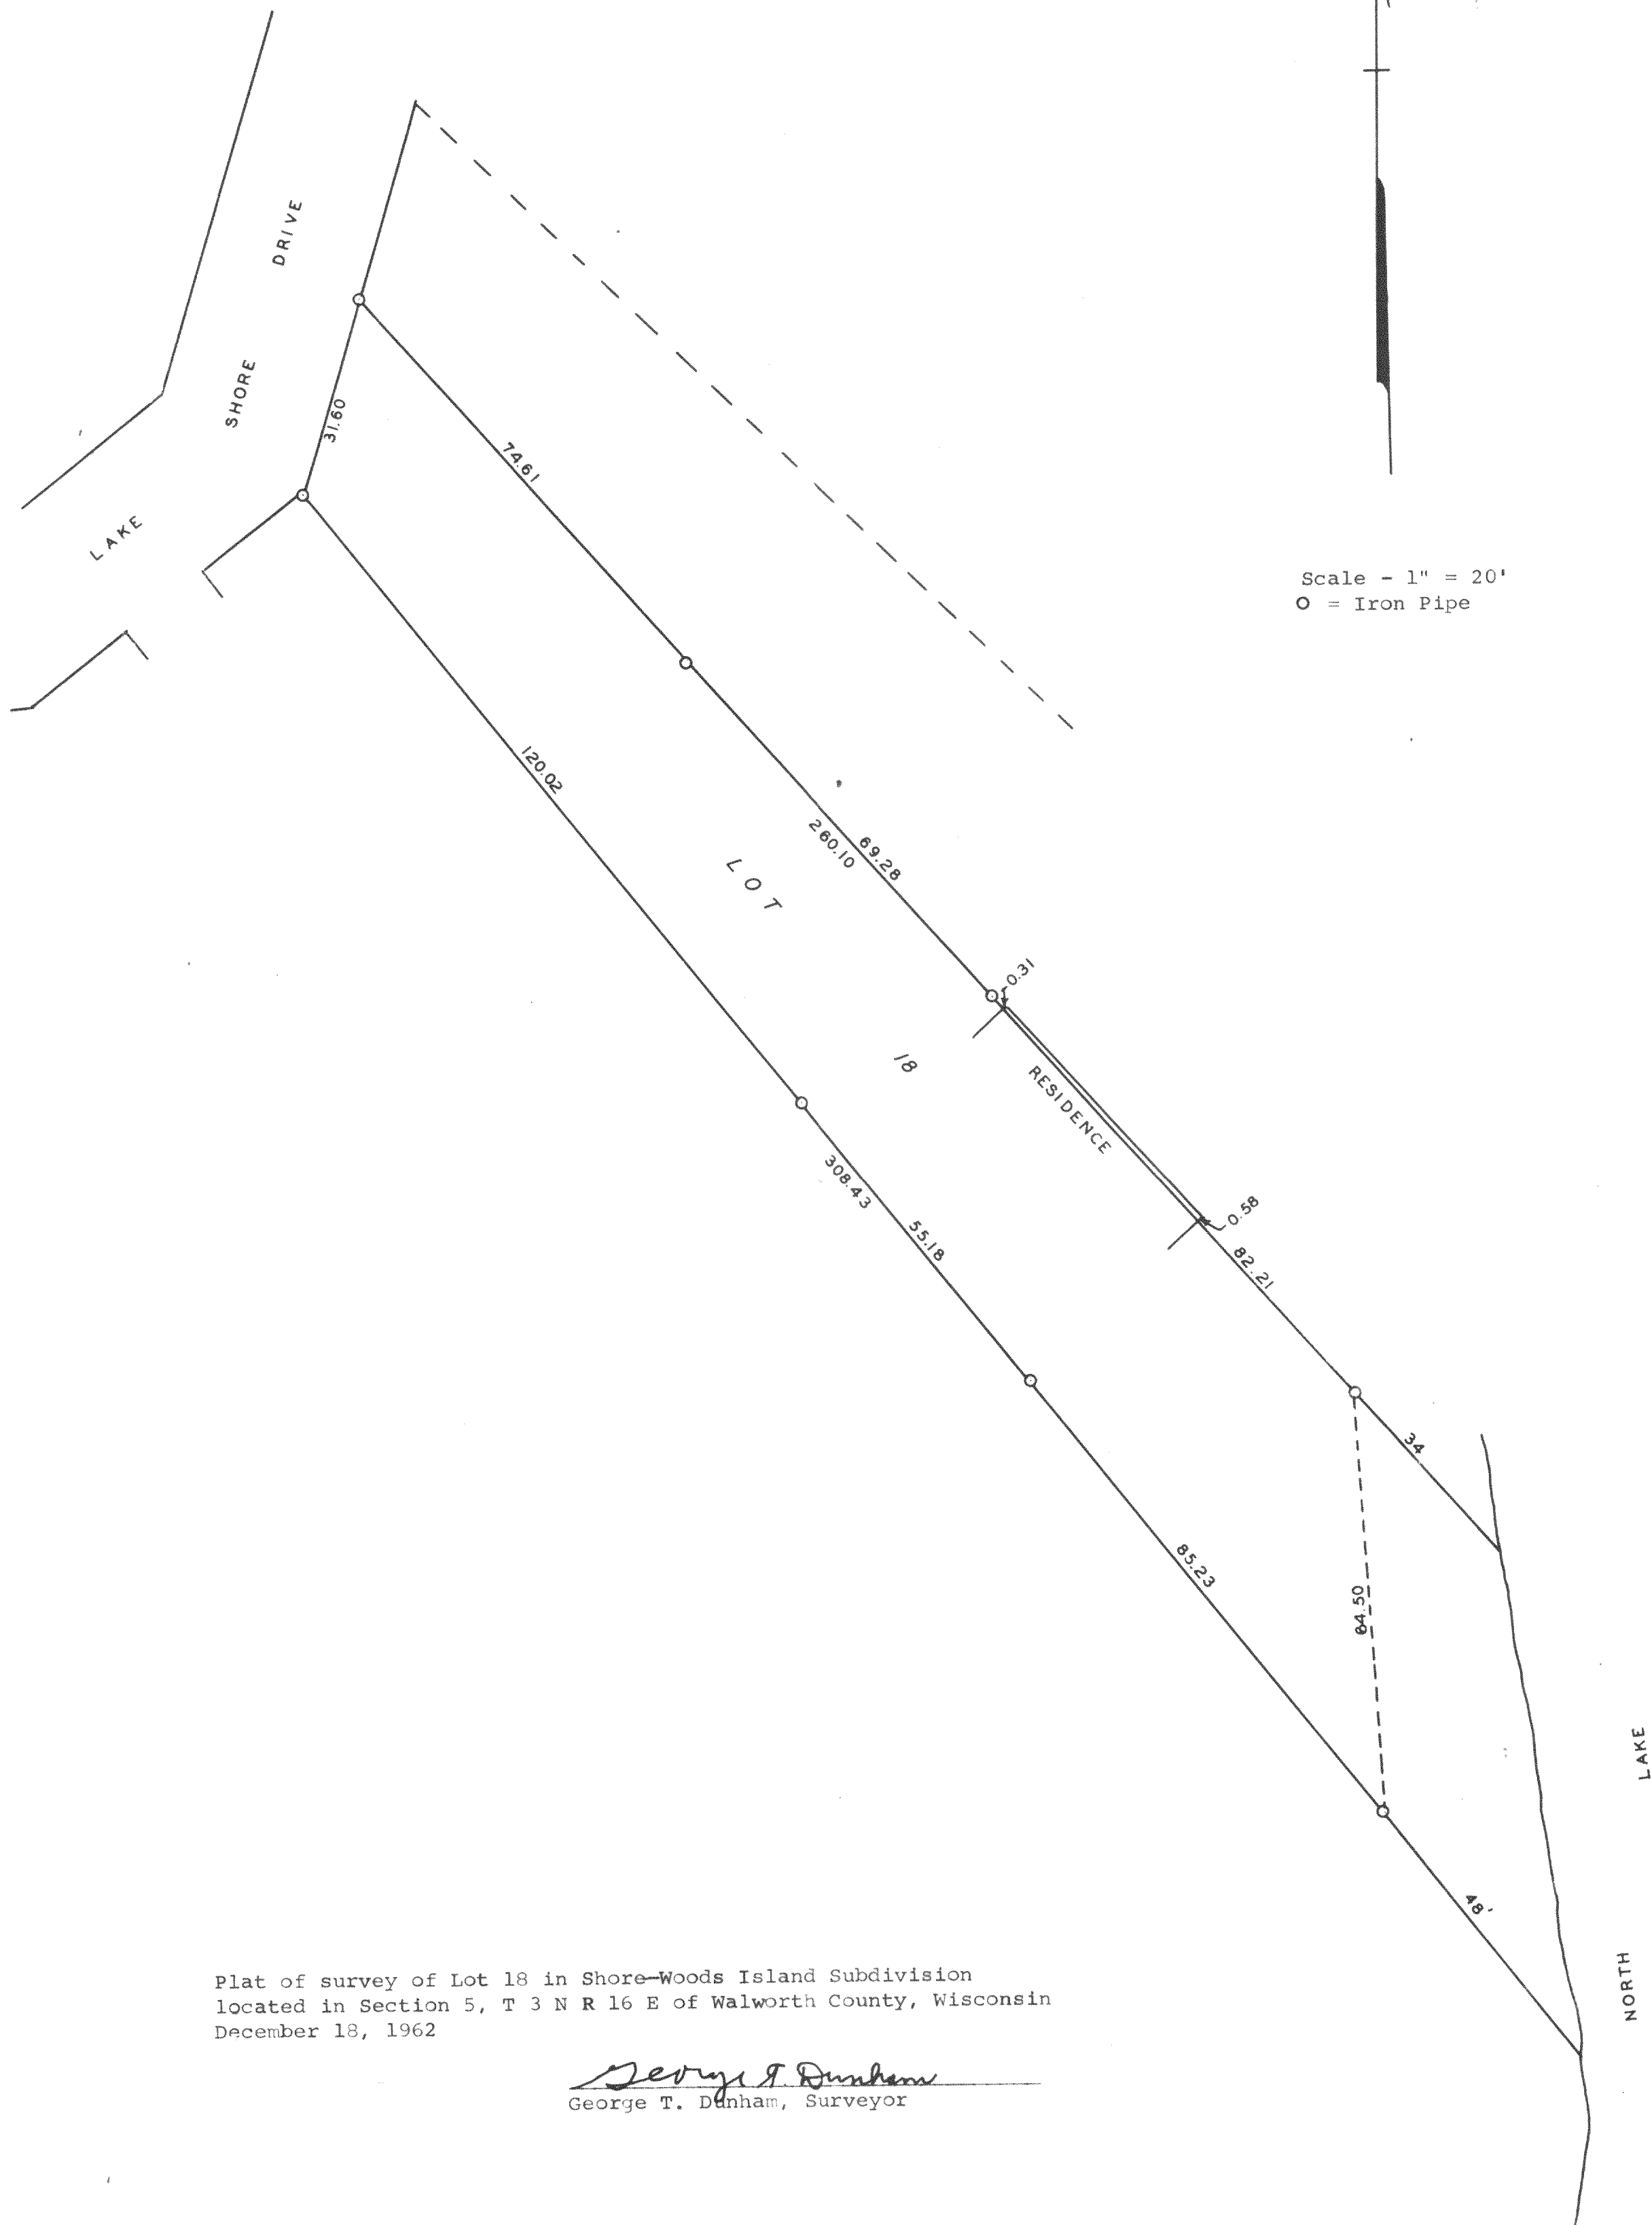

Plat of survey of Lot 18 in Shore-Woods Island Subdivision  
located in Section 5, T 3 N R 16 E of Walworth County, Wisconsin  
December 18, 1962

*George T. Dunham*  
George T. Dunham, Surveyor

GSI-9