

The above-described property has been surveyed under my direction and the above map is a correct representation thereof.

DATED AT: NORTH CAPE, THIS 12TH DAY OF JUNE, 2000.



AMERICAN SURVEYING COMPANY, INC.
PETE L. BAILEY, RLS NO. 1398
RECERTIFIED this _____ day of _____, 2000.

LEGAL DESCRIPTION:


UNIT 70 OF "LAUDERDALE LAKES CONDOMINIUM" BEING A PART OF THE NORTHWEST 1/4 OF THE
SOUTHEAST 1/4 OF SECTION 1, TOWN 3 NORTH, RANGE 16 EAST, IN THE TOWN OF SUGAR CREEK,
COUNTY OF WALWORTH, STATE OF WISCONSIN.

SCALE

A horizontal number line is shown with tick marks at 0, 30, and 60. The word "FEET" is written below the line.

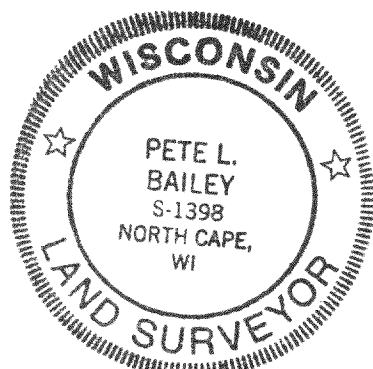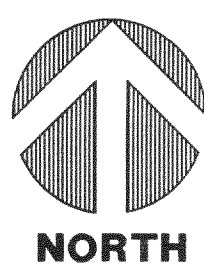

S.T.H. 67

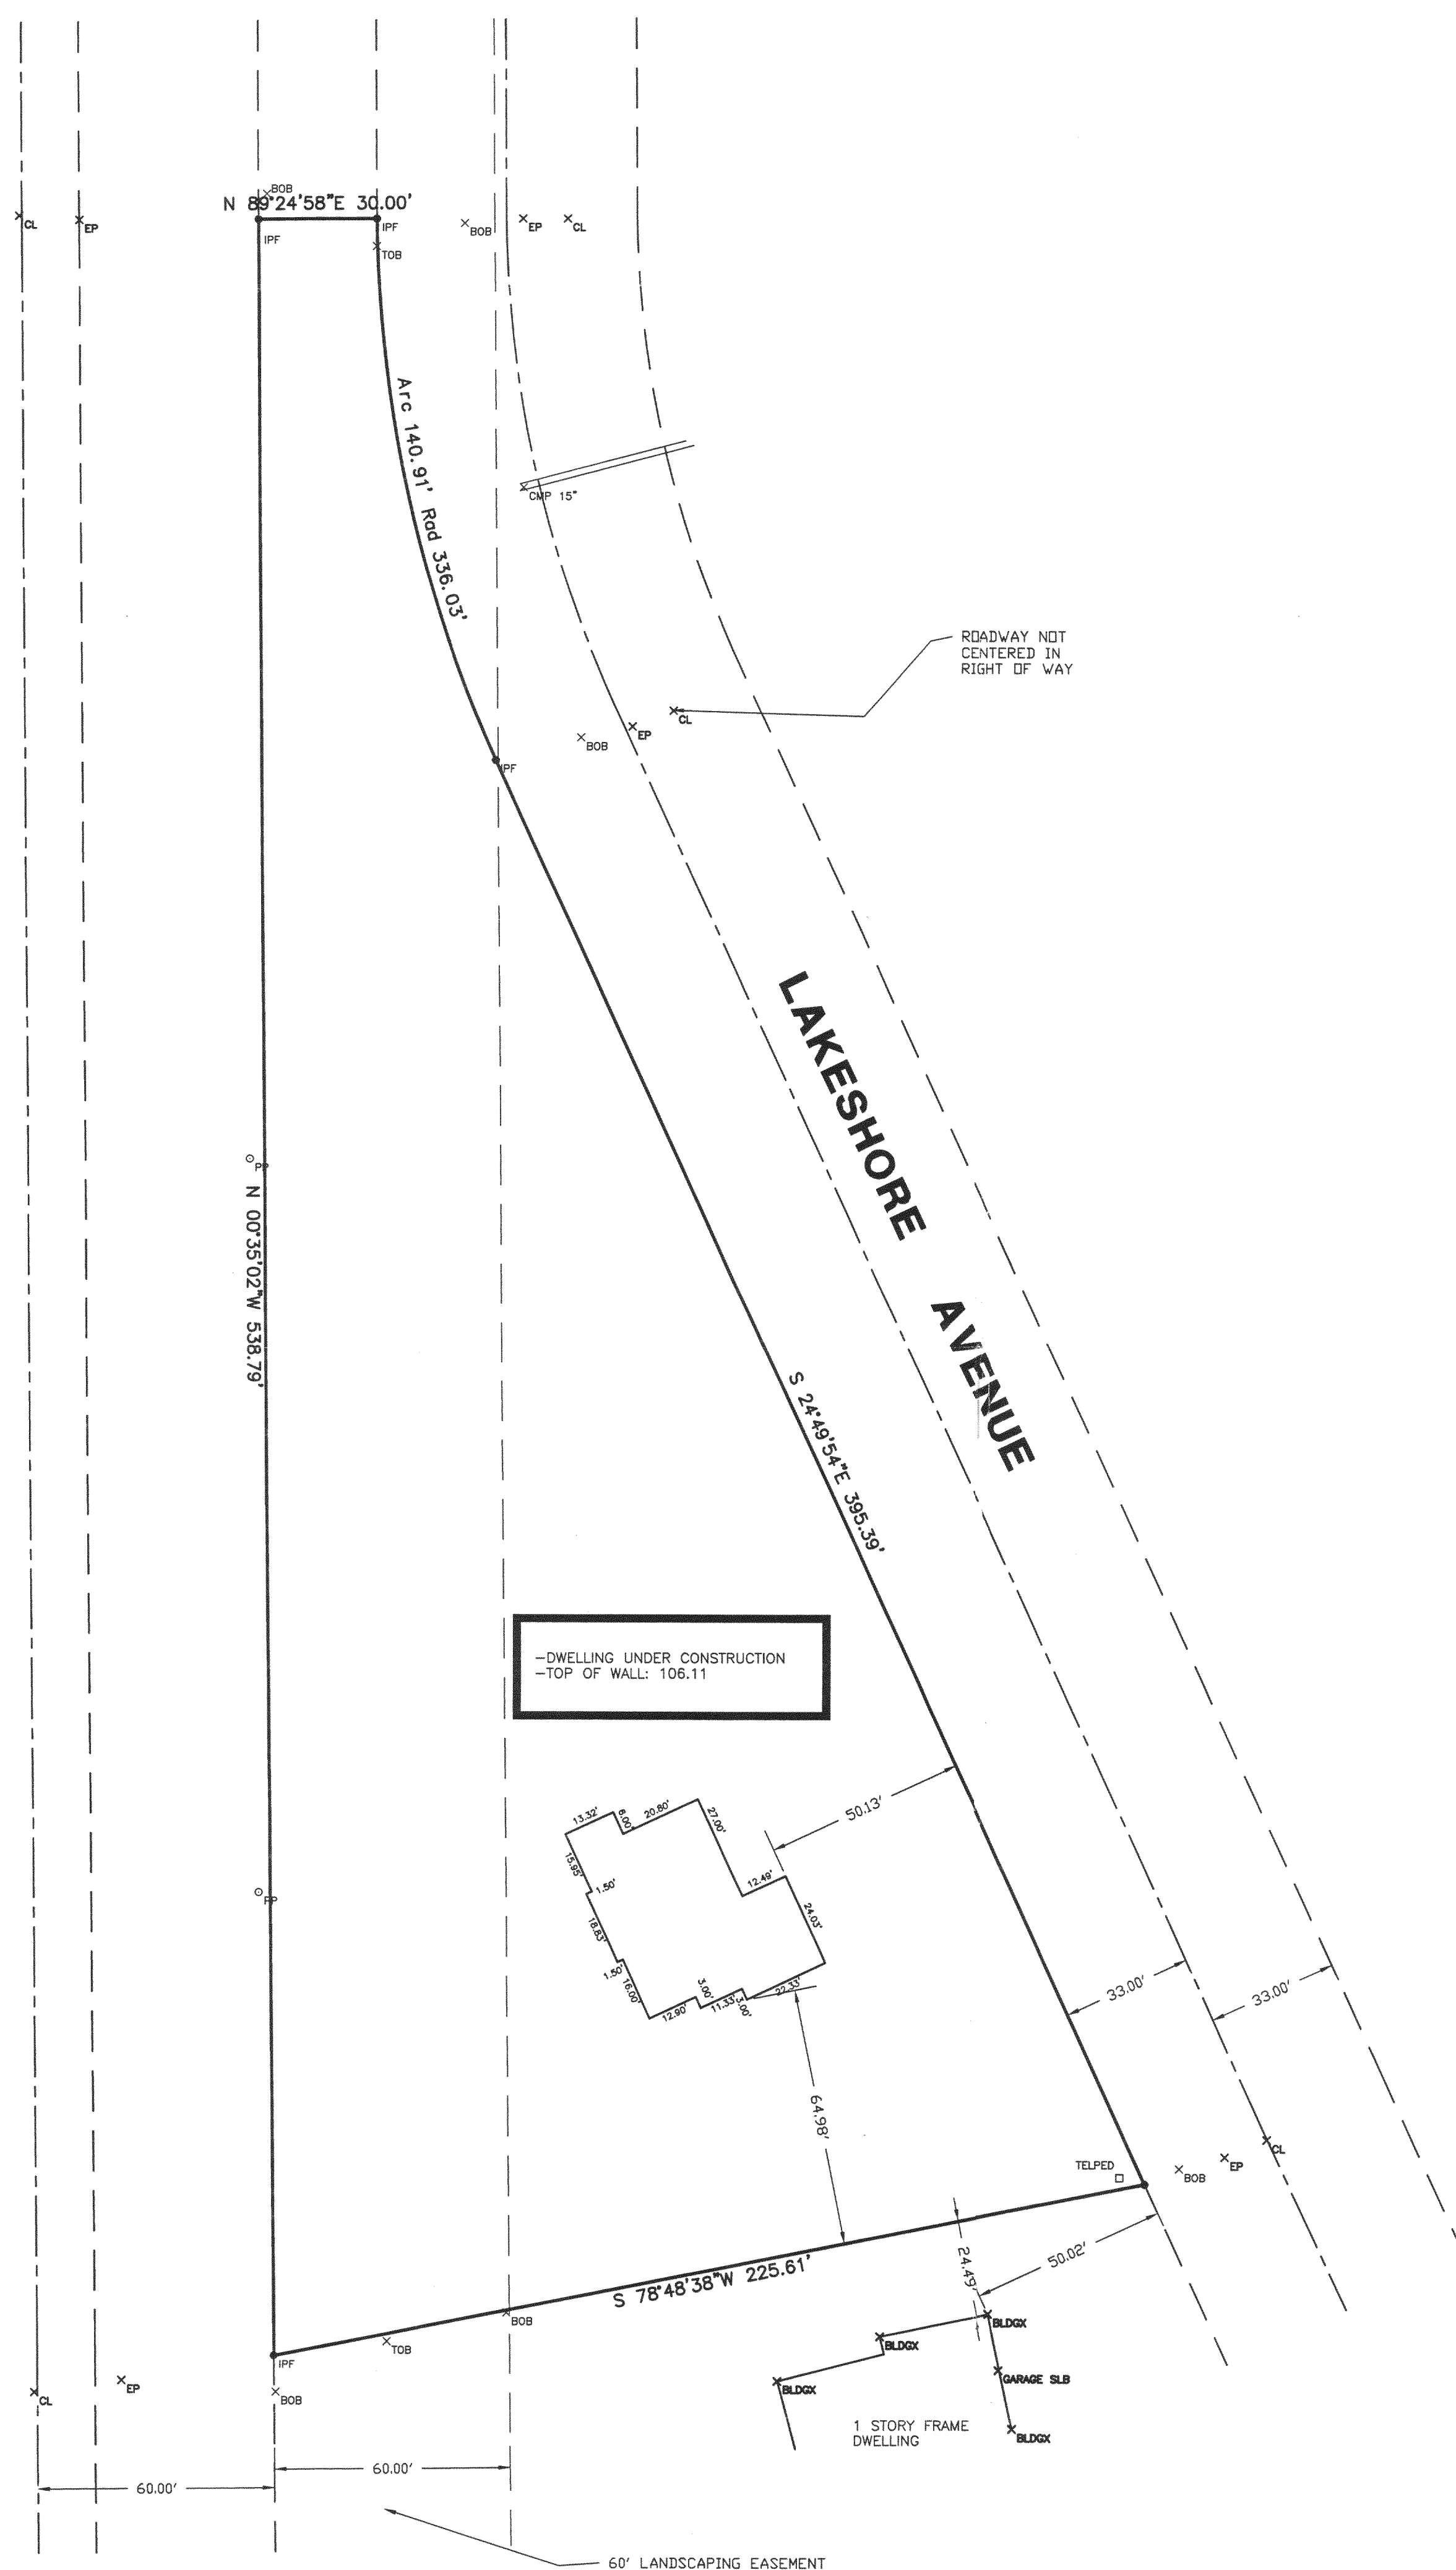


RECEIVED
SEP 25 2000

Sheet 1 of 1

TOWN OF SUGAR CREEK

PROJECT: **PLAT OF SURVEY/STAKE OUT SURVEY**
PREPARED FOR: **PEMBROOKE HOMES, LLC**

DRAWN BY:	PLB	REVISIONS:	DATE
CHECKED BY:	PLB	06/16/00: TURN ON LAYER	
PLOT SCALE: 1 = 30			
DATE: 06/12/2000			
JOB NO.: 2000129			
DWG. FILE: JN200135			

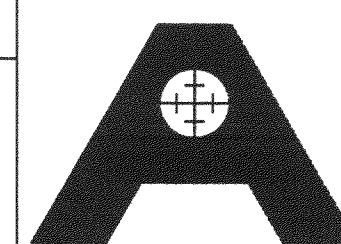

AMERICAN
SURVEYING
COMPANY, INC.

12207 C.T.H. "K" FRANKSVILLE, WISCONSIN 53126
TEL. (262) 835-4774 FAX: (262) 835-2379

644E1-18

316-1219