




# PLAT OF SURVEY

OF

THE SOUTH 1/2 OF LOT 5, LOT 6 AND LOT 7 ALL IN BLOCK 10 INTERLAKEN,  
TOWN OF SUGAR CREEK, WALWORTH COUNTY WISCONSIN.

J.K. SURVEYING  
JEFFREY L. KIMPS R.L.S.  
7561 336TH AVE.  
BURLINGTON WI 53105  
262-537-4274

PREPARED FOR  
RYAN ZENK  
ZENK REALTY, LLC  
ELKHORN WI.

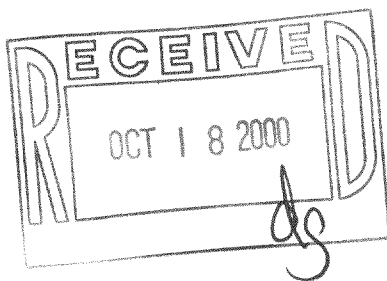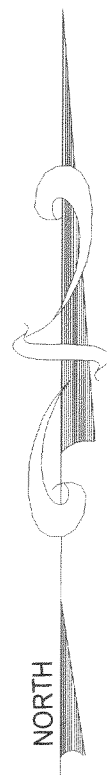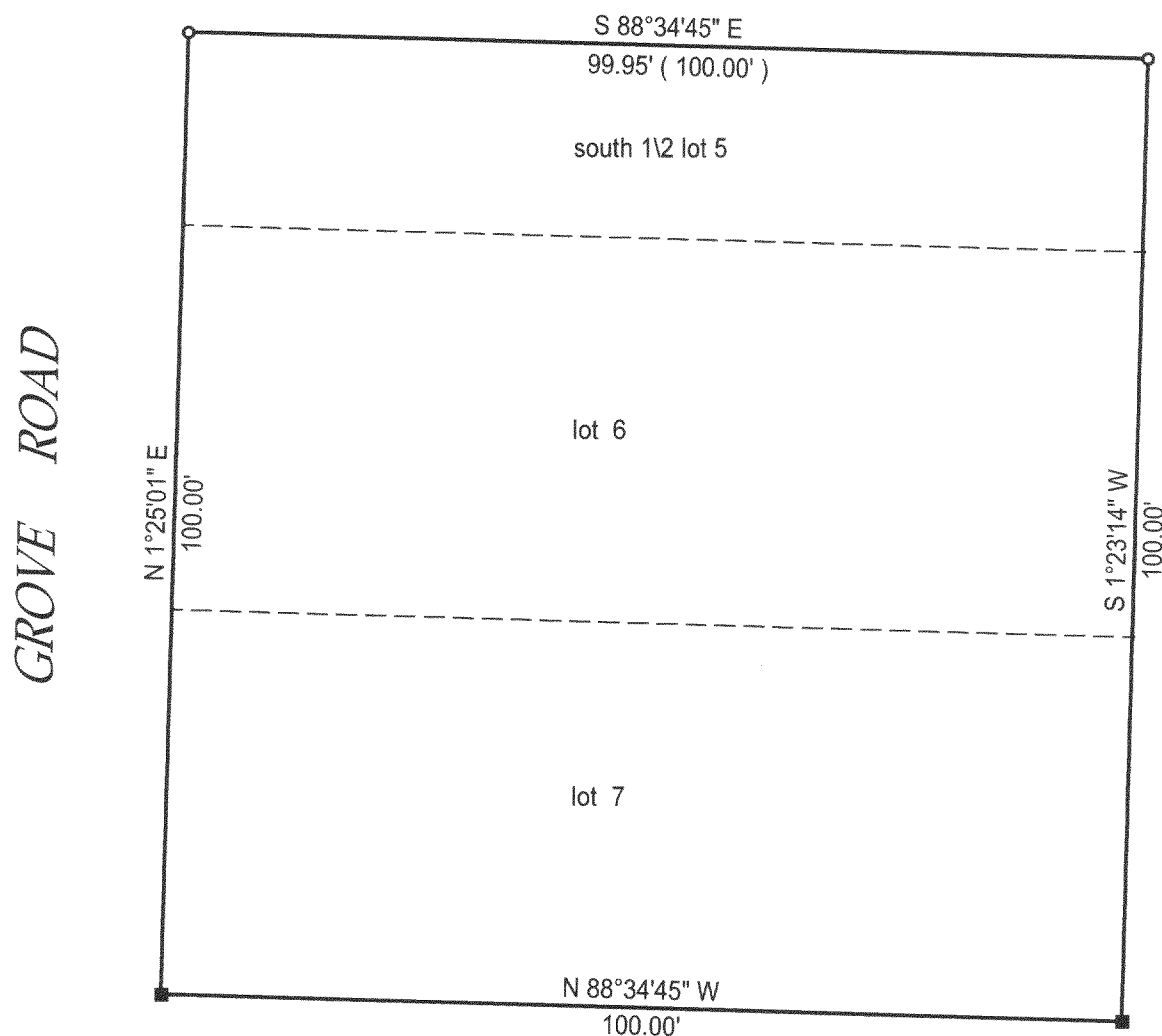

- ( ) = recorded as  
■ = set iron bar  
□ = found iron bar  
○ = found iron pipe  
● = set iron pipe

COMPARE LEGAL DESCRIPTION ABOVE AND DRAWING WITH DEED. FOR BUILDING RESTRICTIONS AND EASEMENTS NOT SHOWN, REFER TO DEED, ABSTRACT SOURCES AND LOCAL MUNICIPAL CODES. NOTIFY THE SURVEYOR IMMEDIATELY OF ANY DISCREPANCY.

"I hereby certify that I have surveyed the above described property and that the above map is a true representation thereof and shows the size and location of all visible structures, apparent easements and encroachments if any."

This survey is made for the present owners of the property, and those who purchase, mortgage, or guarantee the title thereto, within one year from the date hereof.



JOB# 00-00-325

SCALE: 1"=20'

TAX KEY #

DATED THIS 10 TH DAY OF AUGUST 20 00

JEFFREY L. KIMPS S-2436-008

67-94

316-1221