

PLAT OF SURVEY



OF

THE NORTH 20.00 FEET OF LOT 17, LOT 18 AND LOT 19, BLOCK 2 INTERLAKEN'  
TOWN OF SUGAR CREEK, WALWORTH COUNTY, WISCONSIN.

J.K. SURVEYING  
JEFFREY L. KIMPS R.L.S.  
7561 336TH AVE.  
BURLINGTON WI 53105  
414-537-4274

PREPARED FOR : RJ AMANN BUILDERS LLC  
PO BOX 643  
LAKE GENEVA , WI. 53147

ASPEN ROAD

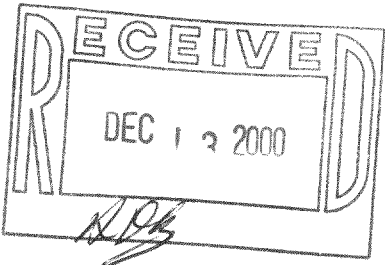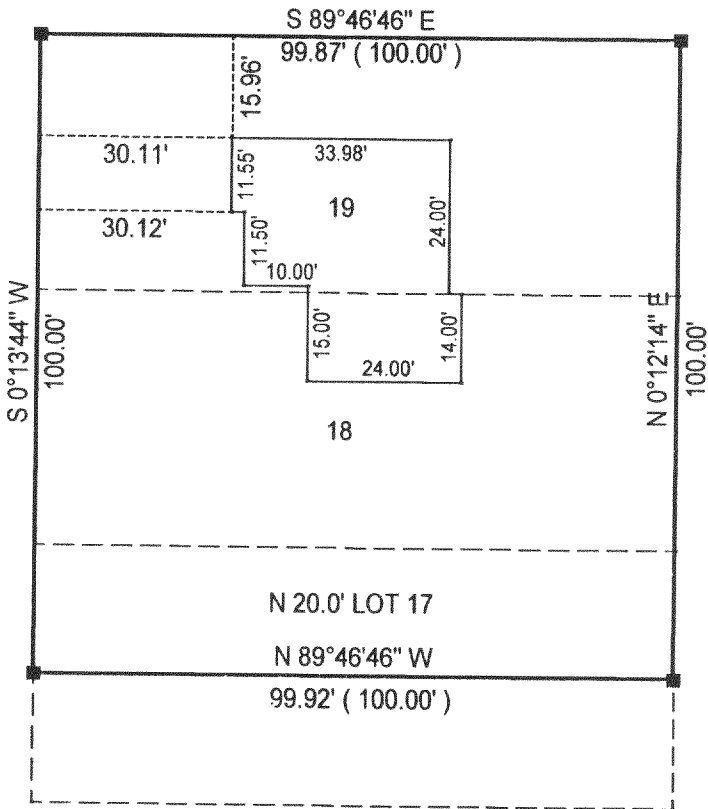

FOUNDATION AS BUILT 9-27-2000 J.L.K.

- ( ) = recorded as
- = set iron bar
- = found iron bar
- = found iron pipe
- = set iron pipe


JOB# 00-232D  
SCALE: 1"=30'

TAX KEY #

COMPARE LEGAL DESCRIPTION ABOVE AND DRAWING WITH DEED. FOR BUILDING RESTRICTIONS AND EASEMENTS NOT SHOWN, REFER TO DEED, ABSTRACT SOURCES AND LOCAL MUNICIPAL CODES. NOTIFY THE SURVEYOR IMMEDIATELY OF ANY DISCREPANCY.

"I hereby certify that I have surveyed the above described property and that the above map is a true representation thereof and shows the size and location of all visible structures, apparent easements and encroachments if any."

This survey is made for the present owners of the property, and those who purchase, mortgage, or guarantee the title thereto, within one year from the date hereof.

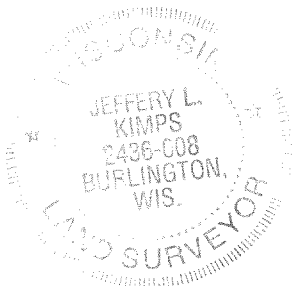

DATED THIS 1 TH DAY OF JUNE 20 00

JEFFREY L. KIMPS S-2436-008