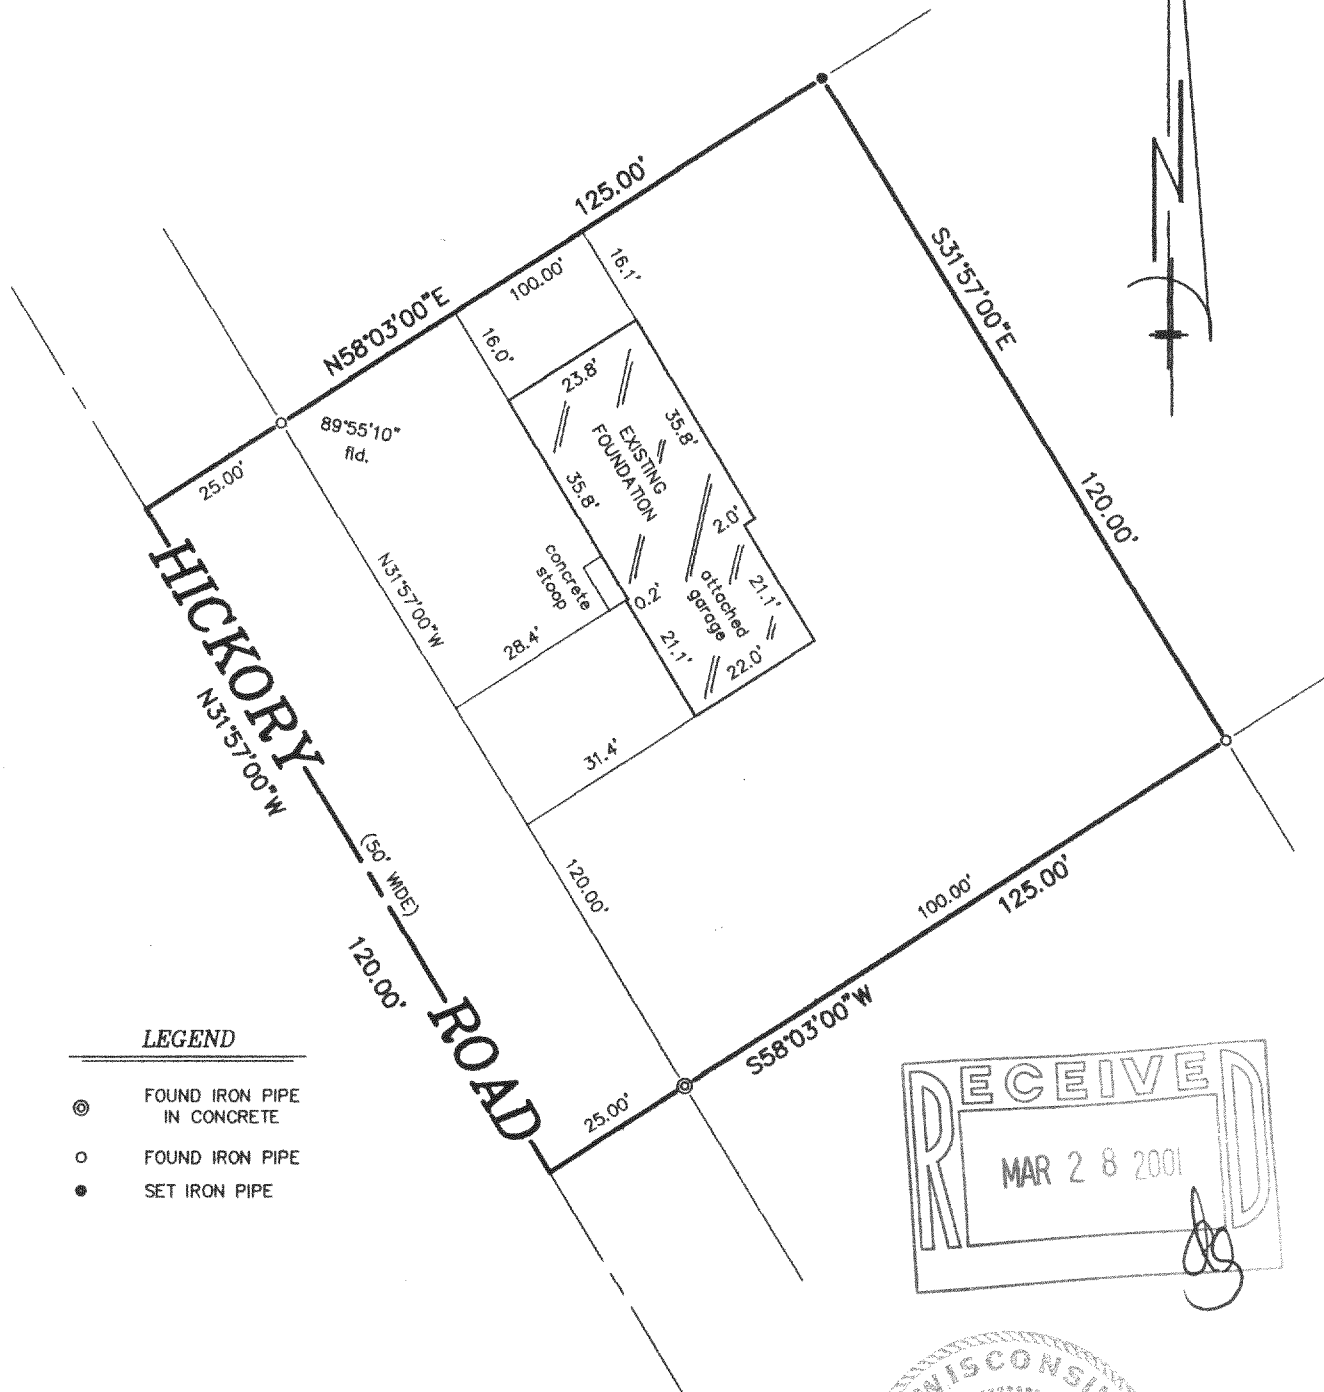




-OF-

SURVEY FOR: SOUTHEASTERN WISCONSIN HOUSING CORPORATION

$$1'' = 30'$$


☒ FOUND IRON PIPE
IN CONCRETE
☐ FOUND IRON PIPE
☐ SET IRON PIPE


"This survey is made for the use of the present owners of the property, and those who purchase, mortgage, or guarantee the title thereto within one year from date hereof."

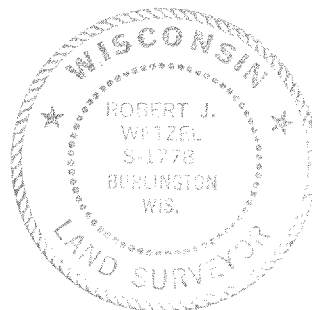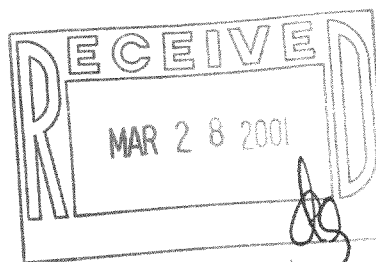

412 N. PINE STREET
BURLINGTON, WI 53105
(262)-767-0225

Robert J. Wetzel
ROBERT J. WETZEL S-1778

4704
JOB NUMBER

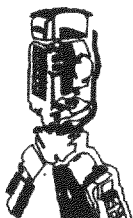

6I-79

316-1272