


PLAT OF SURVEY

OF

LOTS 24, 25, 26 & 27 OF BLOCK 2
NORTH LAKE BEACH, TRACT #3
LOCATED IN THE SE $\frac{1}{4}$ OF SECTION
5, AND THE NE $\frac{1}{4}$ OF SECTION 8,
T3N, R16E, WALWORTH COUNTY,
WISCONSIN.

BLK 6 CORNERS
BLK 2

HIGHLAND WAY 30' WIDE

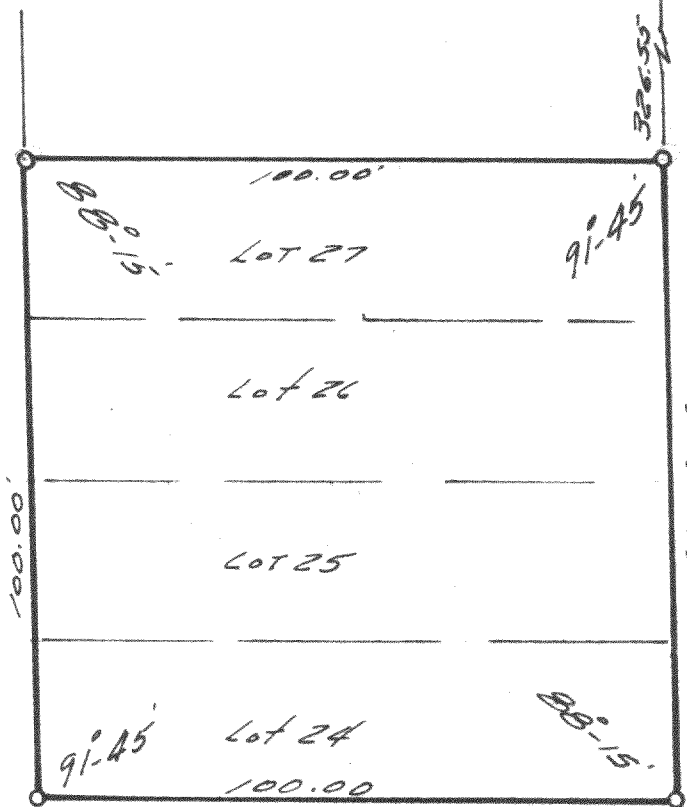

BARKERS DRIVE
33' WIDE

II

SECTION LINE AS PLATTED

RECORD
88-15

SE CORNER OF
SECTION 5, T3N
R16E


SW CORNER
OF BLOCK 6

LEGEND

- — Iron Pipe SET
- — Concrete Monument

Scale 1" = 30

⊗ — IRON PIPE FOUND

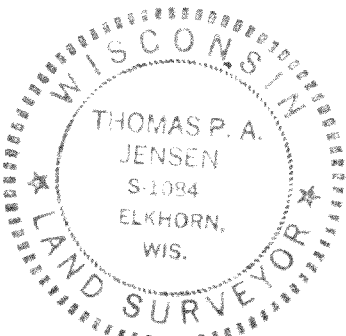

SURVEY AND PLAT BY

JENSEN & JOHNSON, INC.
CIVIL ENGINEERS AND SURVEYORS

Elkhorn, Wisconsin

WE CERTIFY: That we have surveyed the above described property and that the plat shown hereon is an accurate survey and a true representation thereof and correctly shows the exterior boundary lines and all divisions of said property.

Date Nov. 6, 1973

Thomas P. A. Jensen

~~THOMAS P. A. JENSEN~~

Wisconsin Registered Land Surveyor, No. S-22

GNL B3-350