
PLAT OF SURVEY

LOT 88, BAYWOOD ESTATES 3RD ADDITION, located in the Northeast 1/4 of the Northwest 1/4 of Section 1, Town 3 North, Range 16 East Walworth County, Wisconsin

Surveyed for: Bielinski Bros. Builders Inc./Matthew and Carol Pugens

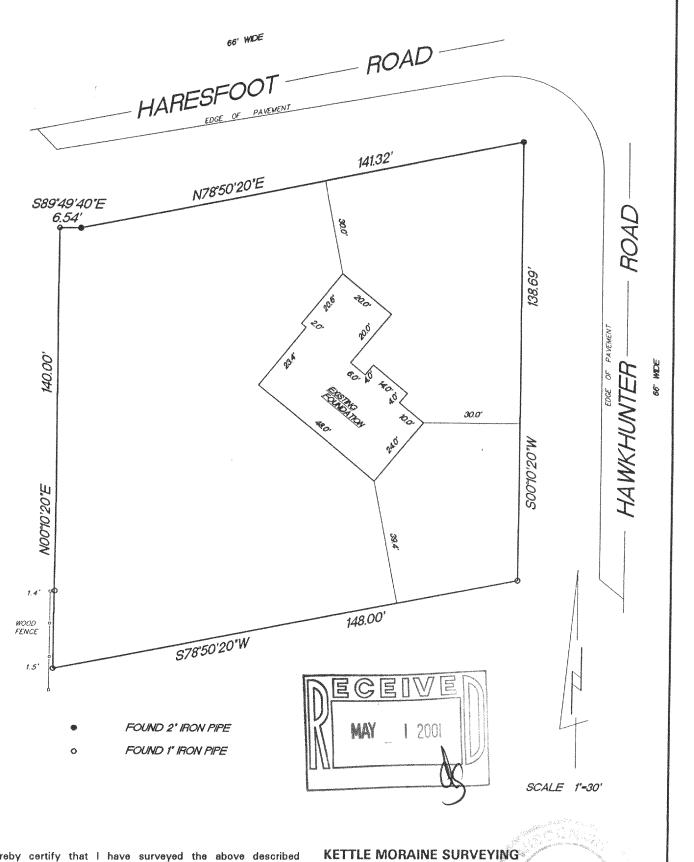

"I hereby certify that I have surveyed the above described property and that the above map is a true representation thereof and shows the size and location of the property, its exterior boundaries, the location of all visible structures and dimension of all principal buildings thereon, boundary fences, apparent easements, roadways and encroachments if any."

"This survey is made for the use of the present owners of the property, and also those who purchase, mortgage or guarantee the title thereto within one year from date hereof."

REV. 3/8/01 1/18/01

FIELD WORK BY

W356 \$9050 Godfrey Lane Eagle Wisconsin 53119 P.O. Box 357 (262) 594-3484

Terrance E. Pisarek R.L.S.

DRAWN BY

THIS IS NOT AN ORIGINAL SURVEY UNLESS THE SEAL IS RED.

JOB NUMBER

00322

316-1290