
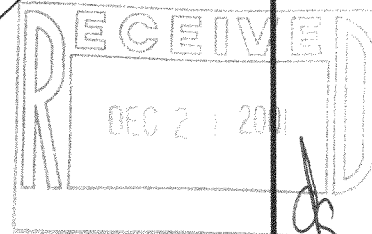


ABELL  
SURVEYING & MAPPING

1140 SEQUOIA STREET • DELAVAN, WISCONSIN 53115  
262-728-6737

NORTHEAST CORNER  
BLOCK 104

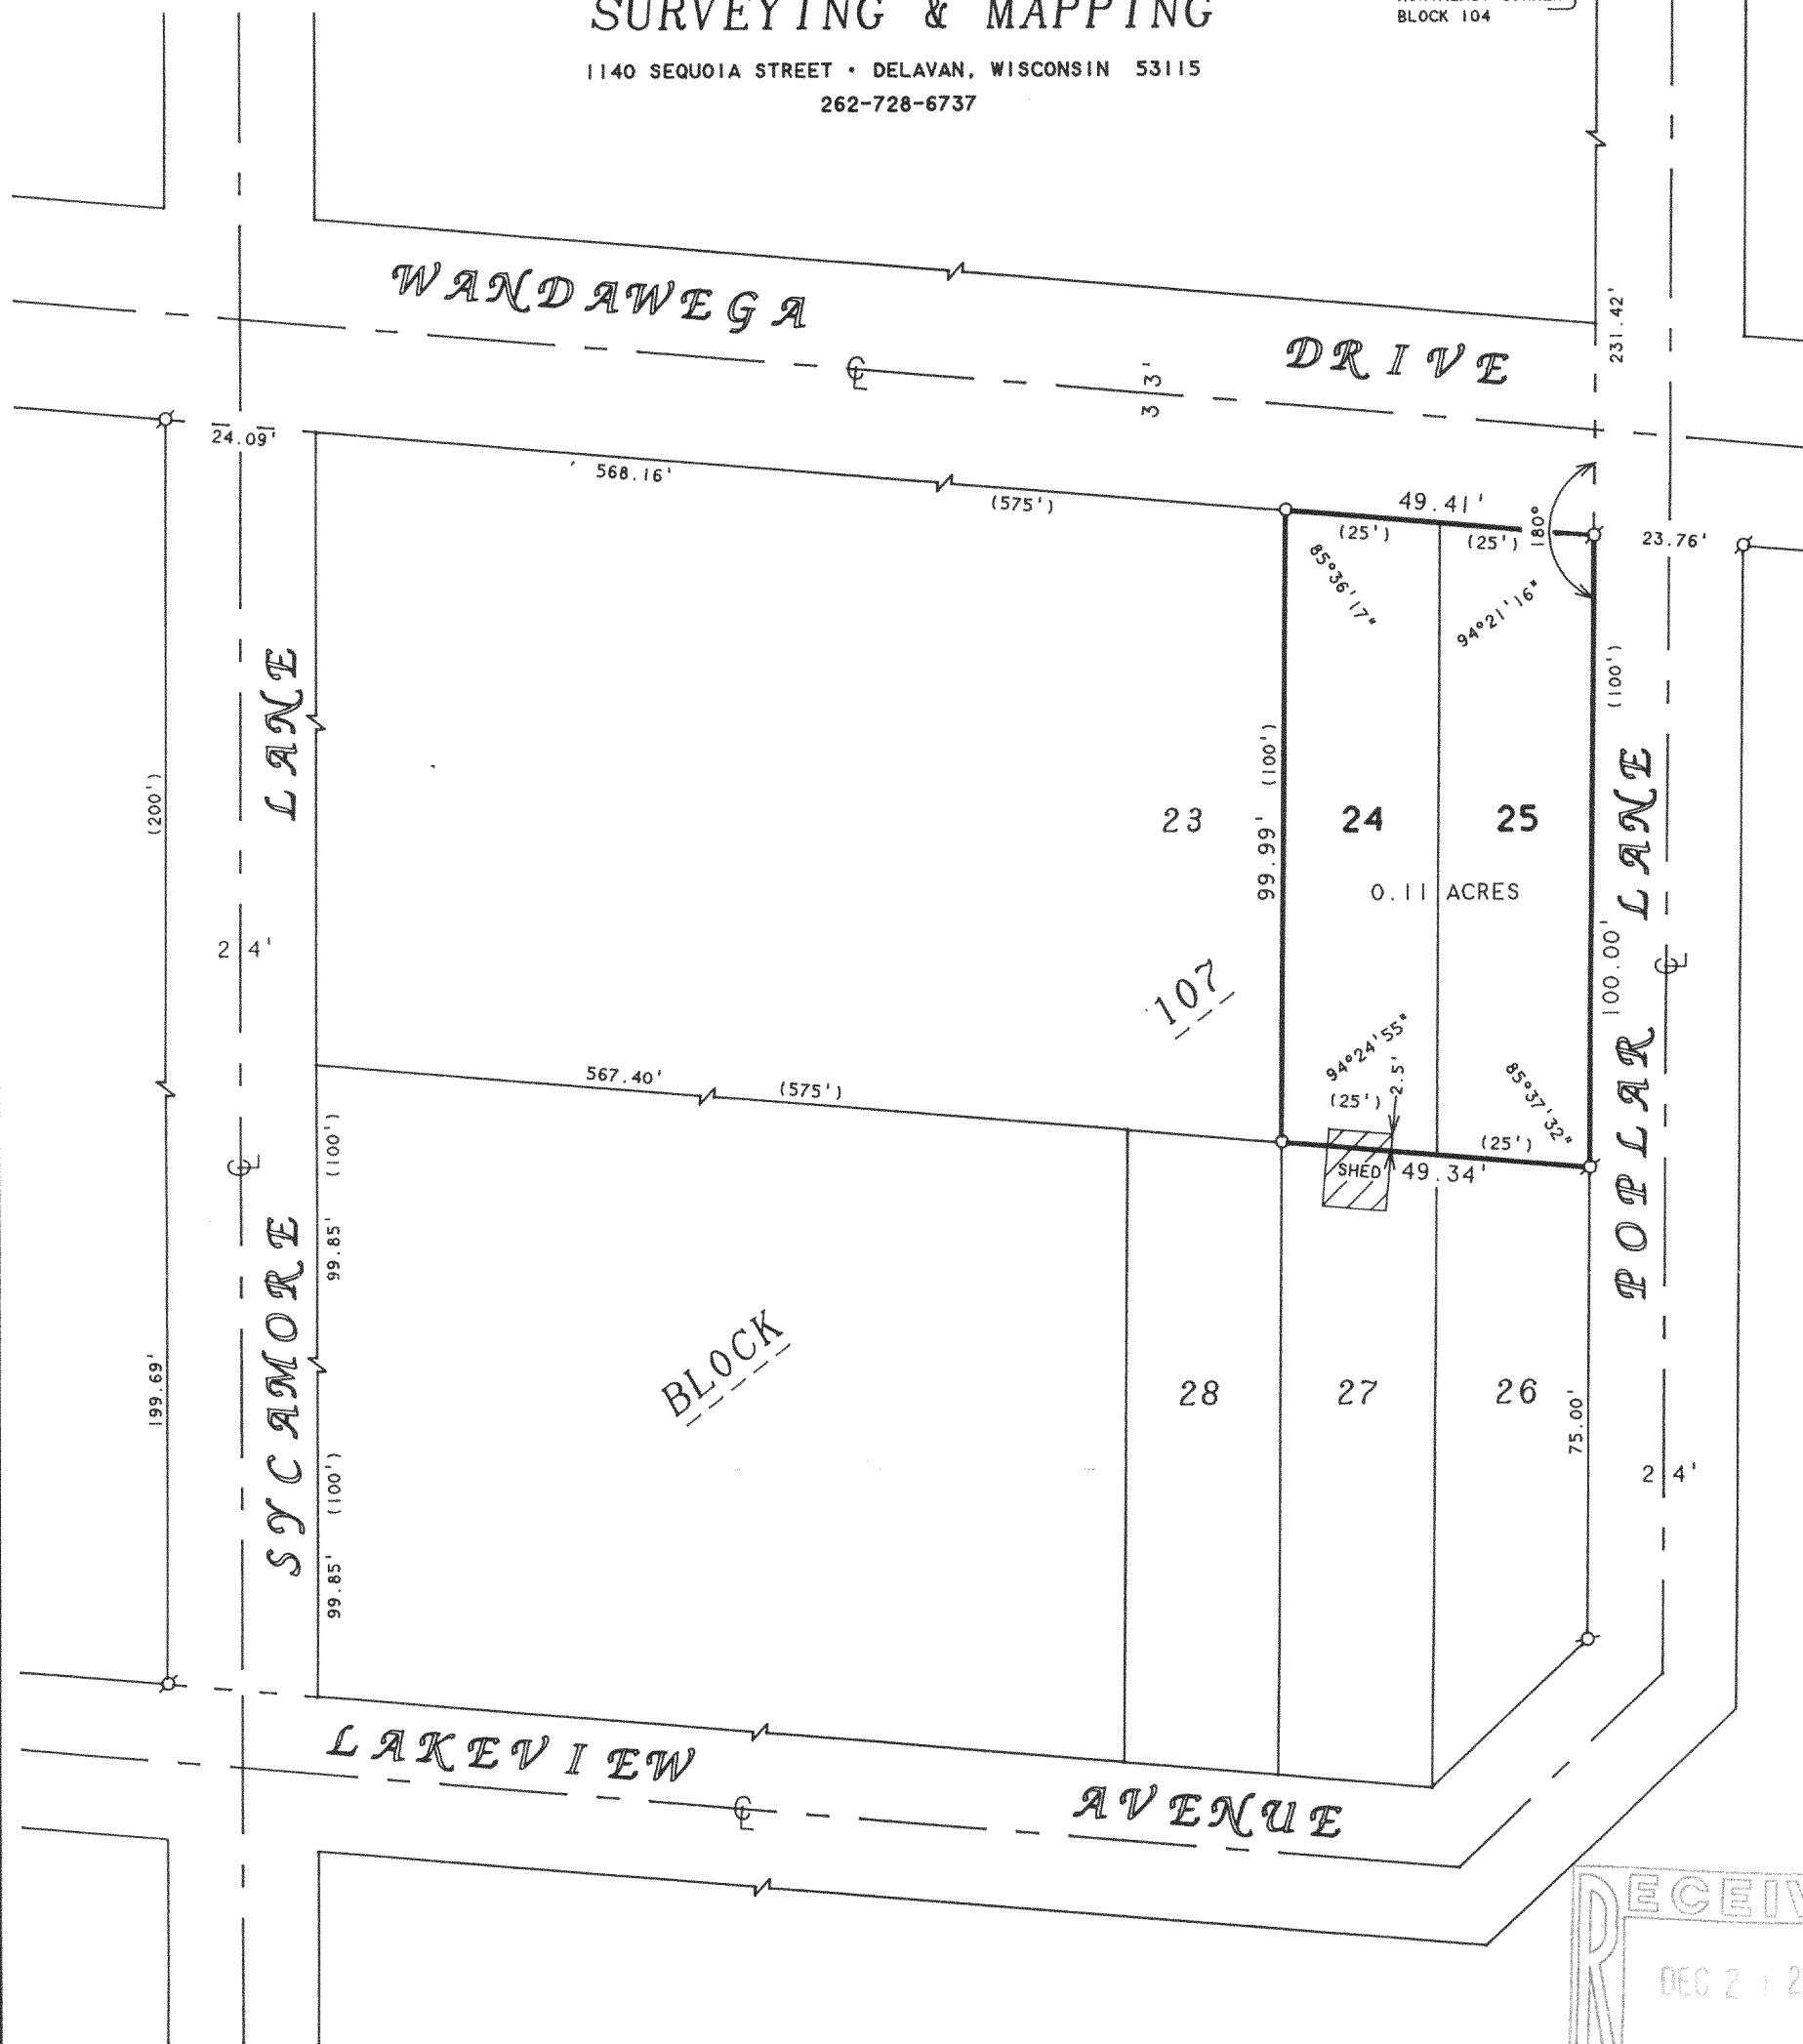

**PLAT OF SURVEY OF**

LOTS 24-25, BLOCK 107, LAKE WANDAEWA SUBDIVISION,  
LOCATED IN T3N, R16E, WALWORTH COUNTY, WISCONSIN.

ORDERED BY: BETH JOHNSON  
W5404 LAKEVIEW DRIVE  
ELKHORN, WI 53121

I, DAVID F. ABELL, DO HEREBY CERTIFY THAT I HAVE SURVEYED THE PROPERTY HEREON  
DESCRIBED ACCORDING TO THE OFFICIAL RECORDS AND THAT THE PLAT HEREON IS A  
CORRECT REPRESENTATION OF THE PROPERTY LINES TO THE BEST OF MY KNOWLEDGE AND  
BELIEF.

*David F. Abell*

DAVID F. ABELL  
WISCONSIN REGISTERED LAND SURVEYOR, S-1596

*July 26, 2001*

DATE: July 26, 2001 JOB NUMBER - 00044A  
NOTE: THIS IS NOT A CERTIFIED COPY UNLESS SEALED.

N



SCALE 1"=30'

**LEGEND**

- Ø - IRON PIPE FOUND
- - 1" DIA. IRON PIPE SET
- ( ) - RECORDED AS

GLW-2901

316-1339