

# PLAT OF SURVEY

- OF -


J.K. SURVEYING INC.  
N3705 WILLOWBEND LANE  
LAKE GENEVA, WI, 53147  
262-248-3697

PARCEL "A"

LOTS 1, 2 AND THE SOUTH 1/2 OF LOT 5 BLOCK 62 INTERLAKEN, A  
SUBDIVISION LOCATED IN, TOWN 3 NORTH, RANGE 16 EAST, TOWN  
OF SUGAR CREEK, WALWORTH COUNTY, WISCONSIN.  
SAID PARCEL CONTAINS. 12503 SQUARE FEET

### PARCEL "B"

LOTS 6,7 AND THE NORTH 1/2 OF LOT 5 BLOCK 62 INTERLAKEN, A  
SUBDIVISION LOCATED IN, TOWN 3 NORTH, RANGE 16 EAST, TOWN  
OF SUGWR CREEK, WALWORTH COUNTY, WISCONSIN.  
SAID PARCEL CONTAINS 18117 SQUARE FEET

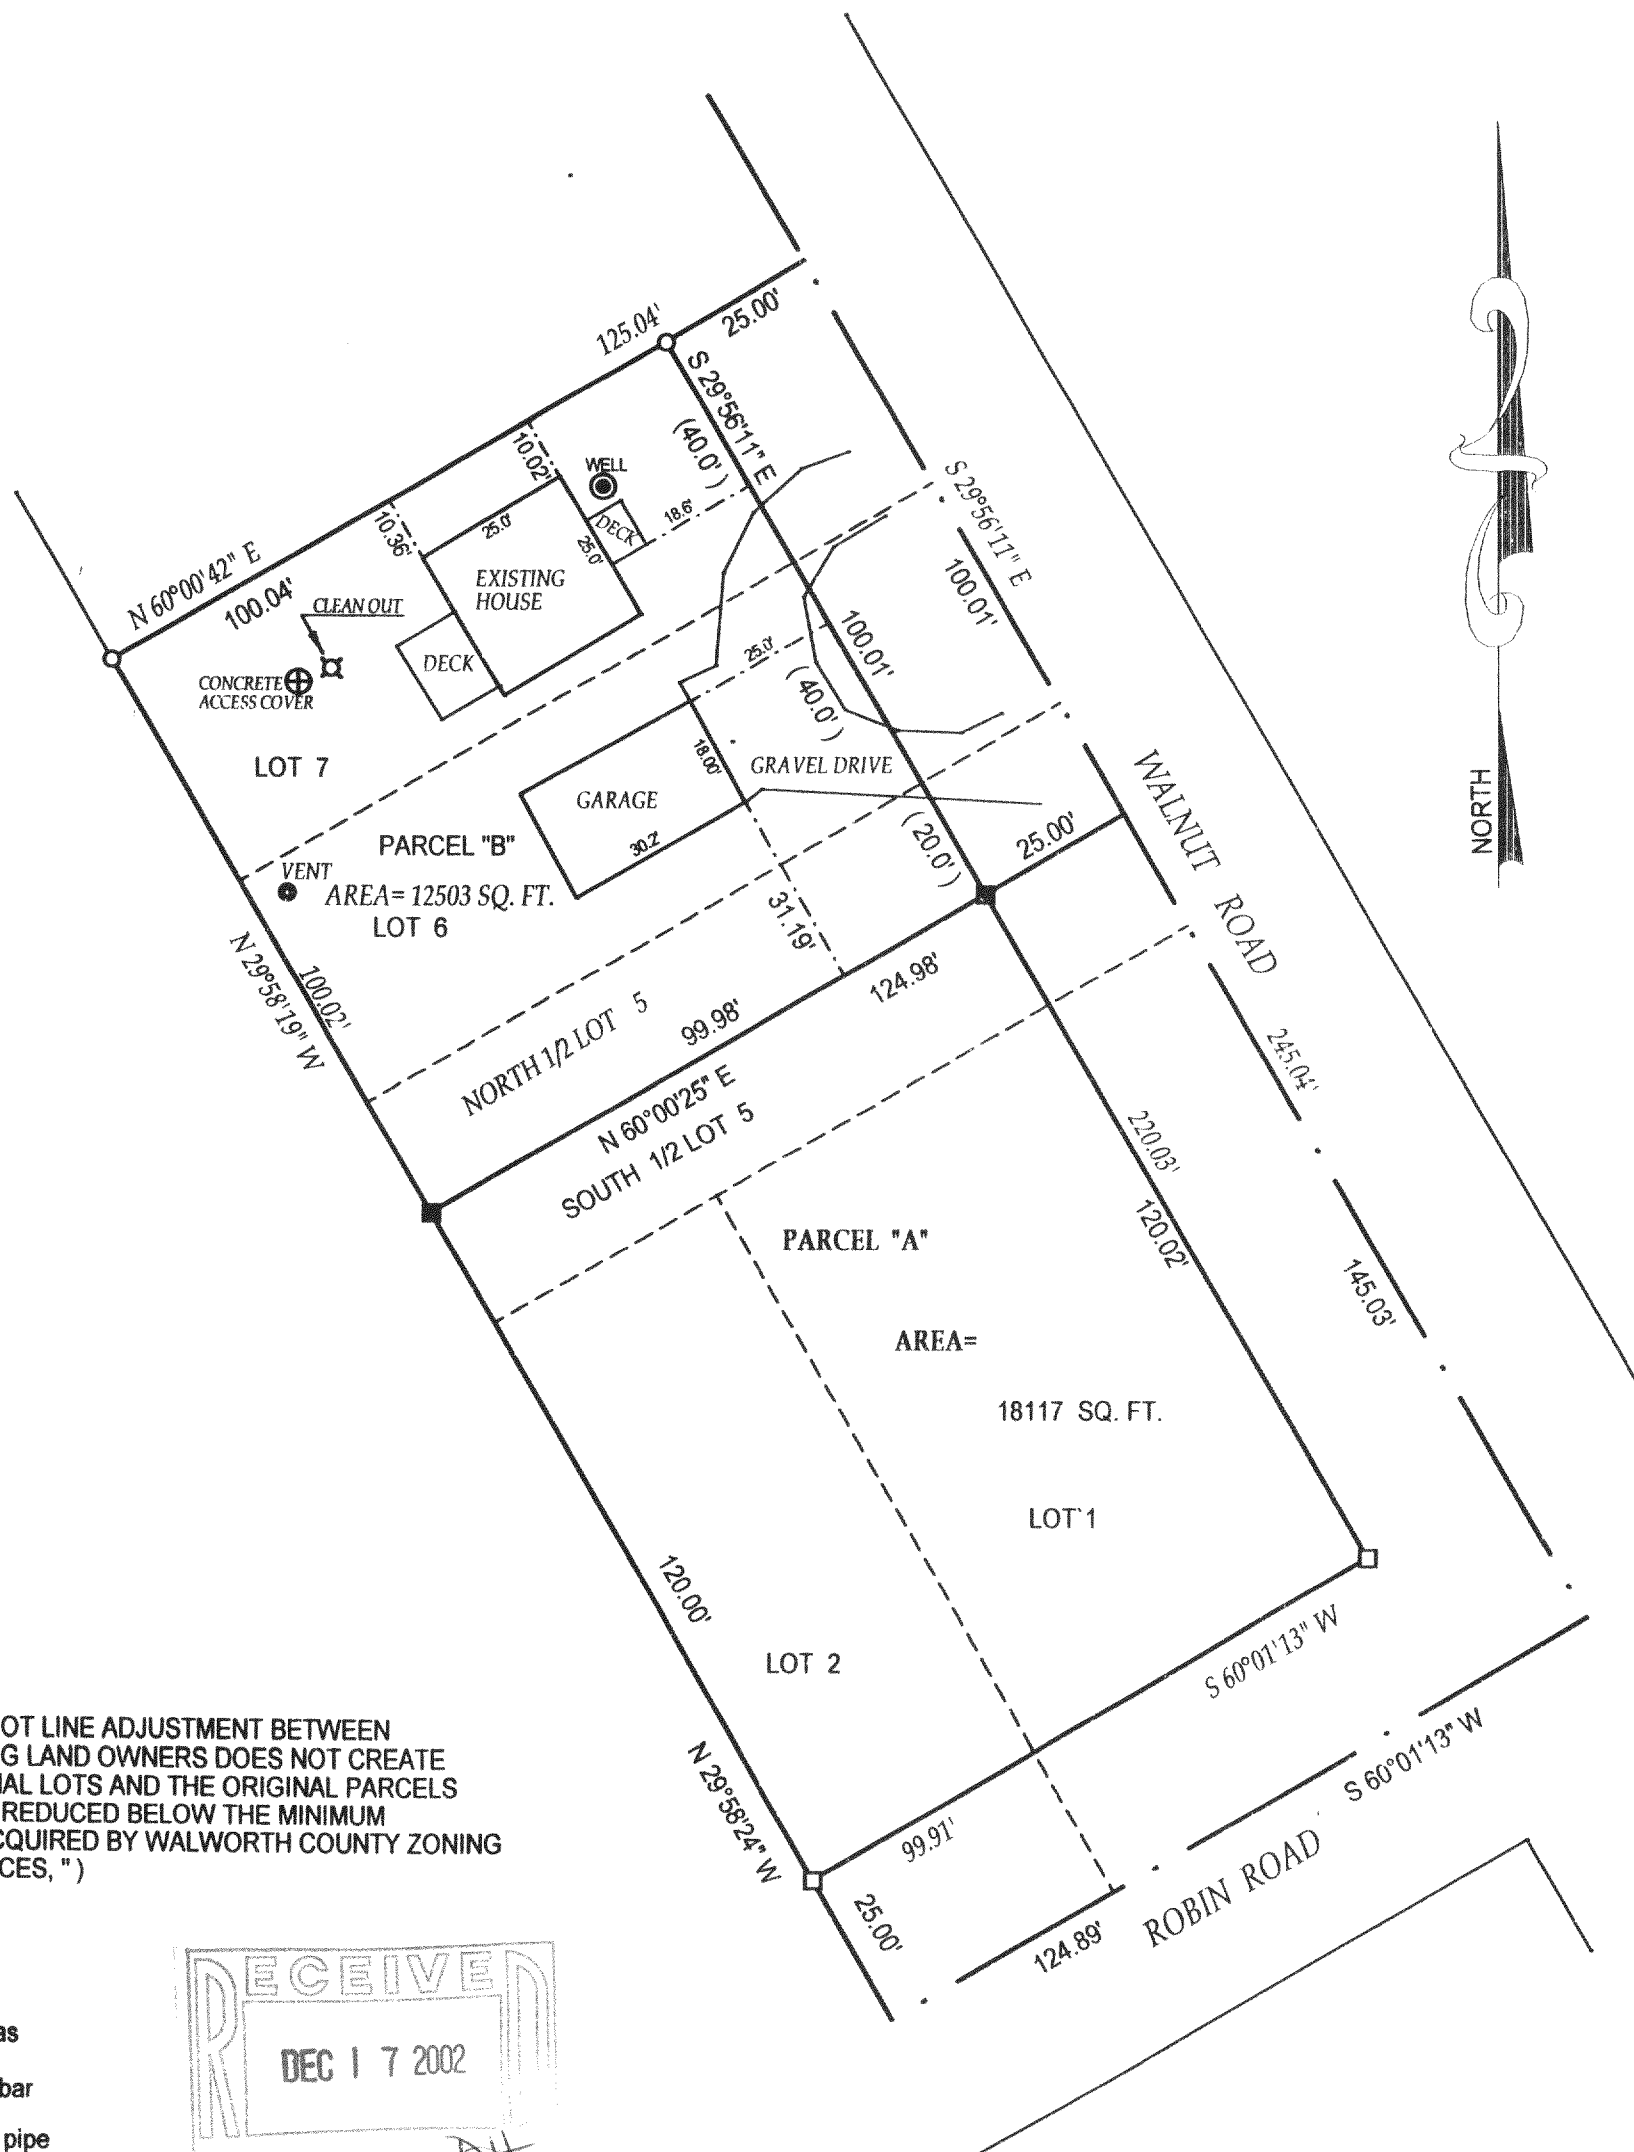

( " THIS LOT LINE ADJUSTMENT BETWEEN ADJOINING LAND OWNERS DOES NOT CREATE ADDITIONAL LOTS AND THE ORIGINAL PARCELS ARE NOT REDUCED BELOW THE MINIMUM SIZE REQUIRED BY WALWORTH COUNTY ZONING ORDINANCES. " )

( ) = recorded as

☐ = found iron bar

○ = found iron pipe


● = set iron pipe

■ = set iron bar

SCALE 1" = 30'

JOB # 02-437

TAX ID # GI-560 &amp; GI-562

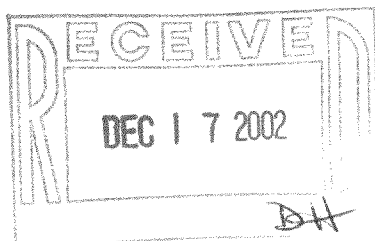

COMPARE LEGAL DESCRIPTION ABOVE AND DRAWING WITH DEED. FOR BUILDING RESTRICTIONS AND EASEMENTS NOT SHOWN, REFER TO DEED, ABSTRACT SOURCES AND LOCAL MUNICIPAL CODES. NOTIFY THE SURVEYOR IMMEDIATELY OF ANY DISCREPANCY.

"I hereby certify that I have surveyed the above described property and that the above map is a true representation thereof and shows the size and location of all visible structures, apparent easements and encroachments if any."

This survey is made for the present owners of the property, and those who purchase, mortgage, or guarantee the title thereto, within one year from the date hereof.

DATED THIS 25 TH, DAY OF SEPTEMBER 20 02

JOHN KROTT S - 2258  
Wisconsin Registered Land Surveyor  
( original if signed in red )

✓ GI-560  
GI-562

316-1438