



PREPARED FOR  
RON AMANN  
R.J. AMANN BUILDERS  
P.O. BOX 643  
LAKE GENEVA, WI  
53147

PLAT OF SURVEY

OF

J.K. SURVEYING INC.  
N3705 WILLOWBEND LANE  
LAKE GENEVA, WI, 53147  
262-248-3697

LOTS 34,35 AND 36, EXCEPT THE SOUTH 20.00 FEET OF LOT 36, BLOCK 2 INTERLAKEN,  
TOWN OF SUGAR CREEK, WALWORTH COUNTY, WISCONSIN.

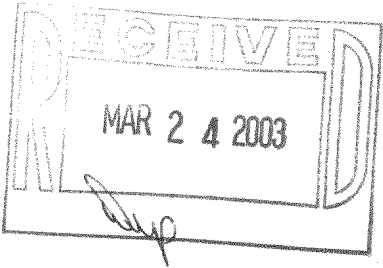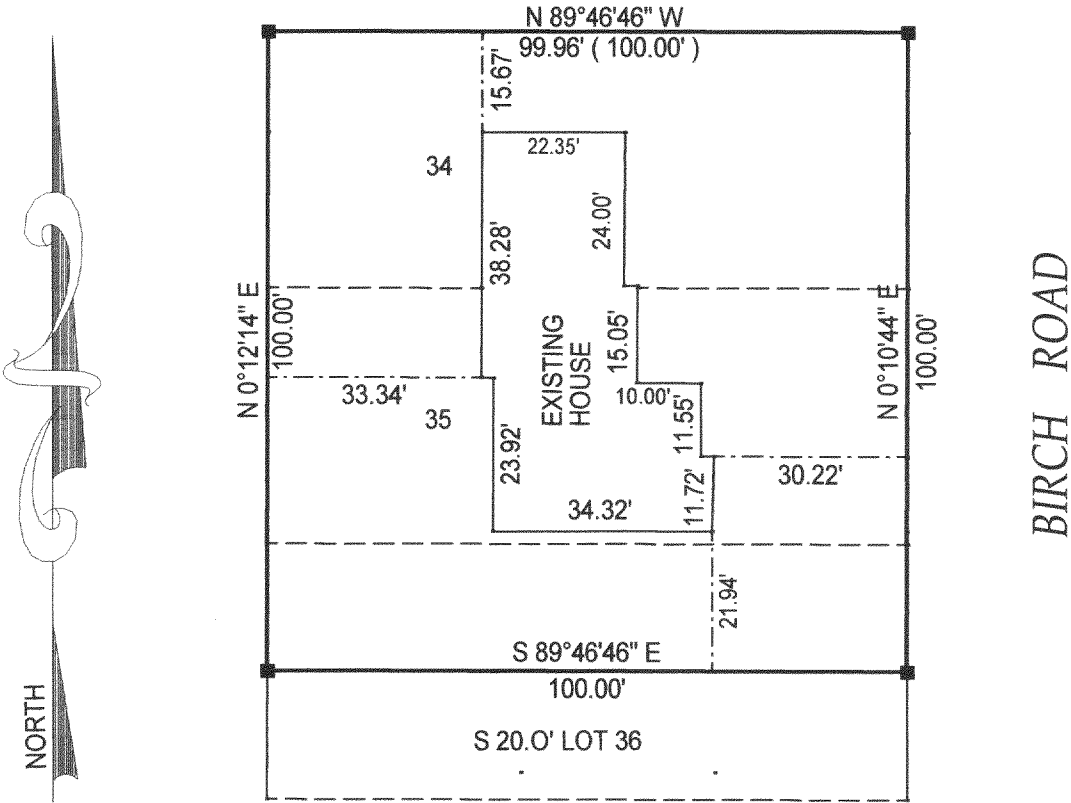

- ( ) = recorded as  
■ = set iron bar  
□ = found iron bar  
○ = found iron pipe  
● = set iron pipe

JOB# 00-232gAB

SCALE: 1"=30'

TAX KEY #

REVISION JULY 11TH, 2001


DATE OF LAST REVISION FEBRUARY 24TH, 2003

COMPARE LEGAL DESCRIPTION ABOVE AND DRAWING WITH DEED. FOR BUILDING RESTRICTIONS AND EASEMENTS NOT SHOWN, REFER TO DEED, ABSTRACT SOURCES AND LOCAL MUNICIPAL CODES. NOTIFY THE SURVEYOR IMMEDIATELY OF ANY DISCREPANCY.

"I hereby certify that I have surveyed the above described property and that the above map is a true representation thereof and shows the size and location of all visible structures, apparent easements and encroachments if any."

This survey is made for the present owners of the property, and those who purchase, mortgage, or guarantee the title thereto, within one year from the date hereof.

DATED THIS 1 TH DAY OF JUNE 20 00

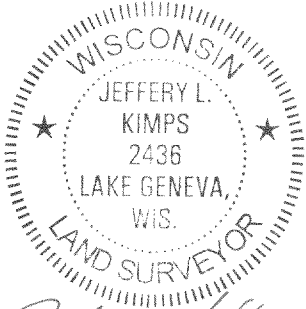

*Jeffery L. Kimps*  
JEFFERY L. KIMPS S - 2436  
Wisconsin Registered Land Surveyor  
( original if signed in red )

GI - 8B

316-1466