


Plat of Survey

of



Lot 18 of Sylvan Trace Subdivision,

located in the Northwest 1/4 of Section 2, Town 3 North, Range 16 East, Town of Sugar Creek, Walworth County, Wisconsin.


Surveyed for: **Scott Christian**
N5461 Briarwood Road
Elkhorn, Wisconsin. 53121

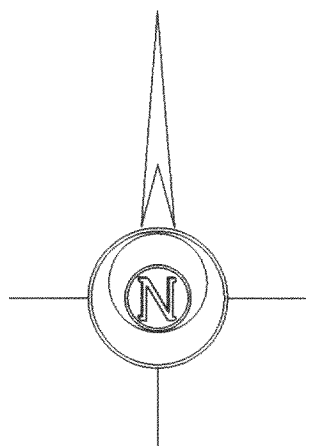

Bearings reference to the plat of
Sylvan Trace Subdivision.

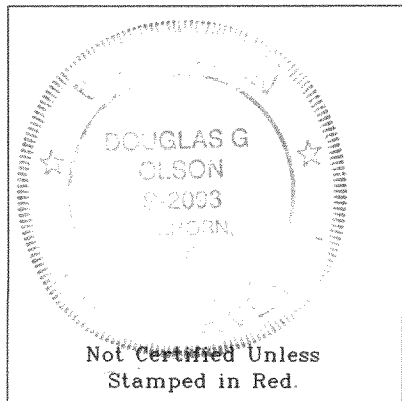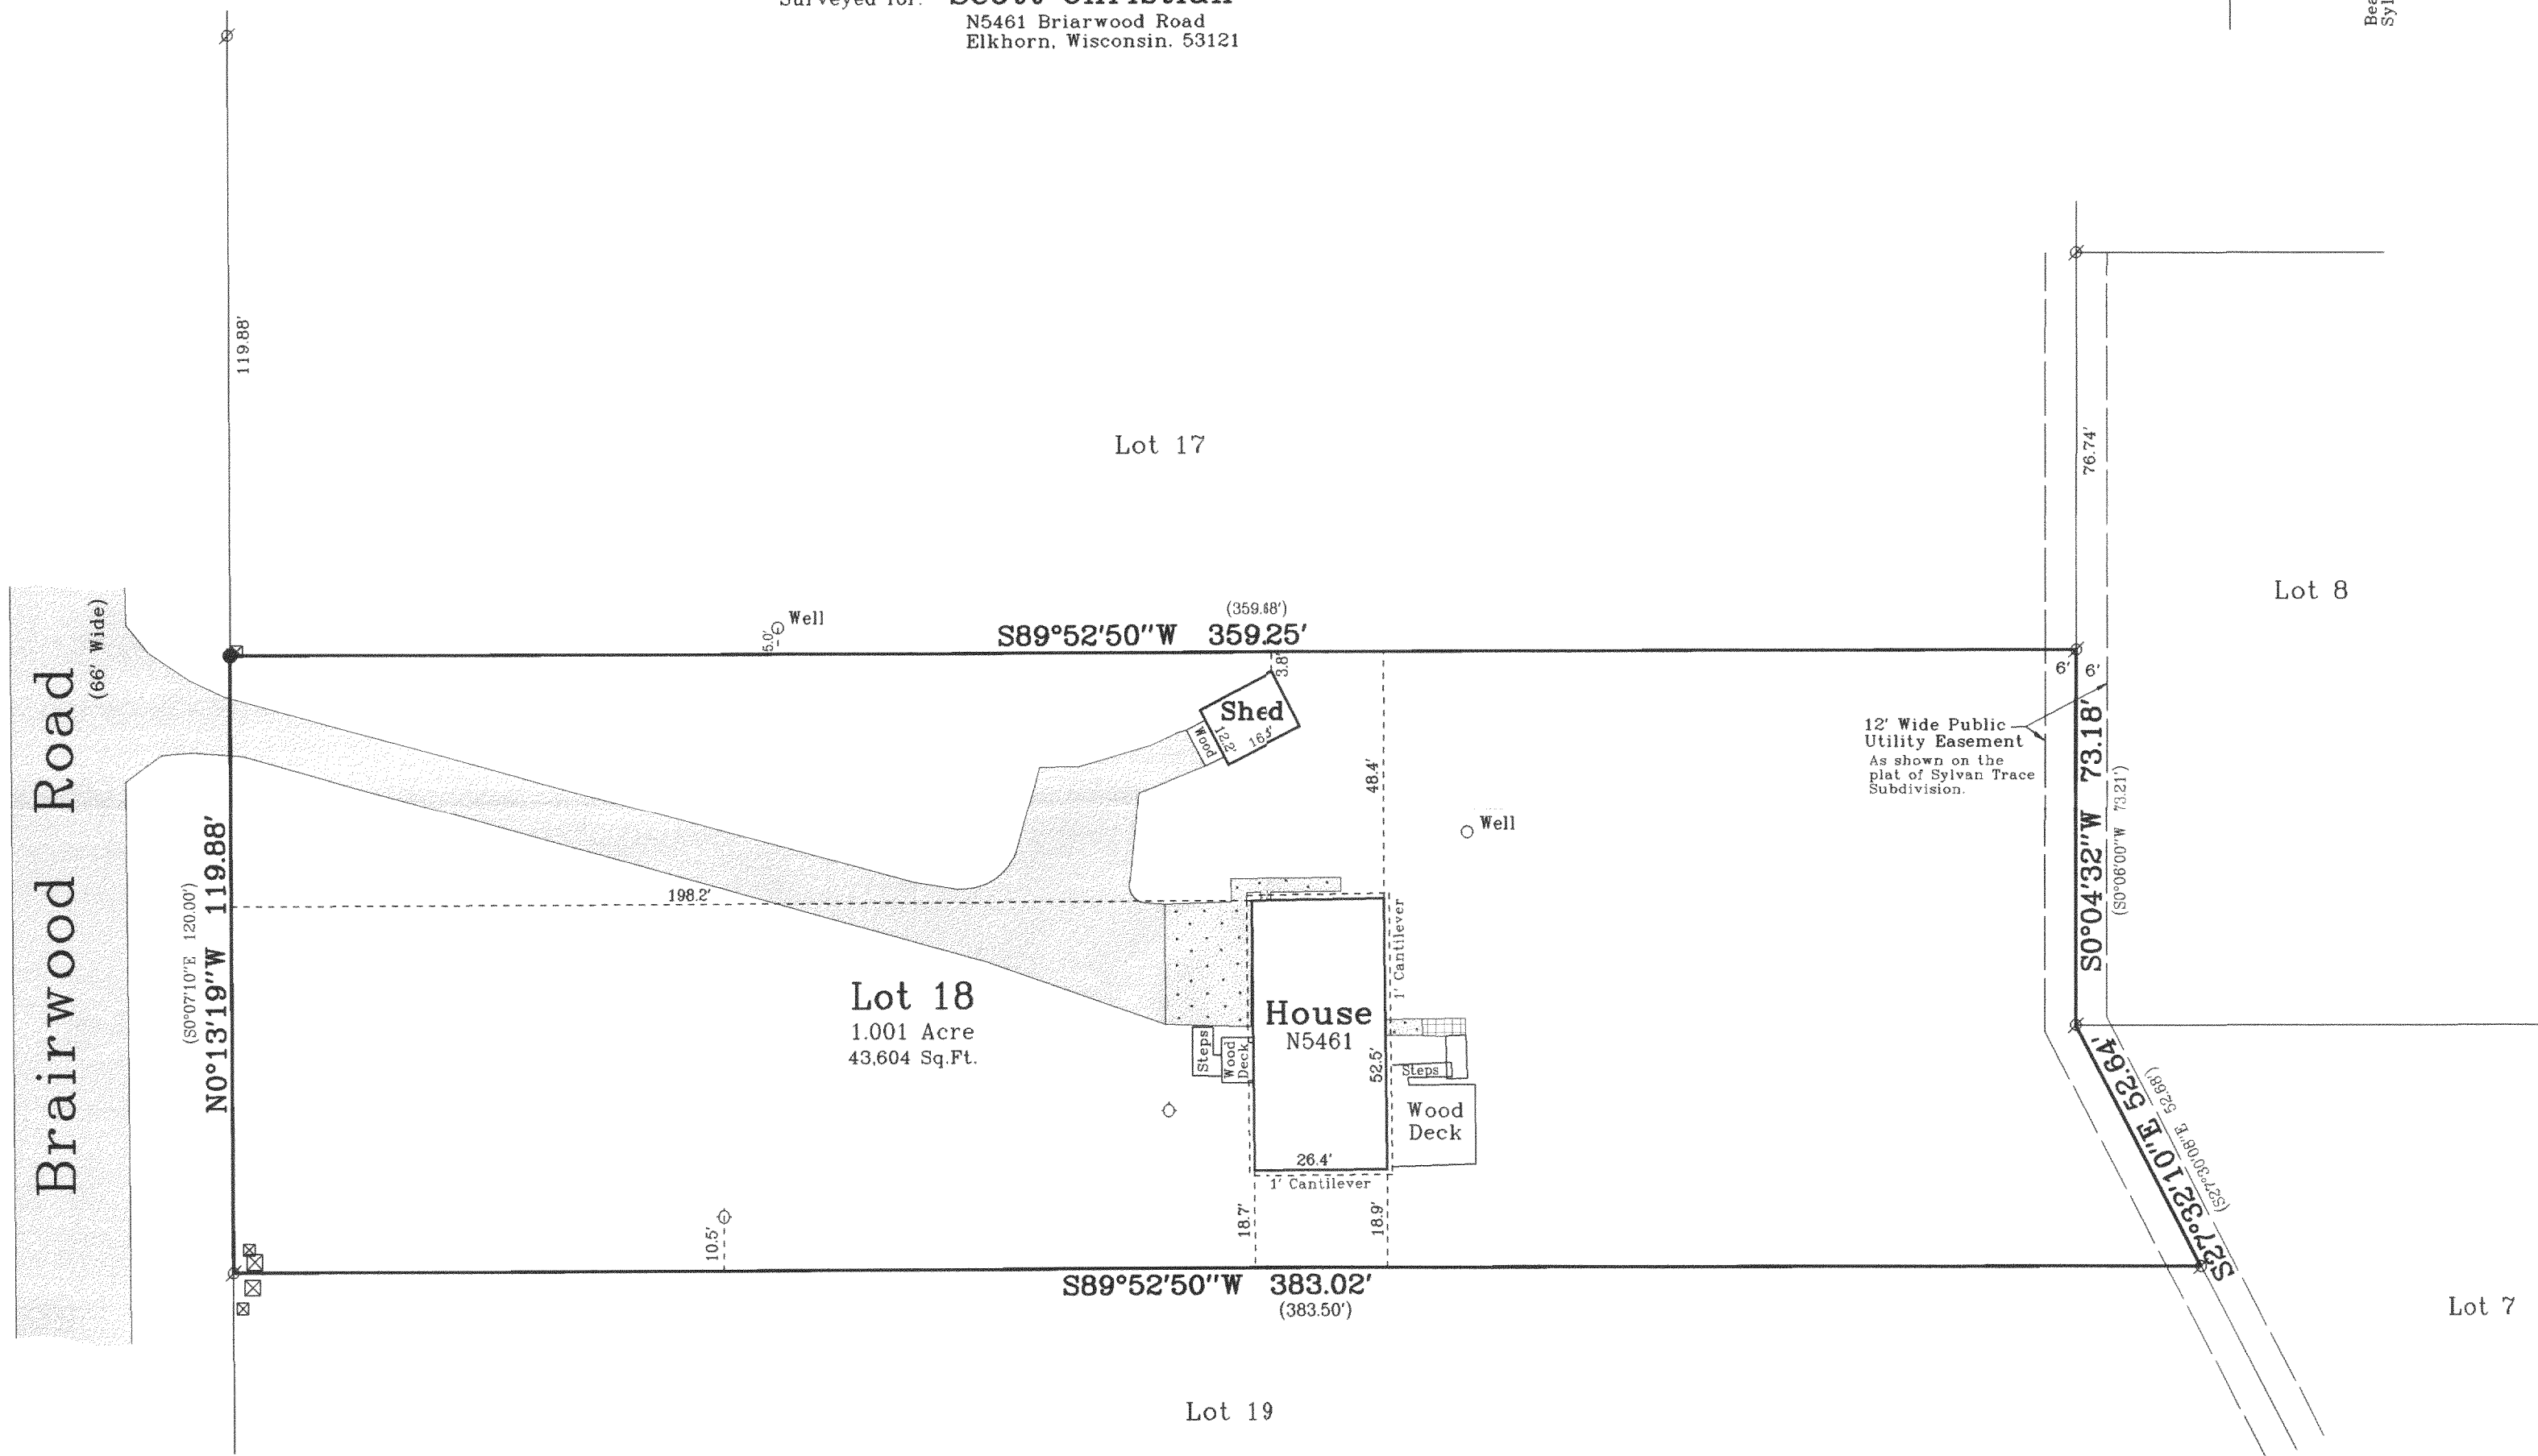

Not Certified Unless
Stamped in Red.

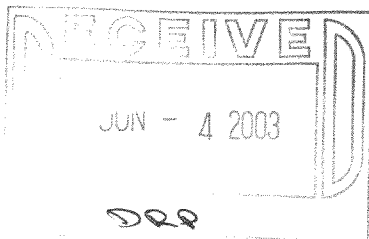


Copyright c 2003 by Jensen & Olson Land Surveying, LLC.

All rights reserved. No part of this survey plat may be reproduced or transmitted in any form by any means - graphic, electronic, or mechanical, including photocopying, tracing, or information storage and retrieval systems - without permission in writing from Douglas G. Olson, Jensen & Olson Land Surveying, LLC.

I hereby certify that I have surveyed the above described property and the map hereon is correct to the best of my professional knowledge and belief and shows the size and location of the property, its exterior boundaries, the location and dimensions of all visible structures thereon, boundary fences, apparent easements and roadways and visible encroachments, if any.
This survey is made for the exclusive use of the present owners of property, and also those who purchase, mortgage or guarantee title thereto, within one year from the date hereof.

Douglas G. Olson
Wisconsin Registered Land Surveyor - 2093

Survey Date: May 21, 2003.
Revisions:

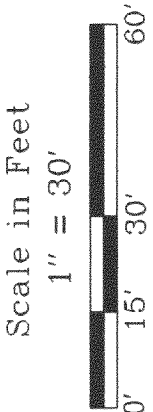

Jensen & Olson Land Surveying, LLC

45 South Wisconsin Street
Elkhorn, Wisconsin. 53121
Telephone (262) 723-3434
Facsimile (262) 723-8044

- Legend**
- Found Iron Pipe
 - Set Iron Rod, 3/4" dia.
 - Recorded Information
 - Utility Pedestal
 - Asphalt Surface
 - Concrete Surface
 - Pavers

Sheet 1 of 1 Sheets
Job Reference Number
2003.075

2003.075