


PLAT OF SURVEY


OF

LOTS 22, 23, 24, 25, BLOCK 20, OF THE 2ND MAP OF
INTERLAKEN SUBDIVISION, LOCATED IN THE SE $\frac{1}{4}$ OF
SECTION 11, T3N R16E, WALWORTH COUNTY, WISCONSIN.

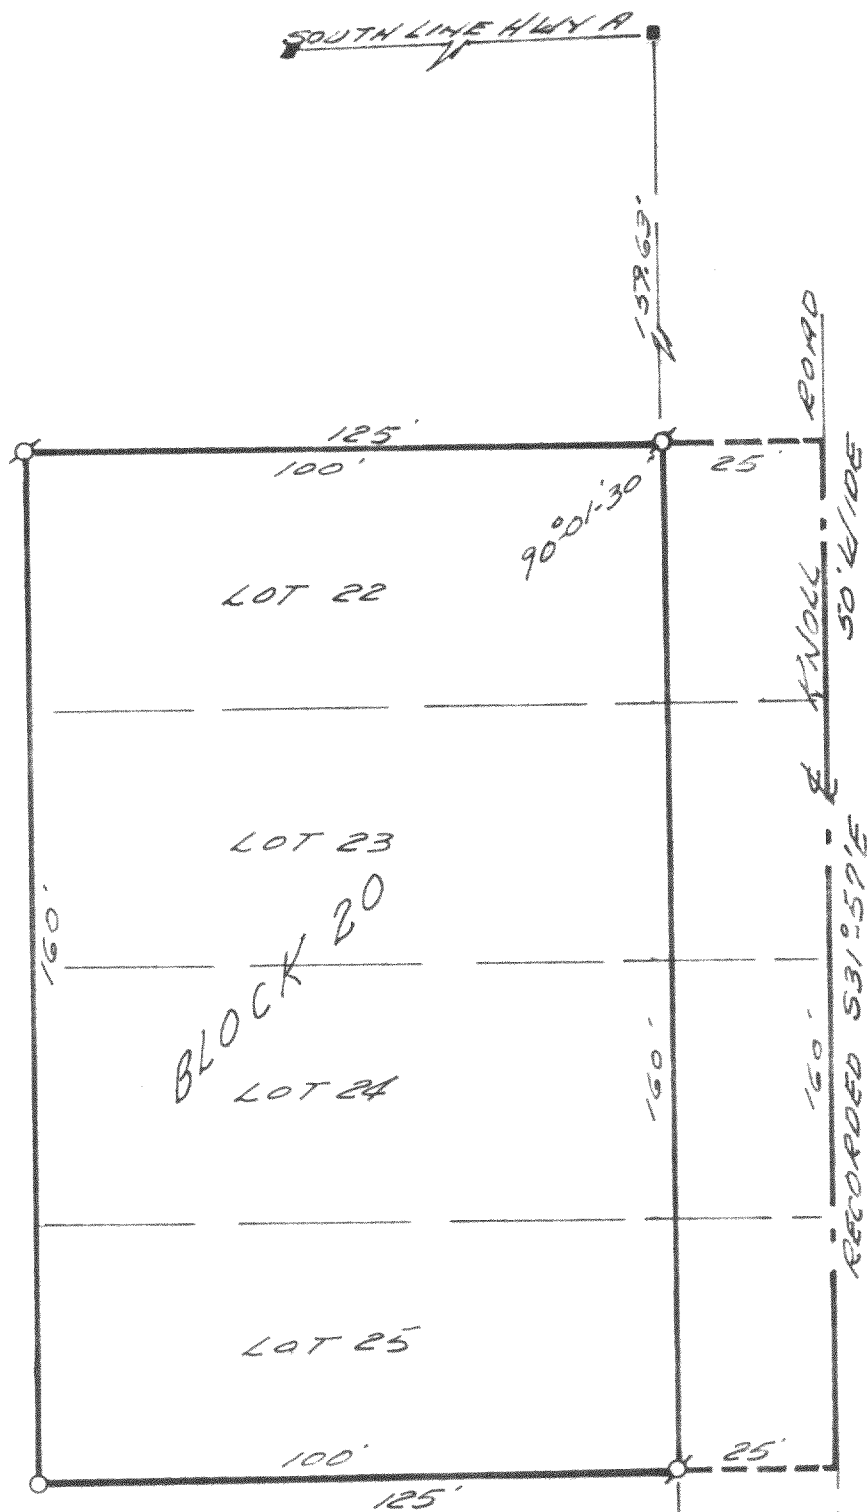

PARCEL Q

ASSUMED FROM
RECORDED PLAT

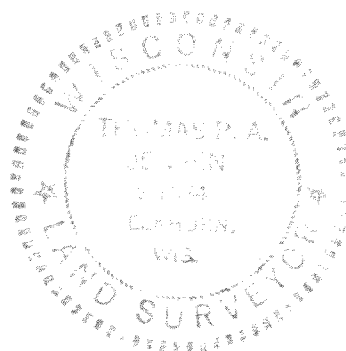

SURVEY AND PLAT BY

JENSEN & JOHNSON, INC.

CIVIL ENGINEERS AND SURVEYORS

Elkhorn, Wisconsin

LEGEND

- — Iron Pipe SET
- — Concrete Monument FOUND
- Scale 1" =
- — IRON PIPE FOUND

WE CERTIFY: That we have surveyed the above described property and that the plat shown hereon is an accurate survey and a true representation thereof and correctly shows the exterior boundary lines and all divisions of said property.

Date APRIL 23, 1974

Thomas P.A. Jensen

G-I-256B

Wisconsin Registered Land Surveyor, No. S-1084

316-155