


PLAT OF SURVEY


OF

LOTS 26, 27, 28, 29, BLOCK 20, OF THE 2ND MAP OF
INTERLAKEN SUBDIVISION, LOCATED IN THE SE $\frac{1}{4}$ OF
SECTION 11, T3N R16E, WALWORTH COUNTY, WISCONSIN.

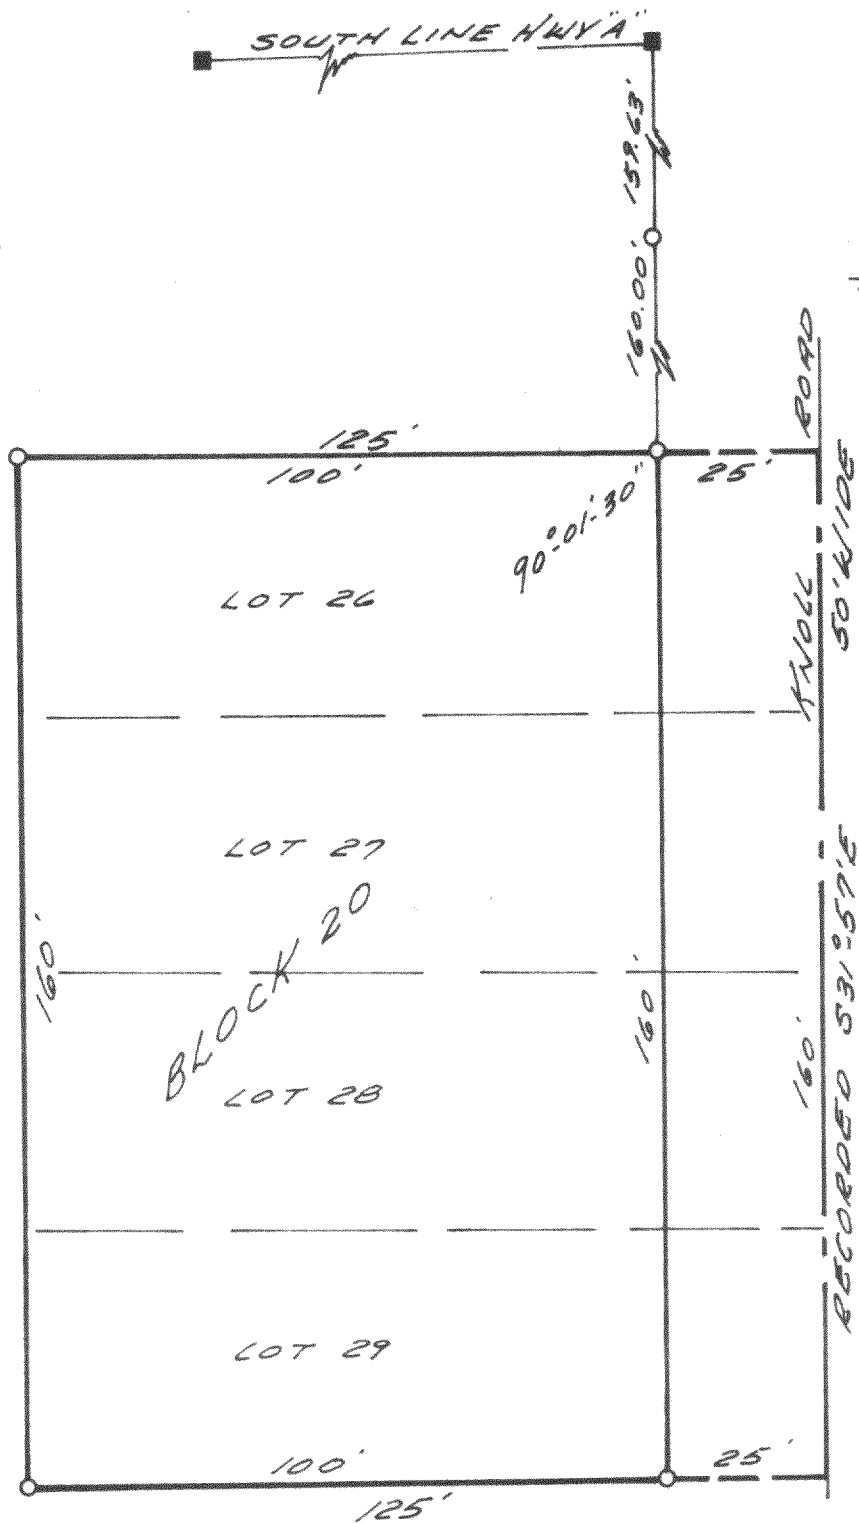

PARCEL "R"

ASSUMED FROM
RECORDED PLAT

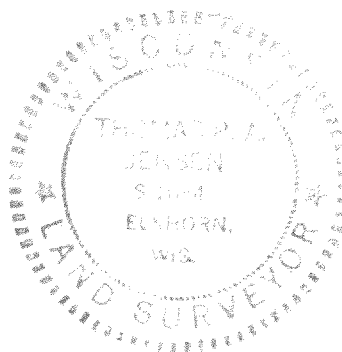

SURVEY AND PLAT BY

JENSEN & JOHNSON, INC.

CIVIL ENGINEERS AND SURVEYORS

Elkhorn, Wisconsin

LEGEND

- — Iron Pipe FOUND
- — Concrete Monument FOUND

Scale 1" = 30'

WE CERTIFY: That we have surveyed the above described property and that the plat shown hereon is an accurate survey and a true representation thereof and correctly shows the exterior boundary lines and all divisions of said property.

Date APRIL 23, 1974

Thomas P. A. Jensen

Wisconsin Registered Land Surveyor, No. S-1084

GI-257

316 156