


ENGINEERING — ARCHITECTURE — SURVEYING  
7 RIDGWAY COURT — P.O. BOX 437, ELKHORN, WISCONSIN, 53121  
PHONE: (262) 723-2098 FAX: (262) 723-5886

LOTS 6, 7, & 22, 23 OF BLOCK 75 OF  
THE FIFTH MAP OF INTERLAKEN

- WORK ORDERED BY -  
RICHARD HOWARTH  
850 N. WISCONSIN STREET  
ELKHORN, WI. 53121

○ = FOUND IRON PIPE STAKE  
● = SET IRON REBAR STAKE, 3/4"  
DIA. x 24" x 1.50 lbs./ft.  
(XXX) = RECORDED AS

—8' WIDE FUTURE ROADWAY DEDICATION

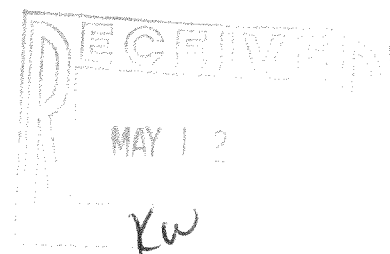

REVISÉD 03-08-2004

REVISED 05-06-2004 TO SHOW SIZE &  
LOCATION OF AS BUILT FOUNDATION

FEBRUARY 20, 2004

DATE

PROJECT: 5015.41  
DATE: 02-20-2004  
SHEET: 1 OF 1

PETER S. GORDON R.L.S. 2101

GI 00658A

316-1638