

ABERNATHY and ASSOCIATES

Kenneth B. Abernathy Jr.

Wisconsin Registered Land Surveyor

S-1594

W4056 BRAY RD.

ELKHORN, WI. 53121

PHONE: (262) 723-4260 (OFFICE)

(262) 723-7209 (FAX)

Email: abernathy@elknet.net


OWNERS: BRIAN AND SUSEN RASMUSSEN

W6612 BARKERS ROAD

ELKHORN, WI. 53121

## PLAT OF SURVEY

LOTS 64 - 69 INCLUSIVE OF BLOCK A OF NORTH LAKE BEACH  
TRACT NO. 3, LOCATED IN SECTION 8, TOWN 3 NORTH, RANGE  
16 EAST, WALWORTH COUNTY, WISCONSIN.

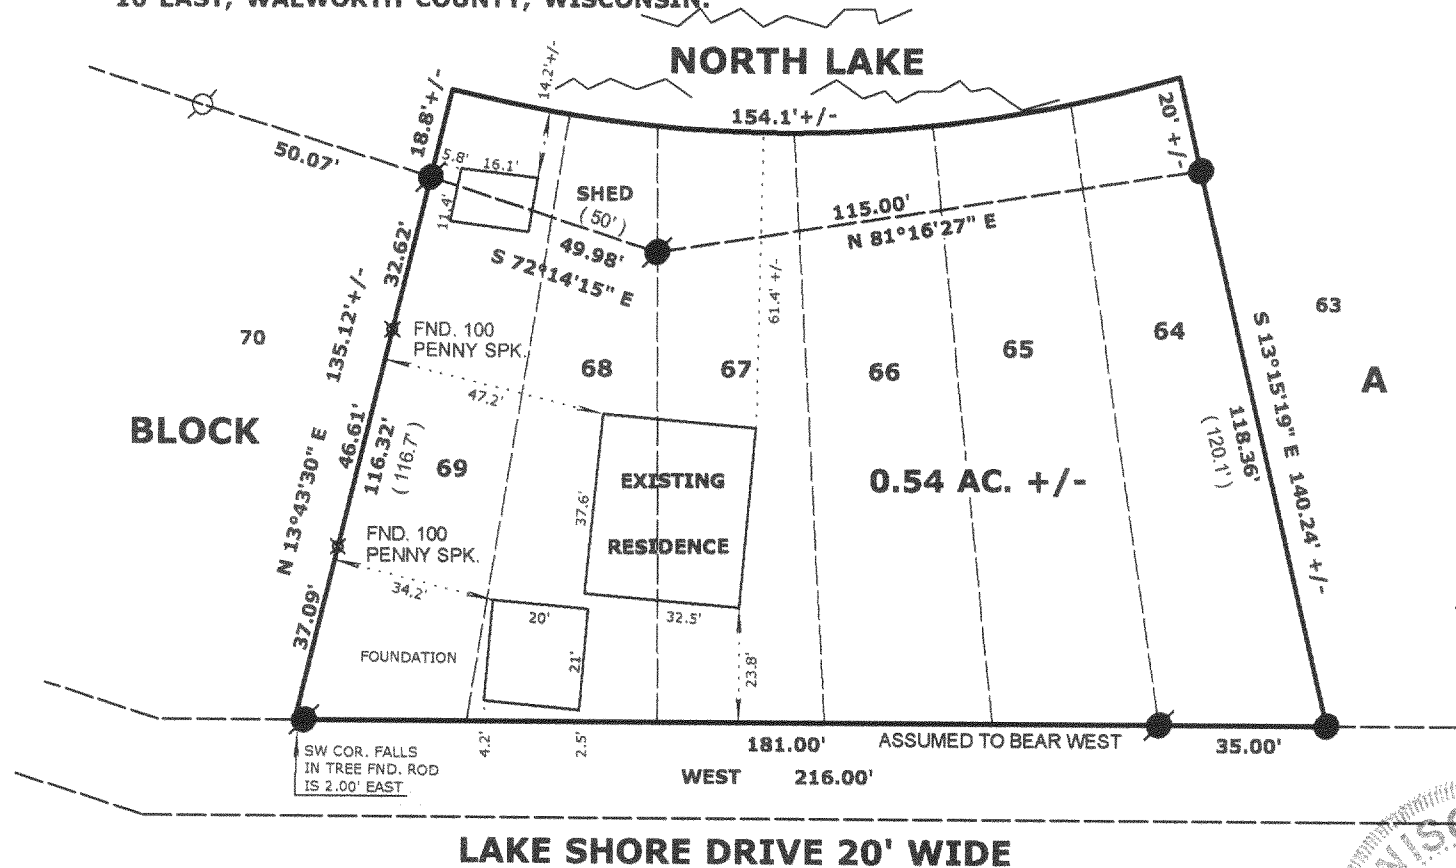

### Legend

- Ø FOUND IRON PIPE
- FOUND IRON ROD
- ⊠ FOUND BRASS CAPPED MONUMENT
- ⊗ FOUND CONCRETE MONUMENT
- + CHISEL CUT IN CONCRETE
- SET IRON ROD, 24" LONG, WEIGHING 1.5 LBS./LINEAL FT., 3/4" DIA.
- SET IRON ROD, 30" LONG, WEIGHING 4.5 LBS./LINEAL FT., 1-11/16" DIA.
- ( x x ) RECORDED AS DIMENSION
- x x x x EXISTING FENCE

SCALE: 1" = 40 FEET



"I hereby certify that the above described property has been surveyed by me or under my direction and that the above map is a true representation thereof and shows the size and location of the property, its exterior boundaries, the location of all visible structures and dimensions of all principal buildings thereon, boundary fences, apparent easements, roadways and visible encroachments, if any."

"This survey is made for the use of the present owners of the property, and also those who purchase, mortgage, or guarantee the title thereto within one year from the date hereof."

*Kenneth B. Abernathy Jr.*

KENNETH B. ABERNATHY, JR.  
WISCONSIN REGISTERED LAND SURVEYOR, S-1594

Date: JUNE 16, 2004 Job No. 04.602

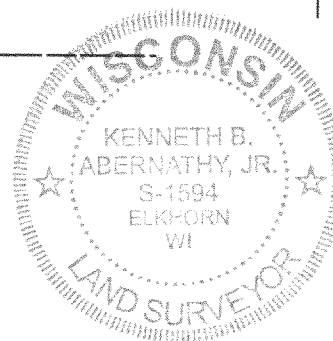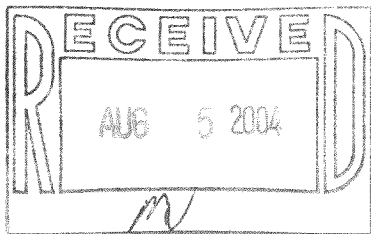

GNLB3 00318 + GNLB3 00319

316-1648