

Plat of Survey



of

Lot 2 of Certified Survey Map No. 2260,

recorded in Vol. 11 of Certified Survey Maps of Walworth County on Page 63 and located in the Southeast 1/4 and the Southwest 1/4 of Section 12, Town 3 North, Range 16 East, Town of Sugar Creek, Walworth County, Wisconsin.


Surveyed for: **The Rauland Agency, Inc.**
118 Kenosha Street * P.O. Box 159
Walworth, Wisconsin. 53184

House Detail 1"=30'

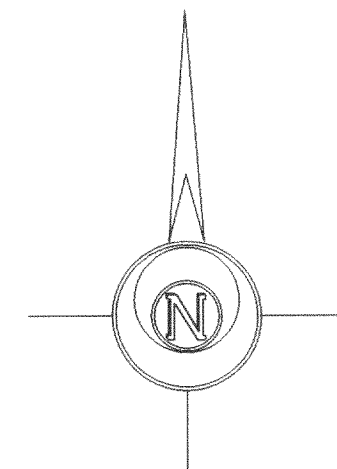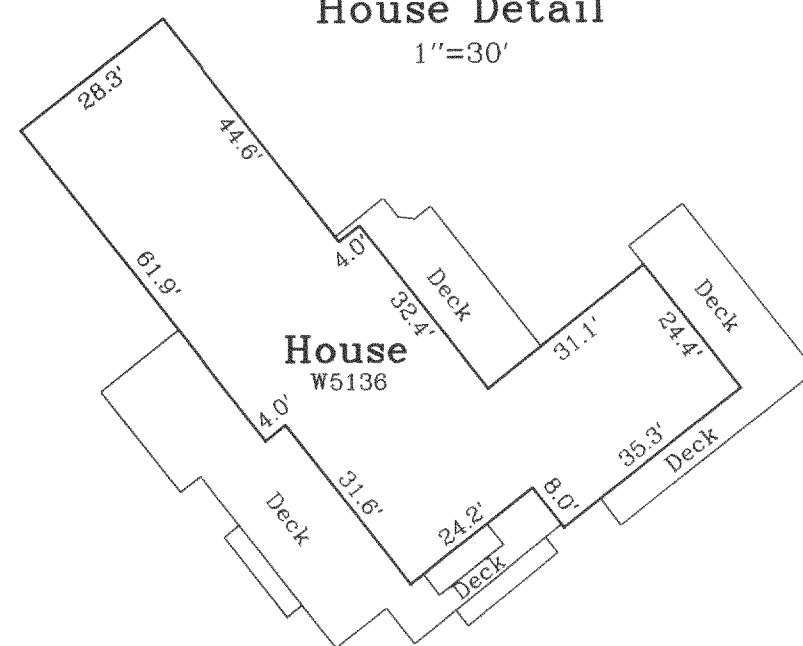

Bearings reference to Certified Survey Map No. 2260.

Survey Date: October 15, 2004.
Revisions: No. 1 - Pool & Ditch
No. 2 - Lot number

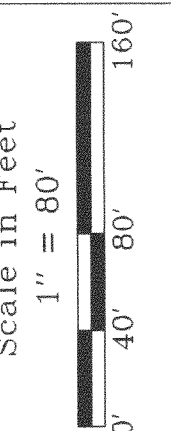



Jensen & Olson Land Surveying, LLC

45 South Wisconsin Street
P.O. Box 322
Elkhorn, Wisconsin. 53121
Telephone (262) 723-3434
Facsimile (262) 723-8044

Legend
Found Iron Pipe
Found Iron Rod
Found Wood Lath
Recorded Information
Utility Pedestal
Asphalt Surface
Patio Block

Sheet 1 of 1 Sheets
Job Reference Number
2004.124

2004.124

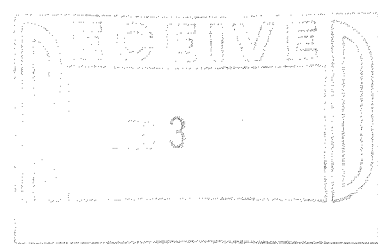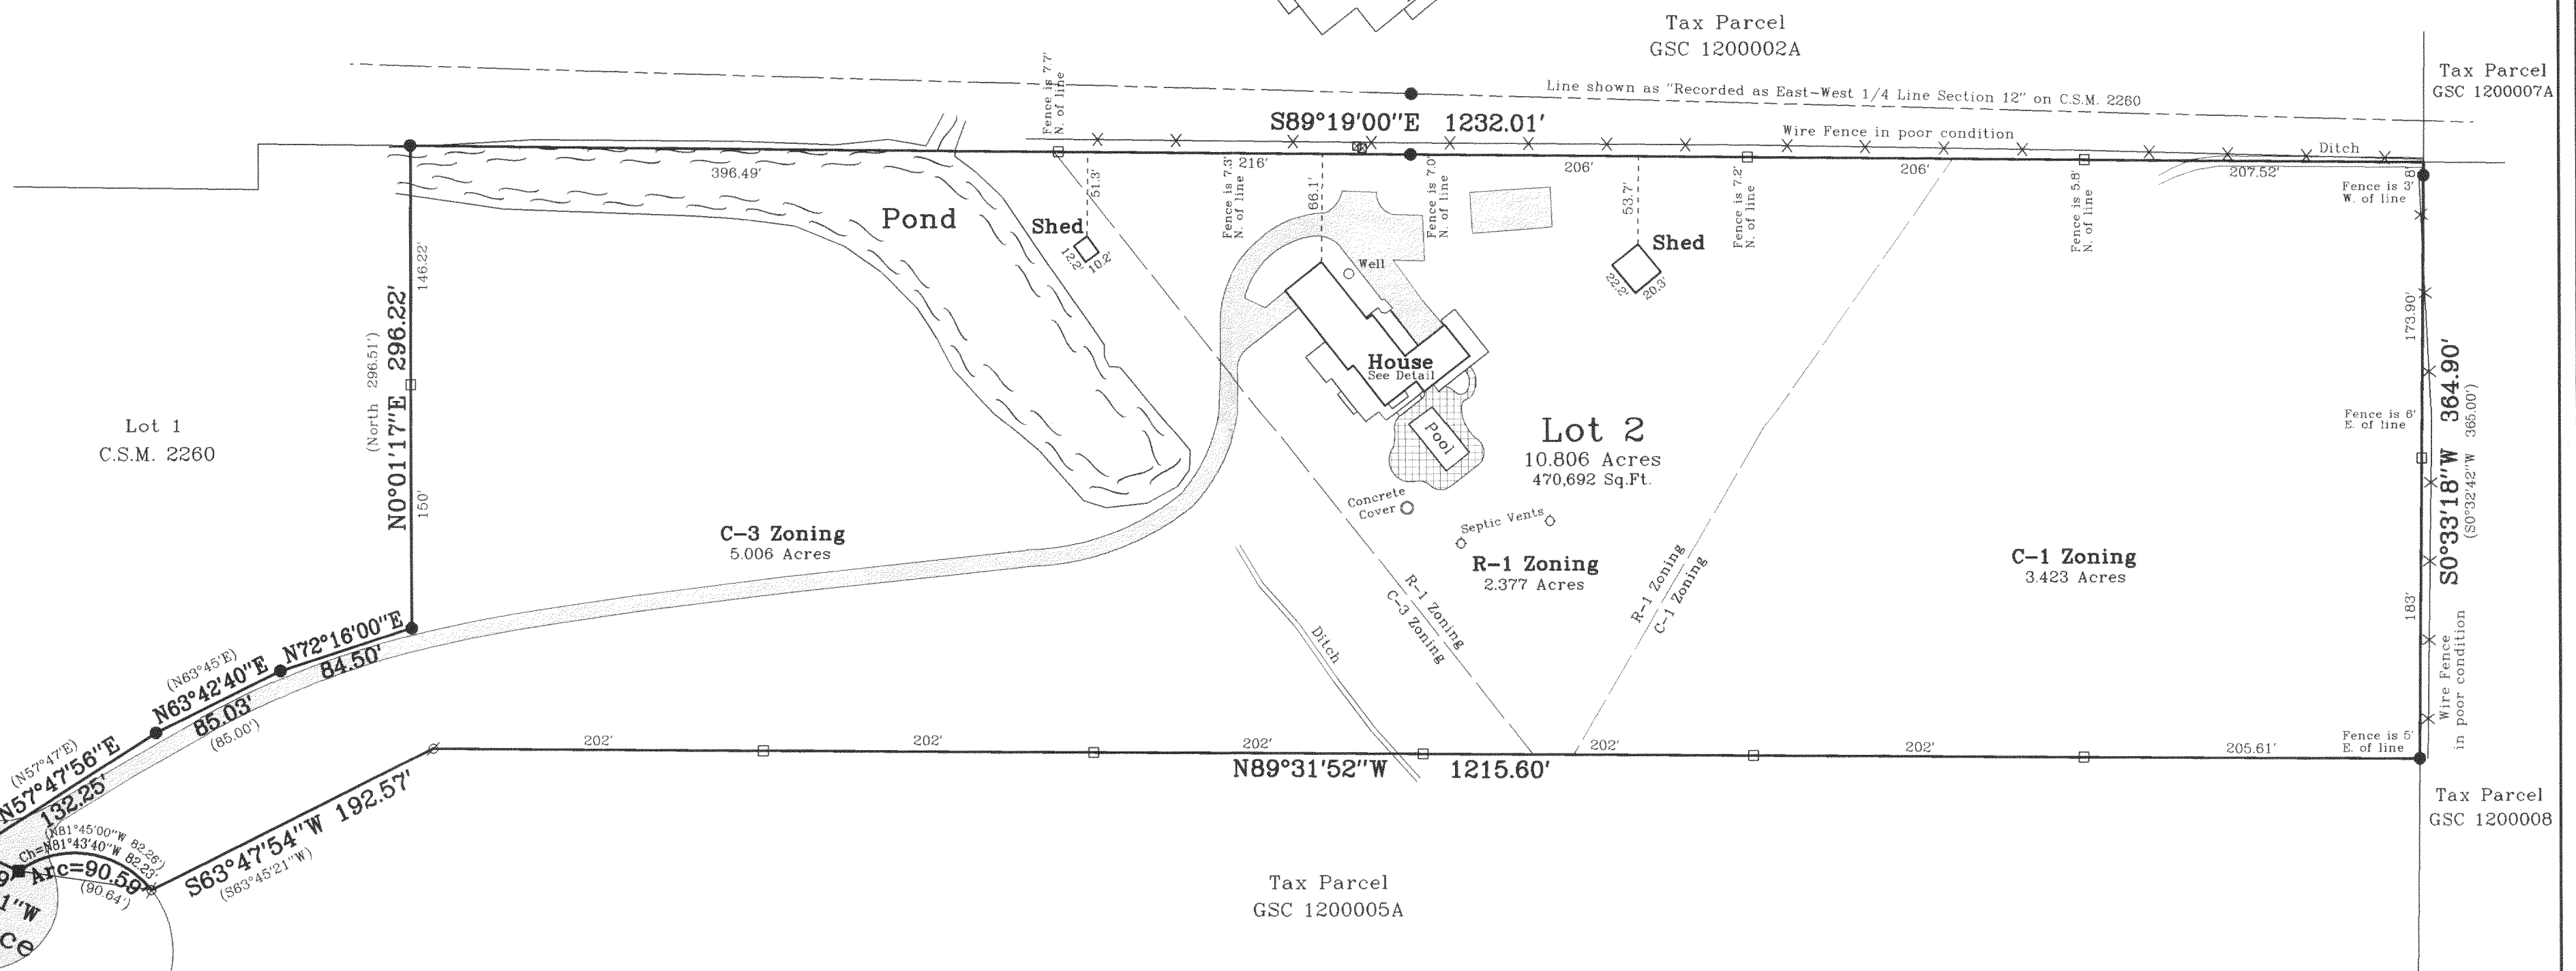

Notes: 1) This survey plat is not certified unless signed and sealed in red ink.
2) This survey is subject to Wisconsin lien laws. This Plat of Survey is the notice of intent to file lien. Lien waiver required.

Copyright c 2004 by Jensen & Olson Land Surveying, LLC.
All rights reserved. No part of this survey plat may be reproduced or transmitted in any form by any means - graphic, electronic, or mechanical, including photocopying, tracing, or information storage and retrieval systems - without permission in writing from Douglas G. Olson, Jensen & Olson Land Surveying, LLC.

I hereby certify that I have surveyed the above described property and the map hereon is correct to the best of my professional knowledge and belief and shows the size and location of the property, its exterior boundaries, the location and dimensions of all visible structures thereon, boundary fences, apparent easements and roadways and visible encroachments, if any.
This survey is made for the exclusive use of the present owners of property, and also those who purchase, mortgage or guarantee title thereto, within one year from the date hereof.

Douglas G. Olson
Wisconsin Registered Land Surveyor - 2093

GA2260-2

316-1698