




LEGEND
 ○ INDICATES IRON PIPE SET
 □ INDICATES CONC. MON.
 MAXIMUM POSITIONAL TOLERANCE = 0.06'

DESCRIPTION:
 LOTS 1, 2, 3, 4, 5, 6, & 7 ALL IN
 BLOCK 37 OF THE 3RD MAP OF
 INTERLAKEN, A SUBDIVISION
 LOCATED IN SECTION 11-3-16,
 WALWORTH COUNTY, WIS.

CERTIFICATE:
 I, JOSEPH M. BIAGI, SURVEYOR, DO HEREBY
 CERTIFY THAT I HAVE SURVEYED THE LANDS
 HEREON DESCRIBED.

DATE:
 APRIL 15, 1975

Joseph M. Biagi
 JOSEPH M. BIAGI
 S-12

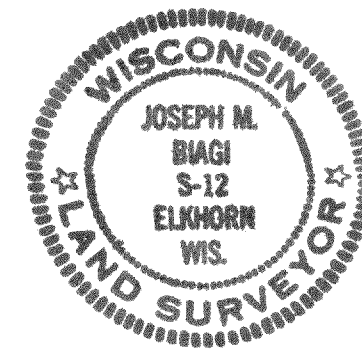

NOTE:
 WELL ENCROACHES 0.4' ON WEST
 " " 1.1' ON EAST
 SHED ENCROACHES 1.1' ON WEST
 " " 0.2' ON EAST

REVISIONS			JAMES MITCHELL (HUTTNER EST.)	
NO.	DATE	BY	LOTS 1-7 BLOCK 37 INTERLAKEN	
1			DRAWN BY GW	SCALE 1" = 30'
2				
3			CHK'D HG	DATE 4-15-75
4				
5			TRACED	APP'D
				26-75