


ABELL SURVEYING & MAPPING

1140 SEQUOIA STREET • DELAVAN, WISCONSIN 53115
262-728-6737

WEST 1/4 CORNER
SECTION 4-3-16

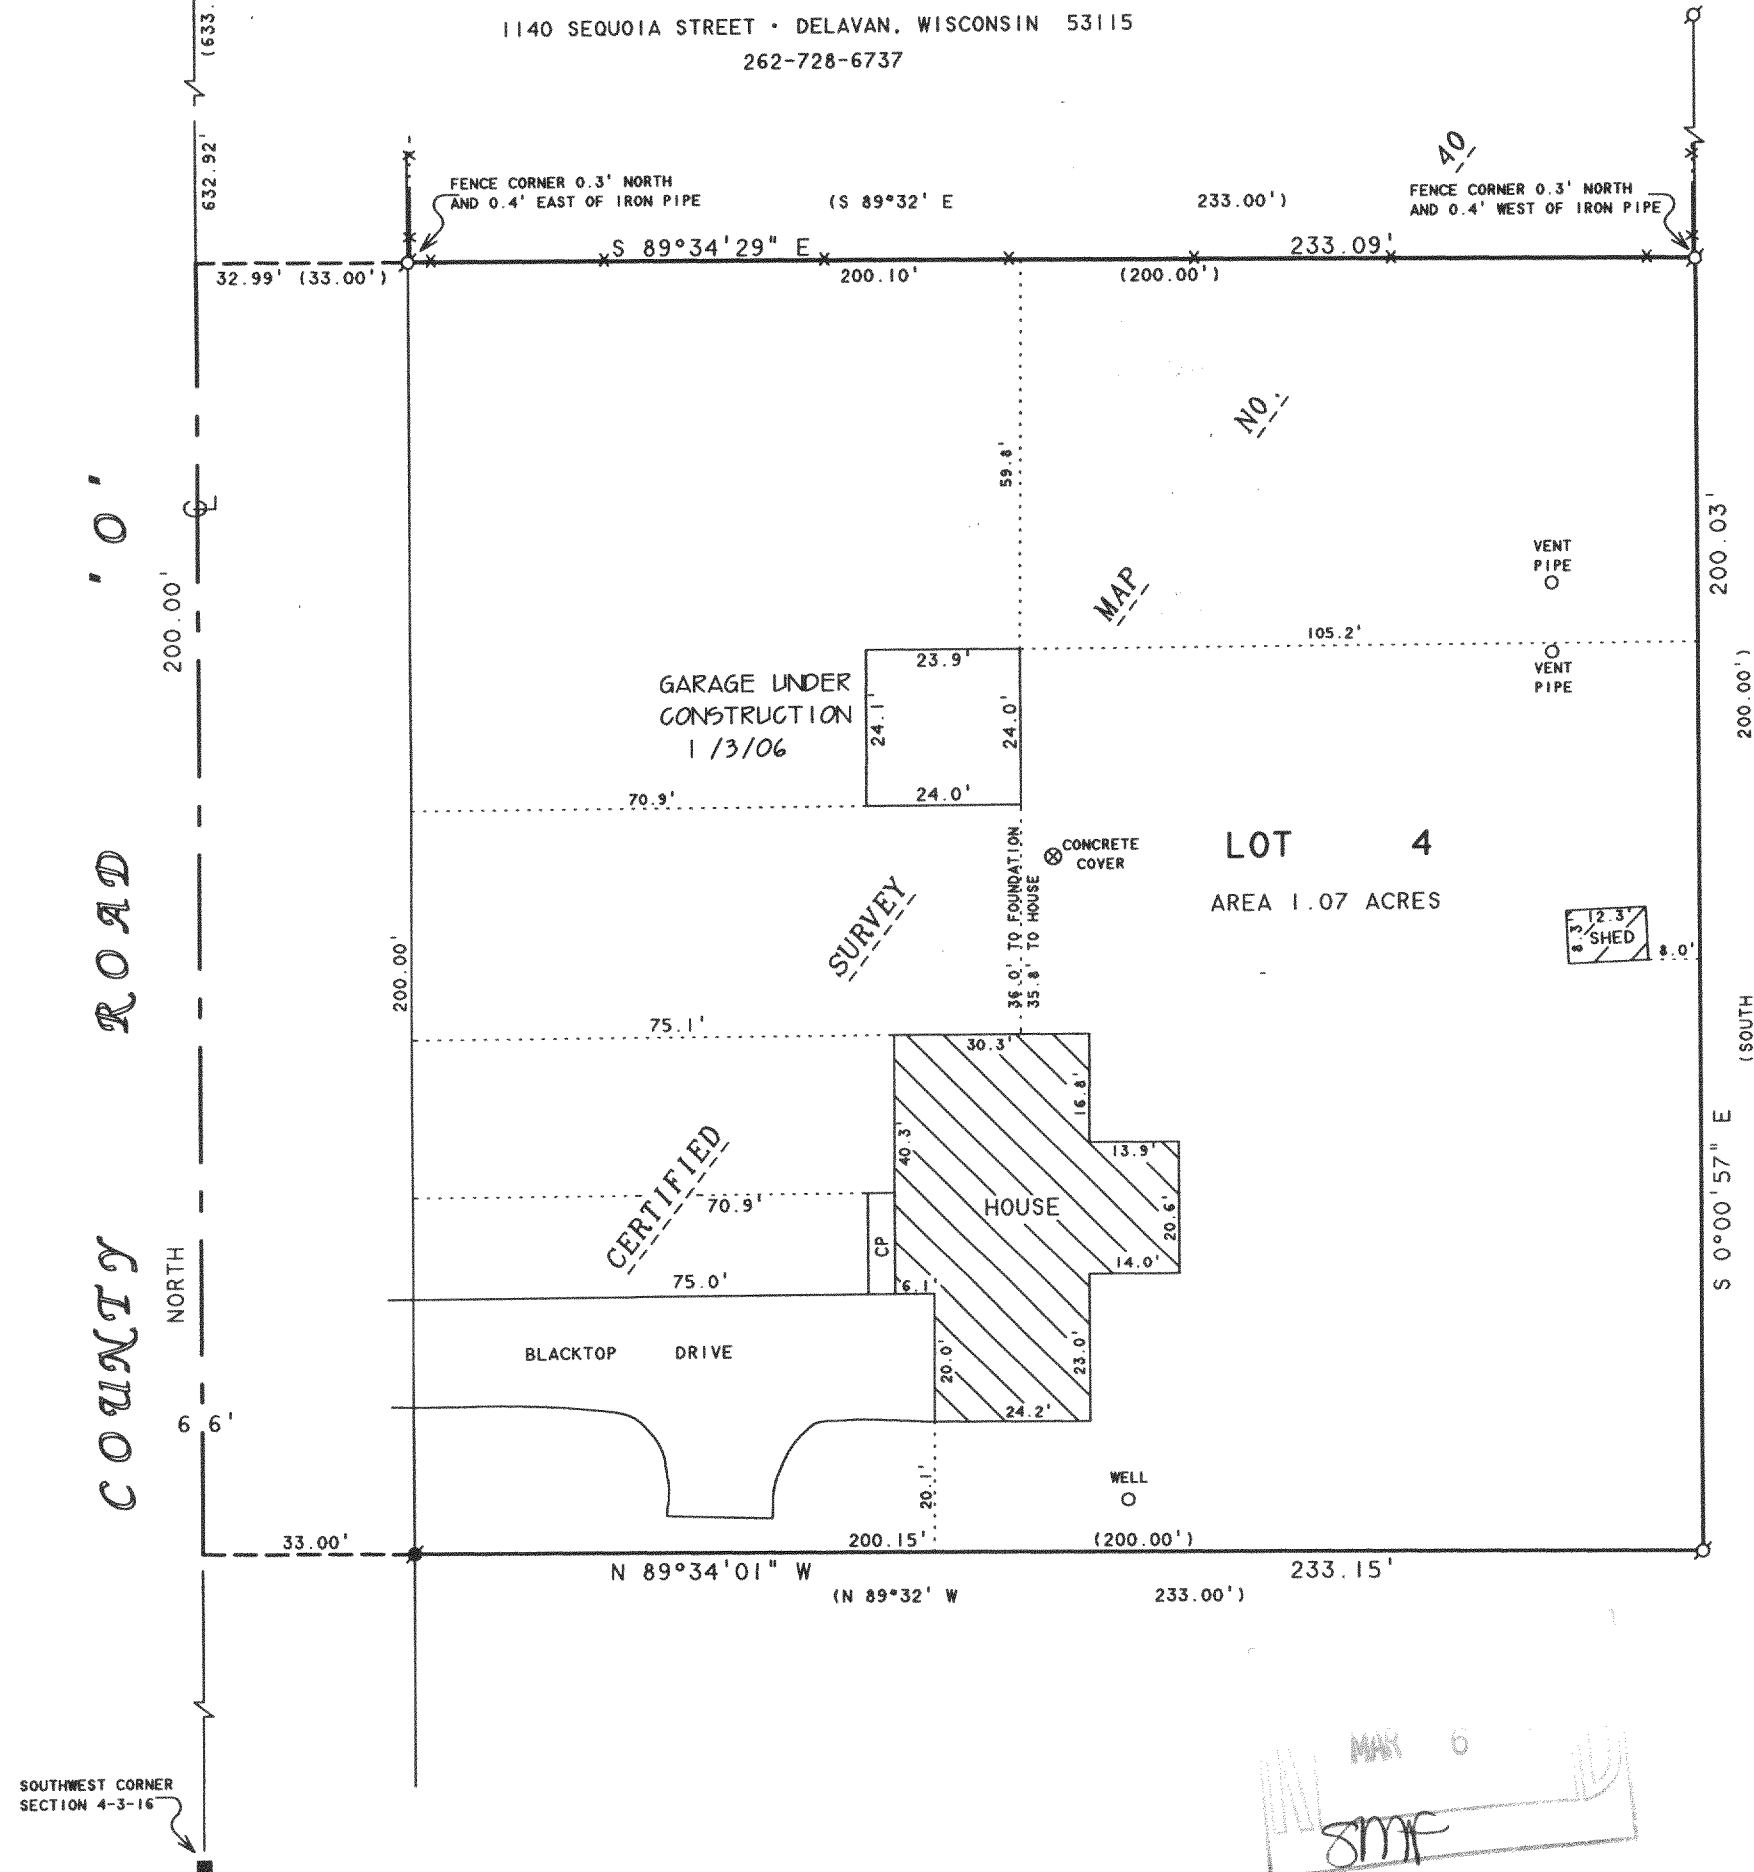

NOTE: BEARINGS ARE REFERENCED TO
CERTIFIED SURVEY MAP NO. 40.

N



SCALE 1"=30'

LEGEND

- - IRON PIPE FOUND
- - IRON ROD FOUND
- - CONCRETE MONUMENT FOUND
- ✕ - WOOD RAIL FENCE
- CP - CONCRETE PORCH
- () - RECORDED AS

REVISED DATE: JANUARY 4, 2006
REVISED TO SHOW GARAGE UNDER
CONSTRUCTION.

ORDERED BY: MARY BELL
N7074 COUNTY ROAD "O"
ELKHORN, WI 53121

PLAT OF SURVEY OF

LOT 4, CERTIFIED SURVEY MAP NO. 40, LOCATED IN THE
SOUTHWEST 1/4 OF SECTION 4, T3N, R16E, WALWORTH
COUNTY, WISCONSIN.

I HEREBY CERTIFY THAT I HAVE SURVEYED THE ABOVE DESCRIBED PROPERTY AND THAT THE
ABOVE MAP IS A TRUE REPRESENTATION THEREOF AND SHOWS THE SIZE AND LOCATION OF
THE PROPERTY, ITS EXTERIOR BOUNDARIES, THE LOCATION OF ALL VISIBLE STRUCTURES
AND DIMENSIONS OF ALL PRINCIPAL BUILDINGS THEREON, BOUNDARY FENCES, APPARENT
EASEMENTS, ROADWAYS AND VISIBLE ENCROACHMENTS, IF ANY, TO THE BEST OF MY
KNOWLEDGE AND BELIEF.

THIS SURVEY IS MADE FOR THE USE OF THE PRESENT OWNERS OF THE PROPERTY, AND ALSO
THOSE WHO PURCHASE, MORTGAGE, OR GUARANTEE THE TITLE THERETO WITHIN ONE (1) YEAR
FROM DATE HEREON.

David F. Abell

DAVID F. ABELL
WISCONSIN REGISTERED LAND SURVEYOR, S-1596

November 9, 2005

DATE: November 9, 2005 JOB NUMBER - 94234B
NOTE: THIS IS NOT A CERTIFIED COPY UNLESS SEALED.

GA 4-4

316-1828