


AS-BUILT MAPPING CONTROL PLAN

LOT 8, EXCEPT THE NORTH 20 FEET, LOTS 9-15, BLOCK 30 OF
THE 3rd MAP OF INTERLAKEN

LOCATED IN PART OF TOWN 2 NORTH, RANGE 16 EAST,
TOWN OF SUGAR CREEK, WALWORTH COUNTY, WISCONSIN

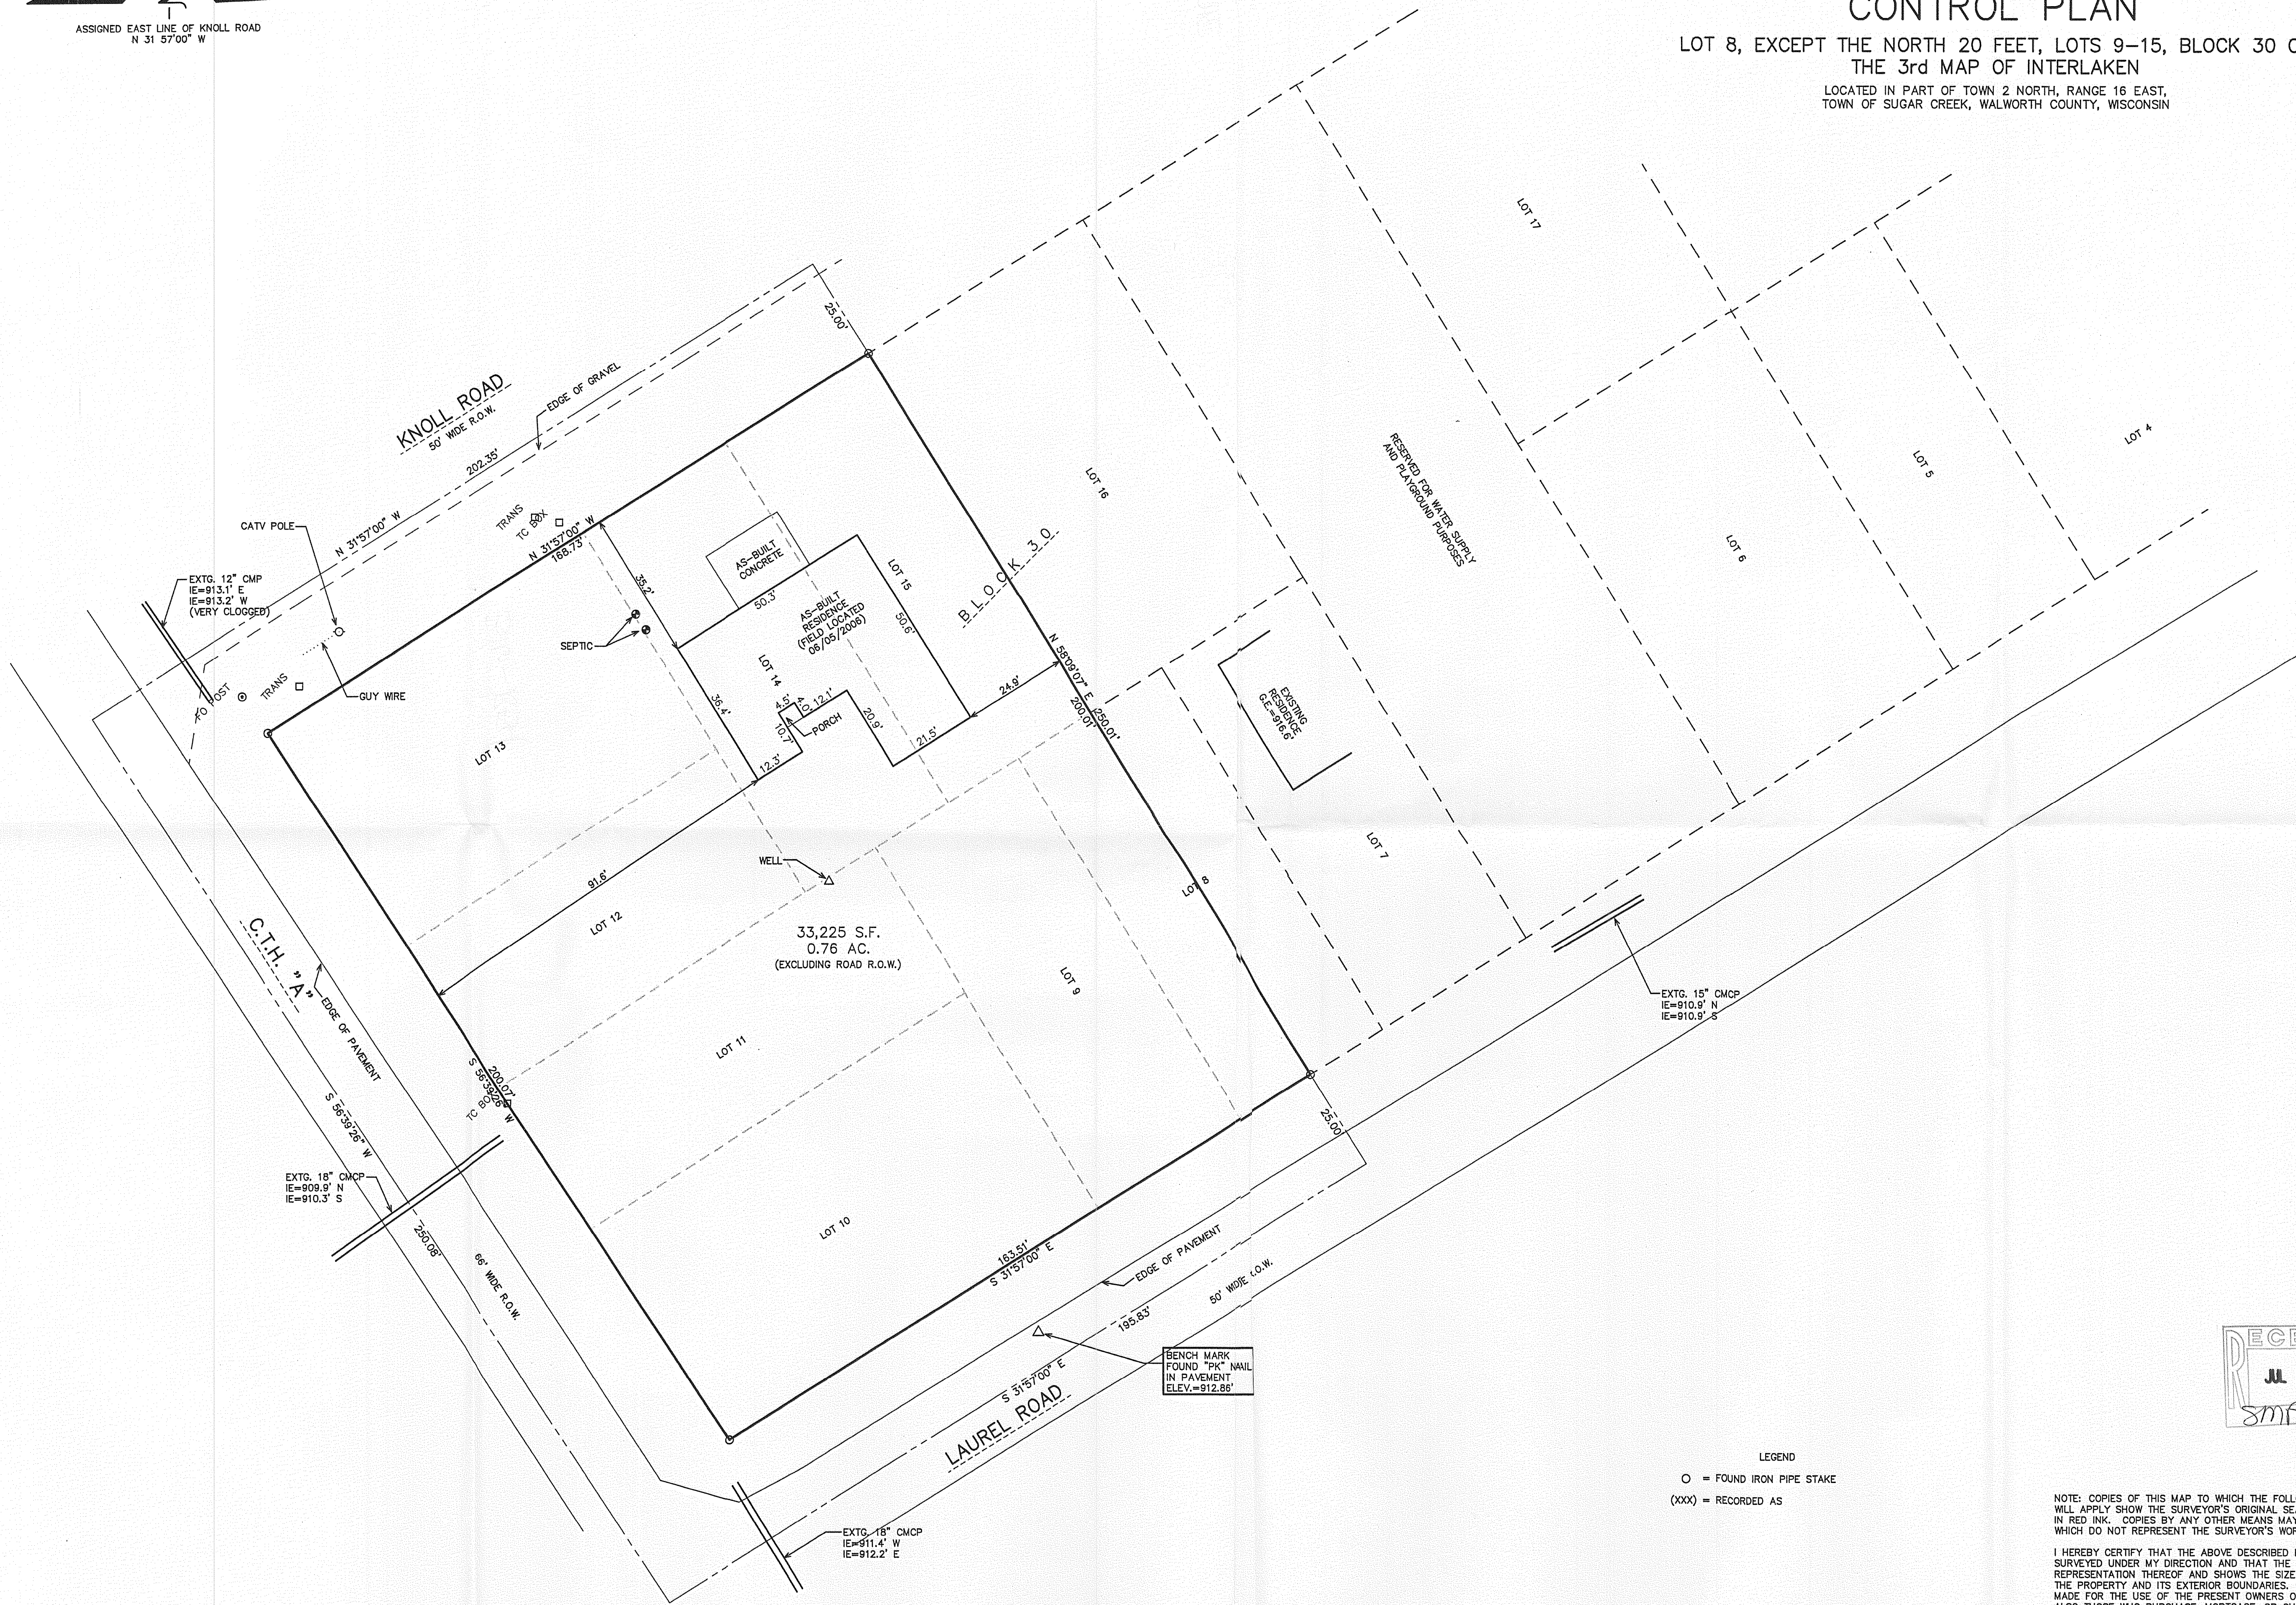




LEGEND
O = FOUND IRON PIPE STAKE
(XXX) = RECORDED AS

NOTE: COPIES OF THIS MAP TO WHICH THE FOLLOWING CERTIFICATE
WILL APPLY SHOW THE SURVEYOR'S ORIGINAL SEAL AND SIGNATURE
IN RED INK. COPIES BY ANY OTHER MEANS MAY HAVE ALTERATIONS
WHICH DO NOT REPRESENT THE SURVEYOR'S WORK PRODUCT.

I HEREBY CERTIFY THAT THE ABOVE DESCRIBED PROPERTY HAS BEEN
SURVEYED UNDER MY DIRECTION AND THAT THE ABOVE MAP IS A TRUE
REPRESENTATION THEREOF AND SHOWS THE SIZE AND LOCATION OF
THE PROPERTY AND ITS EXTERIOR BOUNDARIES. THIS SURVEY IS
MADE FOR THE USE OF THE PRESENT OWNERS OF THE PROPERTY, AND
ALSO THOSE WHO PURCHASE, MORTGAGE, OR GUARANTEE THE TITLE
THERE TO WITHIN ONE YEAR FROM THE DATE HEREOF.

DATED: 02/15/2005

Peter S. Gordon
PETER S. GORDON R.L.S. 2101

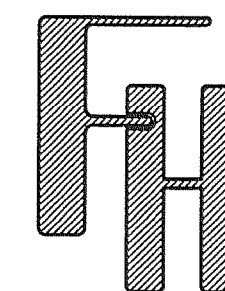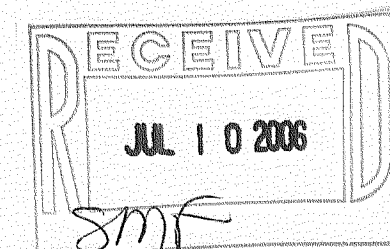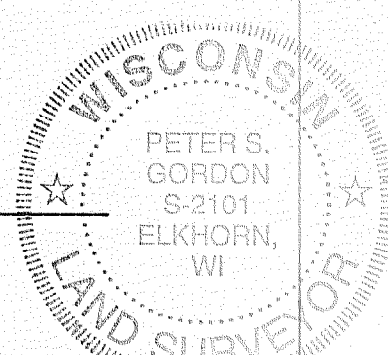

— WORK ORDERED BY —
HOSS REHBERG
114 WEST COURT STREET — P.O. BOX 836
ELKHORN, WI 53121


FARRIS, HANSEN & ASSOCIATES, INC.
ENGINEERING — ARCHITECTURE — SURVEYING
7 RIDGWAY COURT P.O. BOX 437
ELKHORN, WISCONSIN 53121
OFFICE: (262) 723-2098 FAX: (262) 723-5886

REVISIONS
02/14/2005
SITE, GRADING,
DRAINAGE, & EROSION
CONTROL PLAN
08/06/2006
TO SHOW SIZE AND
LOCATION OF
AS-BUILT RESIDENCE

PROJECT NO.
6717

DATE
02/07/05

SHEET NO.
1 OF 1

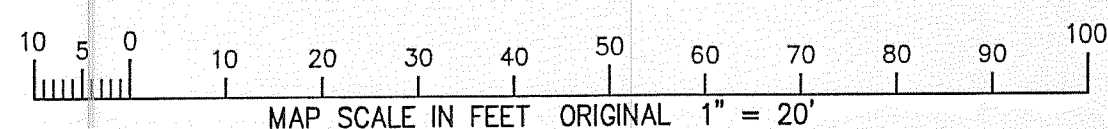

GI-277A

316-1854