
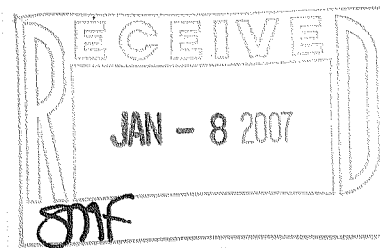


-OF-

SURVEY FOR: JAMES CONSTRUCTION

SURVEY ADDRESS: N6835 DAISY ROAD

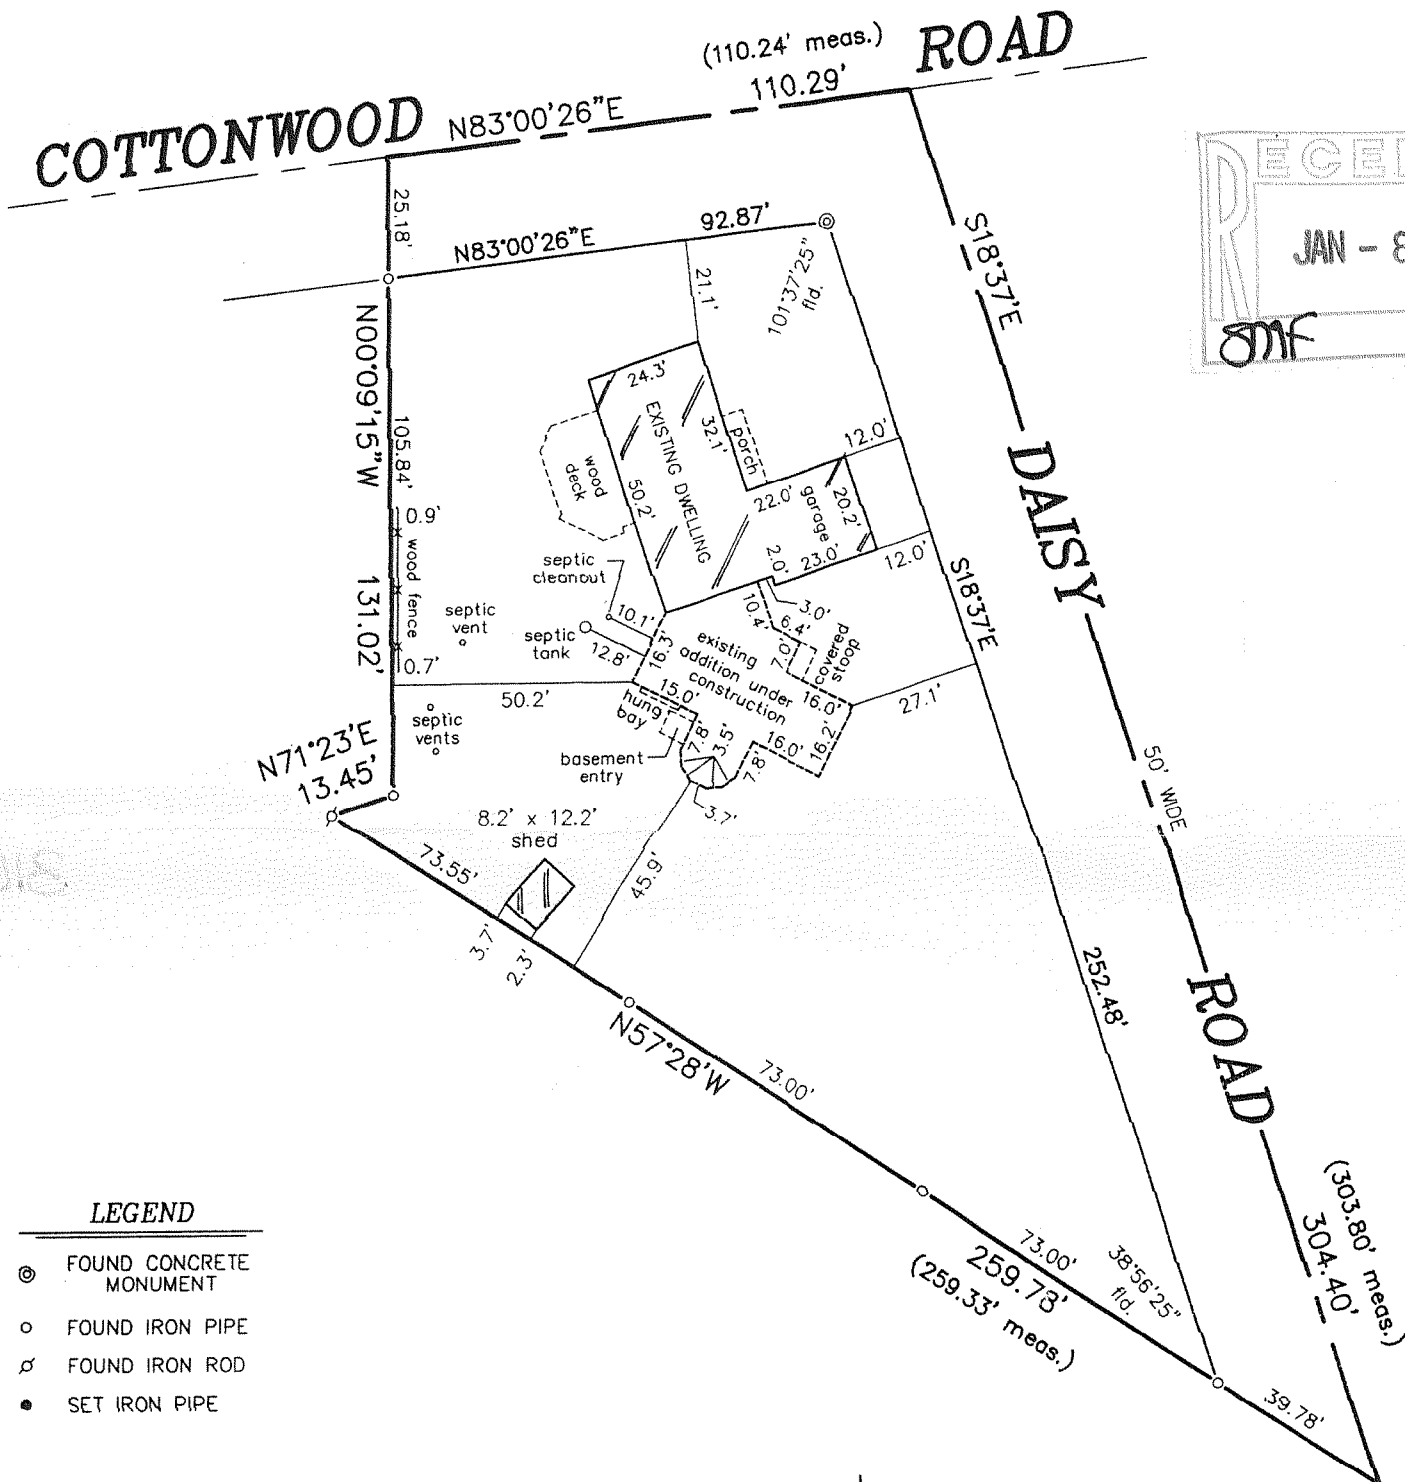

### LEGEND

- ⊙ FOUND CONCRETE MONUMENT
- FOUND IRON PIPE
- ⌀ FOUND IRON ROD
- SET IRON PIPE


"I hereby certify that I have surveyed the above described property and that the above map is a correct representation thereof and shows the size and location of the property, its exterior boundaries, the location of all visible structures and dimensions of all principal buildings thereon, boundary fences, apparent easements, roadways and encroachments, if any."

"This survey is made for the use of the present owners of the property, and those who purchase, mortgage, or guarantee the title thereto within one year from date hereof."

SCALE:  $1'' = 40'$




THIS IS NOT AN ORIGINAL PRINT  
UNLESS THIS SEAL IS RED.

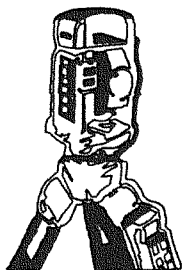

B.W. SURVEYING, INC.

LAND SURVEYS  
MAPPING AND PLANNING  
412 N. PINE STREET  
BURLINGTON, WI 53105  
(262)-767-0225

REVISED: AUGUST 30, 2006 TO  
SHOW ADDITION UNDER CONSTRUCTION

  
 ROBERT J. WETZEL S-1778  
 REVISED: JULY 3, 2006  
 JUNE 28, 2006 7308  
 DATE JOB NUMBER

GI 426 GI 427

316-1898