


104-016

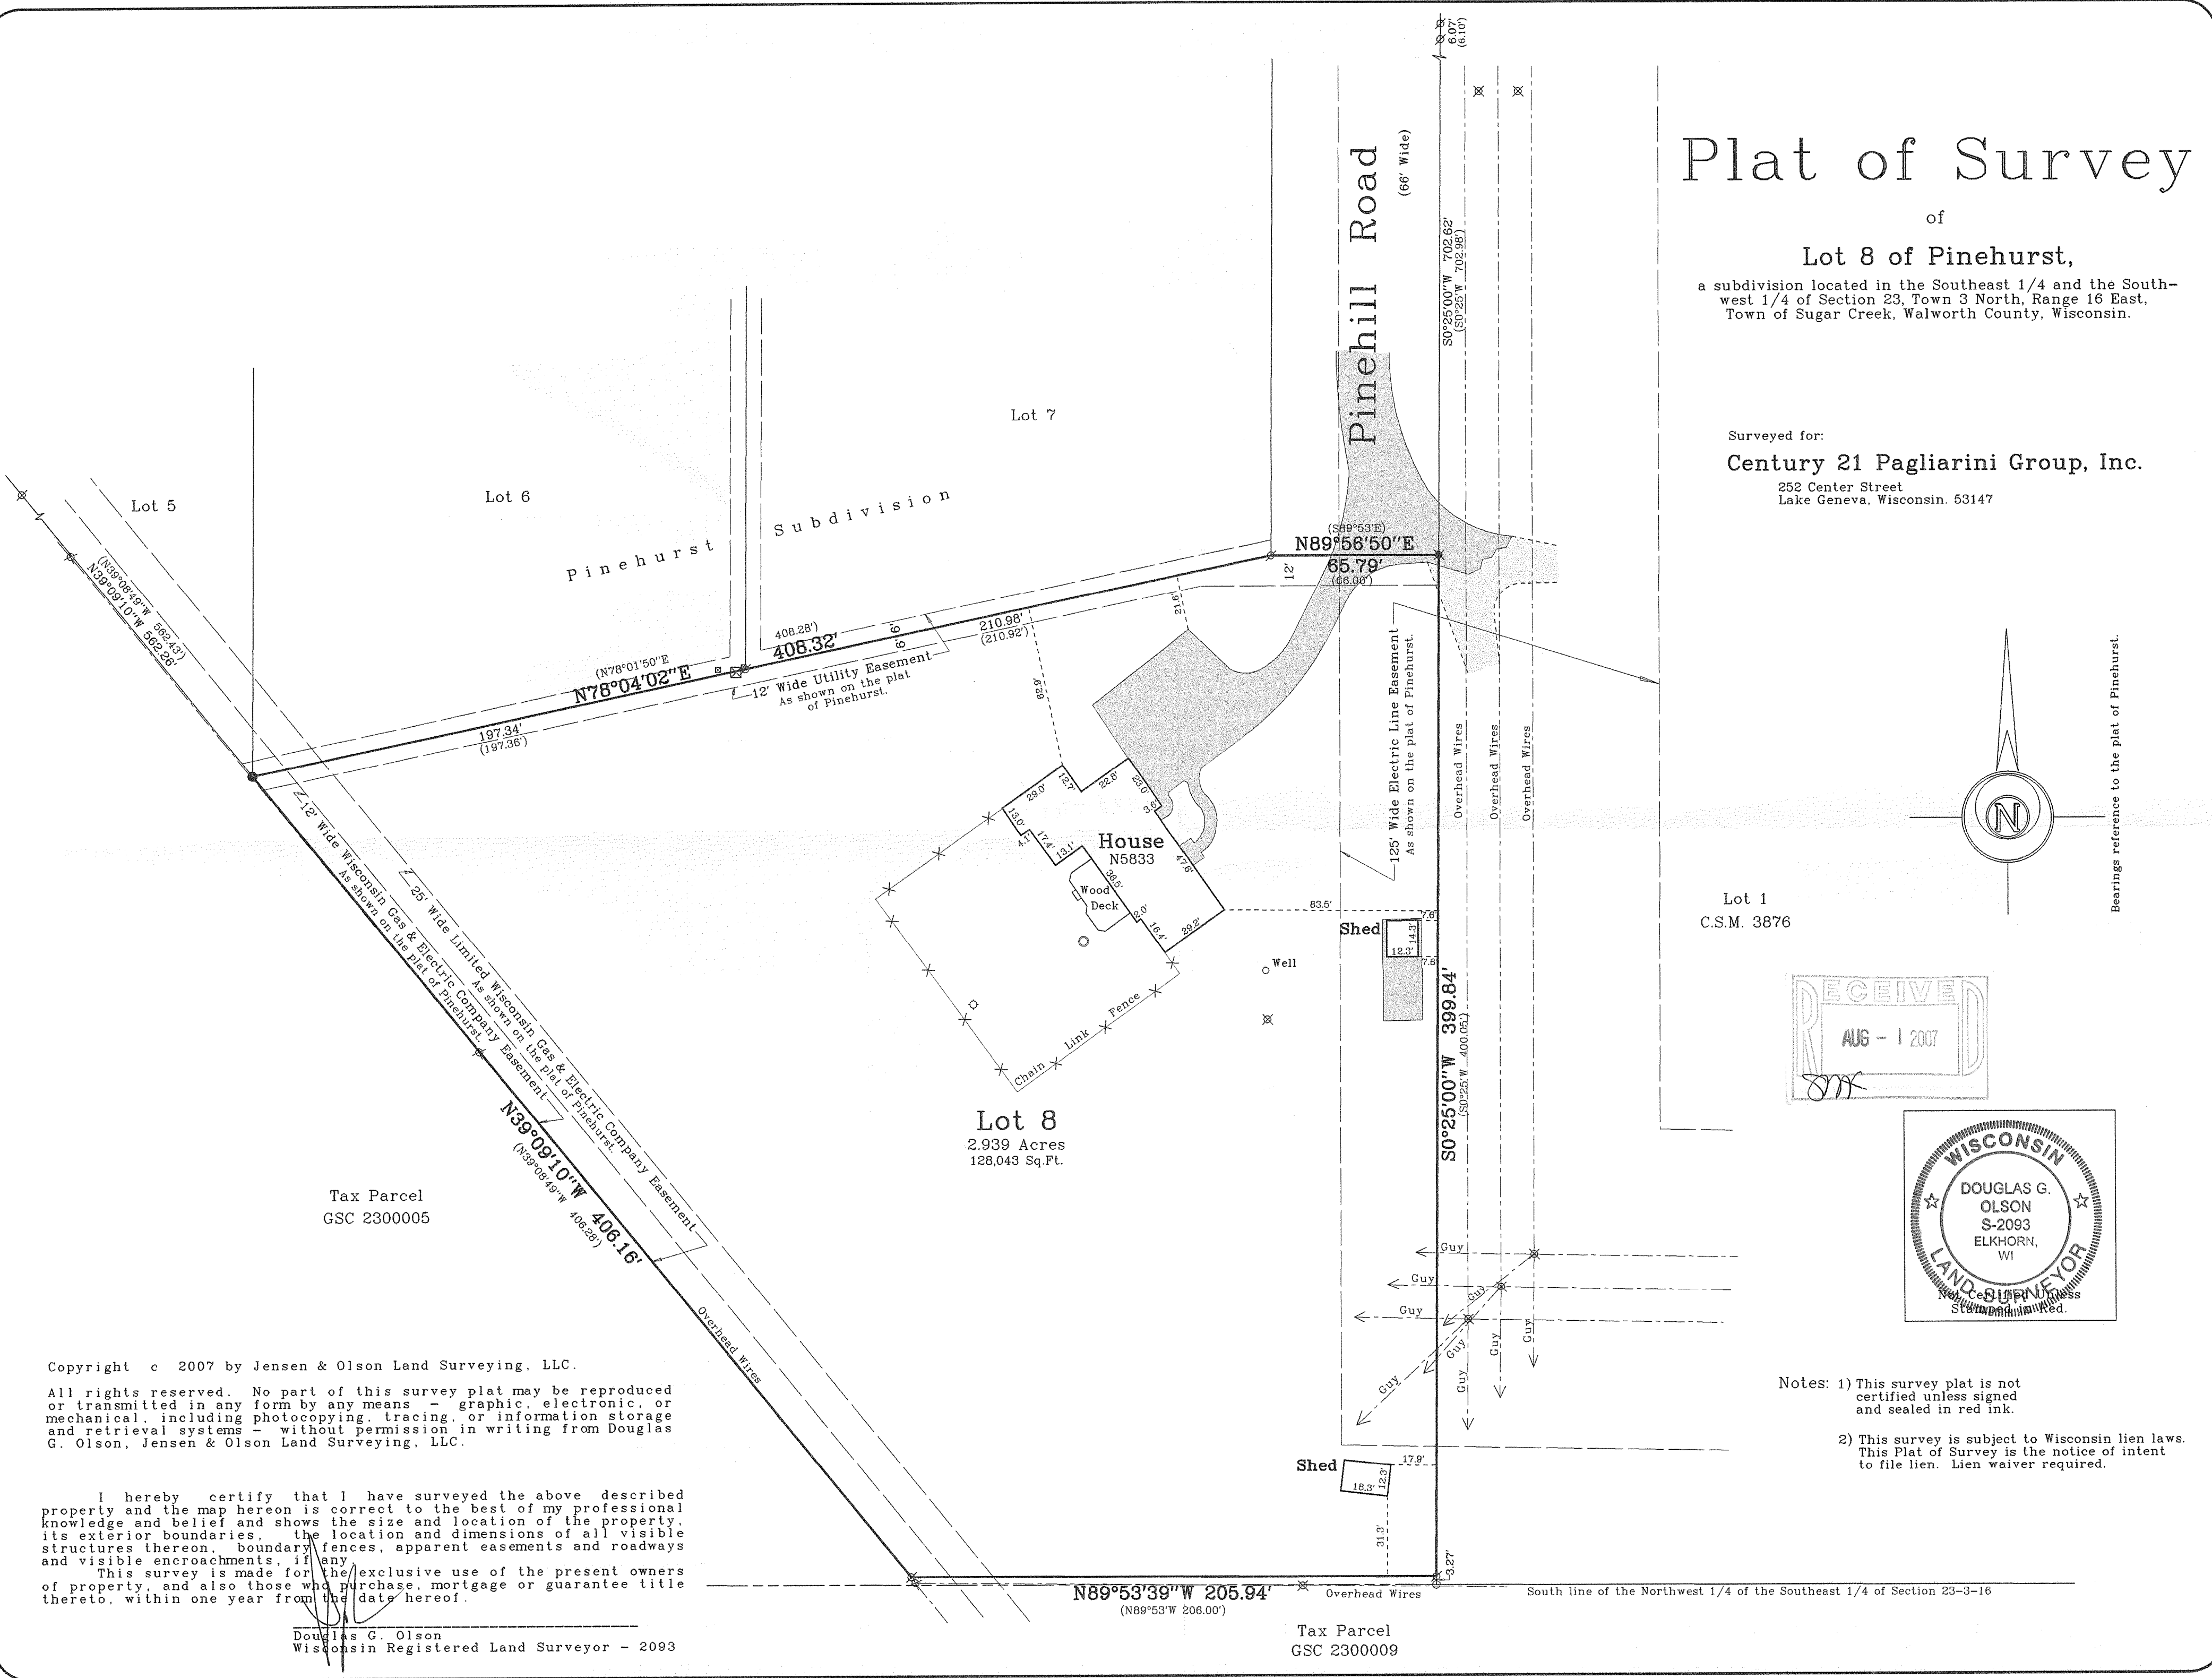


Plat of Survey

of
Lot 8 of Pinehurst,
a subdivision located in the Southeast 1/4 and the South-
west 1/4 of Section 23, Town 3 North, Range 16 East,
Town of Sugar Creek, Walworth County, Wisconsin.

Surveyed for:
Century 21 Pagliarini Group, Inc.
252 Center Street
Lake Geneva, Wisconsin. 53147

Survey Date: April 18, 2007.
Revisions:

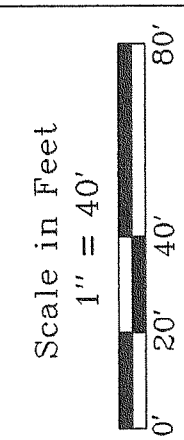

Jensen & Olson Land Surveying, LLC
45 South Wisconsin Street
Elkhorn, Wisconsin. 53121
Telephone (262) 723-3434
Facsimile (262) 723-8044

- Legend
- Found Iron Pipe
 - Found Iron Rod, 3/4" dia.
 - Set Spindle Information
 - Recorded Information
 - Utility Pole
 - Utility Pedestal
 - Asphalt Surface
 - Gravel

Sheet 1 of 1 Sheets
Job Reference Number
2007.032
2007.032

Copyright © 2007 by Jensen & Olson Land Surveying, LLC.

All rights reserved. No part of this survey plat may be reproduced or transmitted in any form by any means - graphic, electronic, or mechanical, including photocopying, tracing, or information storage and retrieval systems - without permission in writing from Douglas G. Olson, Jensen & Olson Land Surveying, LLC.

I hereby certify that I have surveyed the above described property and the map hereon is correct to the best of my professional knowledge and belief and shows the size and location of the property, its exterior boundaries, the location and dimensions of all visible structures thereon, boundary fences, apparent easements and roadways and visible encroachments, if any.
This survey is made for the exclusive use of the present owners of property, and also those who purchase, mortgage or guarantee title thereto, within one year from the date hereof.

Douglas G. Olson
Wisconsin Registered Land Surveyor - 2093

Tax Parcel
GSC 2300009

- Notes: 1) This survey plat is not certified unless signed and sealed in red ink.
2) This survey is subject to Wisconsin lien laws. This Plat of Survey is the notice of intent to file lien. Lien waiver required.

GPH-8

316-1931