## FARRIS, HANSEN & ASSOCIATES, INC.

ENGINEERING - ARCHITECTURE - SURVEYING 7 RIDGWAY COURT - P.O. BOX 437, ELKHORN, WISCONSIN, 53121

PHONE: (262) 723-2098

FAX: (262) 723-5886

PLAT OF SURVEY

- WORK ORDERED BY -JEFF ZIMMERMAN - ALL SEASONS HOME IMPROVEMENTS N 8359 ZIMMERMAN ROAD EAST TROY, WI 53120

## LOTS 15 AND 16 OF BLOCK 72 OF THE FIFTH MAP OF INTERLAKEN

LOCATED IN THE NW 1/4 OF SECTION 14. TOWN 3 NORTH, RANGE 16 EAST, TOWN OF SUGAR CREEK, WALWORTH COUNTY, WISCONSIN


**LEGEND** 

O = FOUND IRON PIPE STAKE

= SET IRON REBAR STAKE, 3/4" DIA. x 24" x 1.50 lbs./ft.

(XXX) = RECORDED AS

## DANDELION ROAD

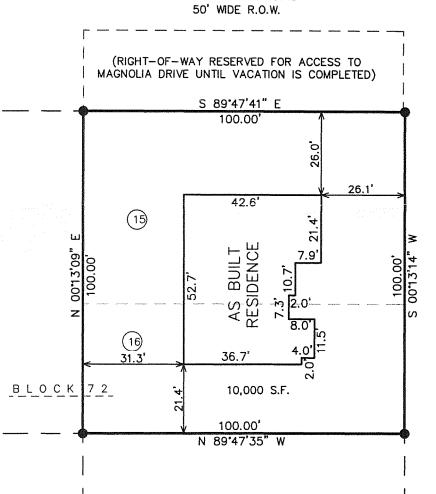

AUG 3 0 2007

100 100 50 40 30 20 80 70 60 MAP SCALE IN FEET ORIGINAL 1" = 30'

NOTE: COPIES OF THIS MAP TO WHICH THE FOLLOWING CERTIFICATE WILL APPLY SHOW THE SURVEYOR'S ORIGINAL SEAL AND SIGNATURE IN RED INK. COPIES BY ANY OTHER MEANS MAY HAVE ALTERATIONS WHICH DO NOT REPRESENT THE SURVEYOR'S WORK PRODUCT.

I HEREBY CERTIFY THAT THE ABOVE DESCRIBED PROPERTY HAS BEEN SURVEYED UNDER MY DIRECTION AND THAT THE ABOVE MAP IS A TRUE REPRESENTATION THEREOF AND SHOWS THE SIZE AND LOCATION OF THE PROPERTY AND ITS EXTERIOR BOUNDARIES. THIS SURVEY IS MADE FOR THE USE OF THE PRESENT OWNERS OF THE PROPERTY, AND ALSO THOSE WHO PURCHASE, MORTGAGE, OR GUARANTEE THE TITLE THERETO WITHIN ONE YEAR FROM THE DATE

> REVISED 06-25-2007 TO SHOW AS BUILT RESIDENCE

> > SEPTEMBER 28, 2005

DATED

PROJECT: 5015.72.15-16 DATE: 09/28/2005 SHEET: 1 OF 1

CORSING COMMING

PETER S.

GORDON

S-2101

ELKHORN, WI

PETER S. GORDON R.L.S. 2101

JUN 2 5 2007

ASSIGNED