
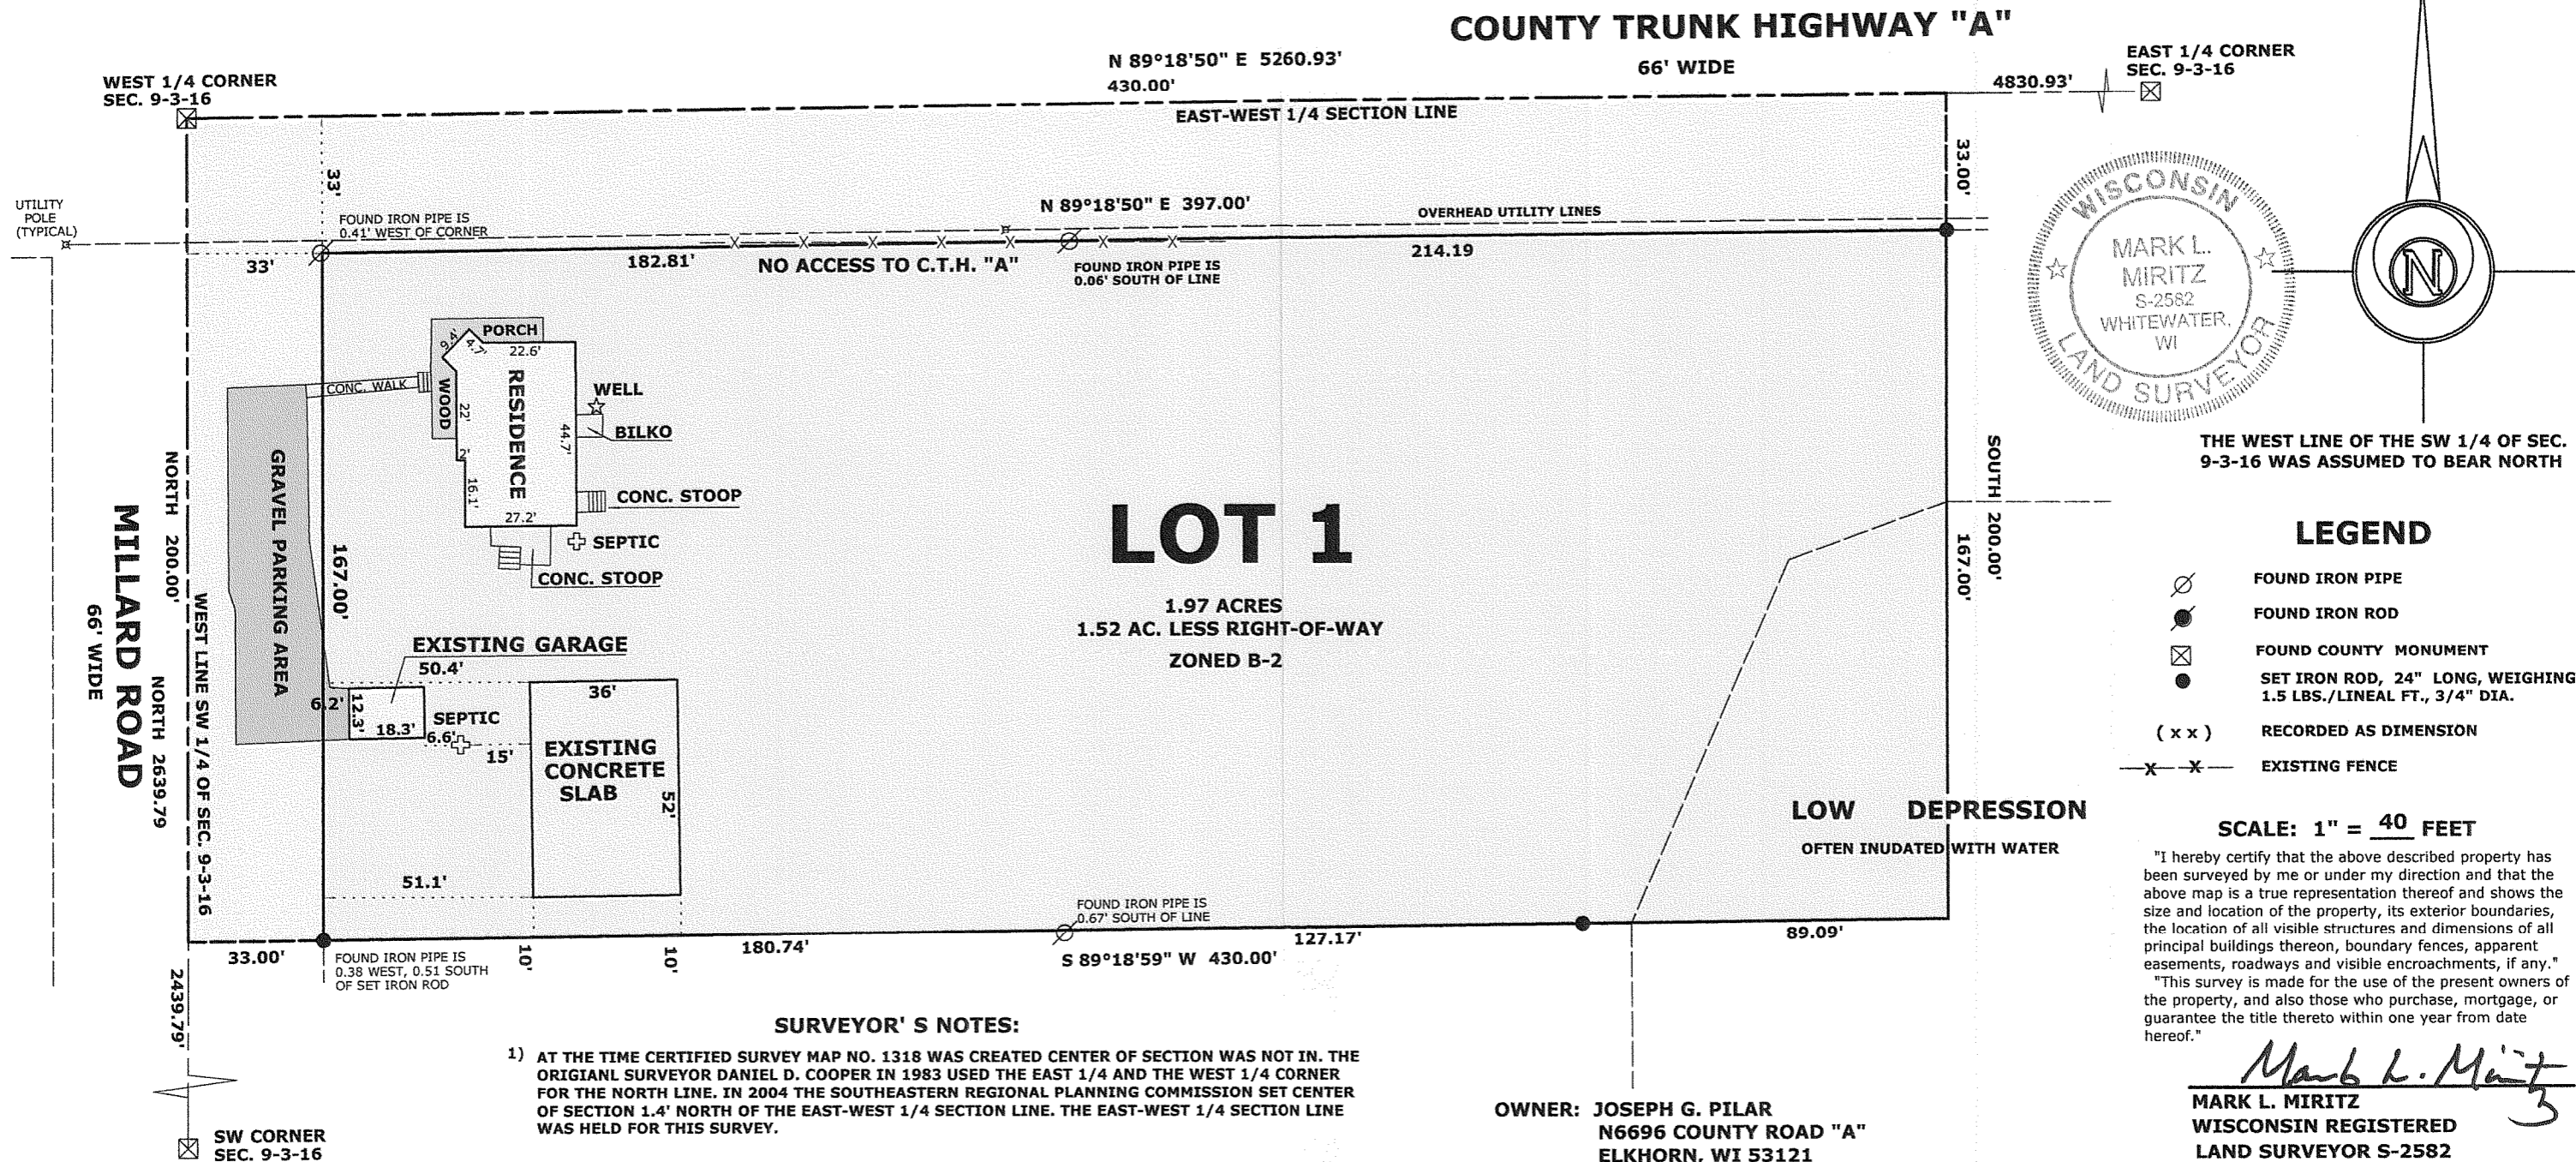


**Wisconsin Registered Land Surveyor S-2582**

**N9330 Knuteson Drive  
Whitewater, WI 53190  
Phone:(262)495-3284  
FAX : (262) 495-8421  
LAND-MARKSURVEYING.COM**

**LOT 1 OF CERTIFIED SURVEY MAP NO. 1318, LOCATED IN THE NORTHWEST 1/4 OF THE SOUTHWEST 1/4 OF SECTION 9, TOWN 3 NORTH, RANGE 16 EAST, SUGAR CREEK TOWNSHIP, WALWORTH COUNTY, WISCONSIN.**

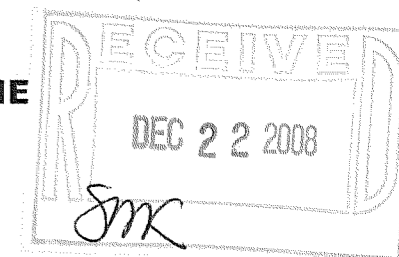

REVISED OCT. 14, 2008 TO SHOW CONCRETE SLAB "AS BUILT" DATE: MAY 19, 2008 JOB NO. 08.402

GA1318-1

316-2005