



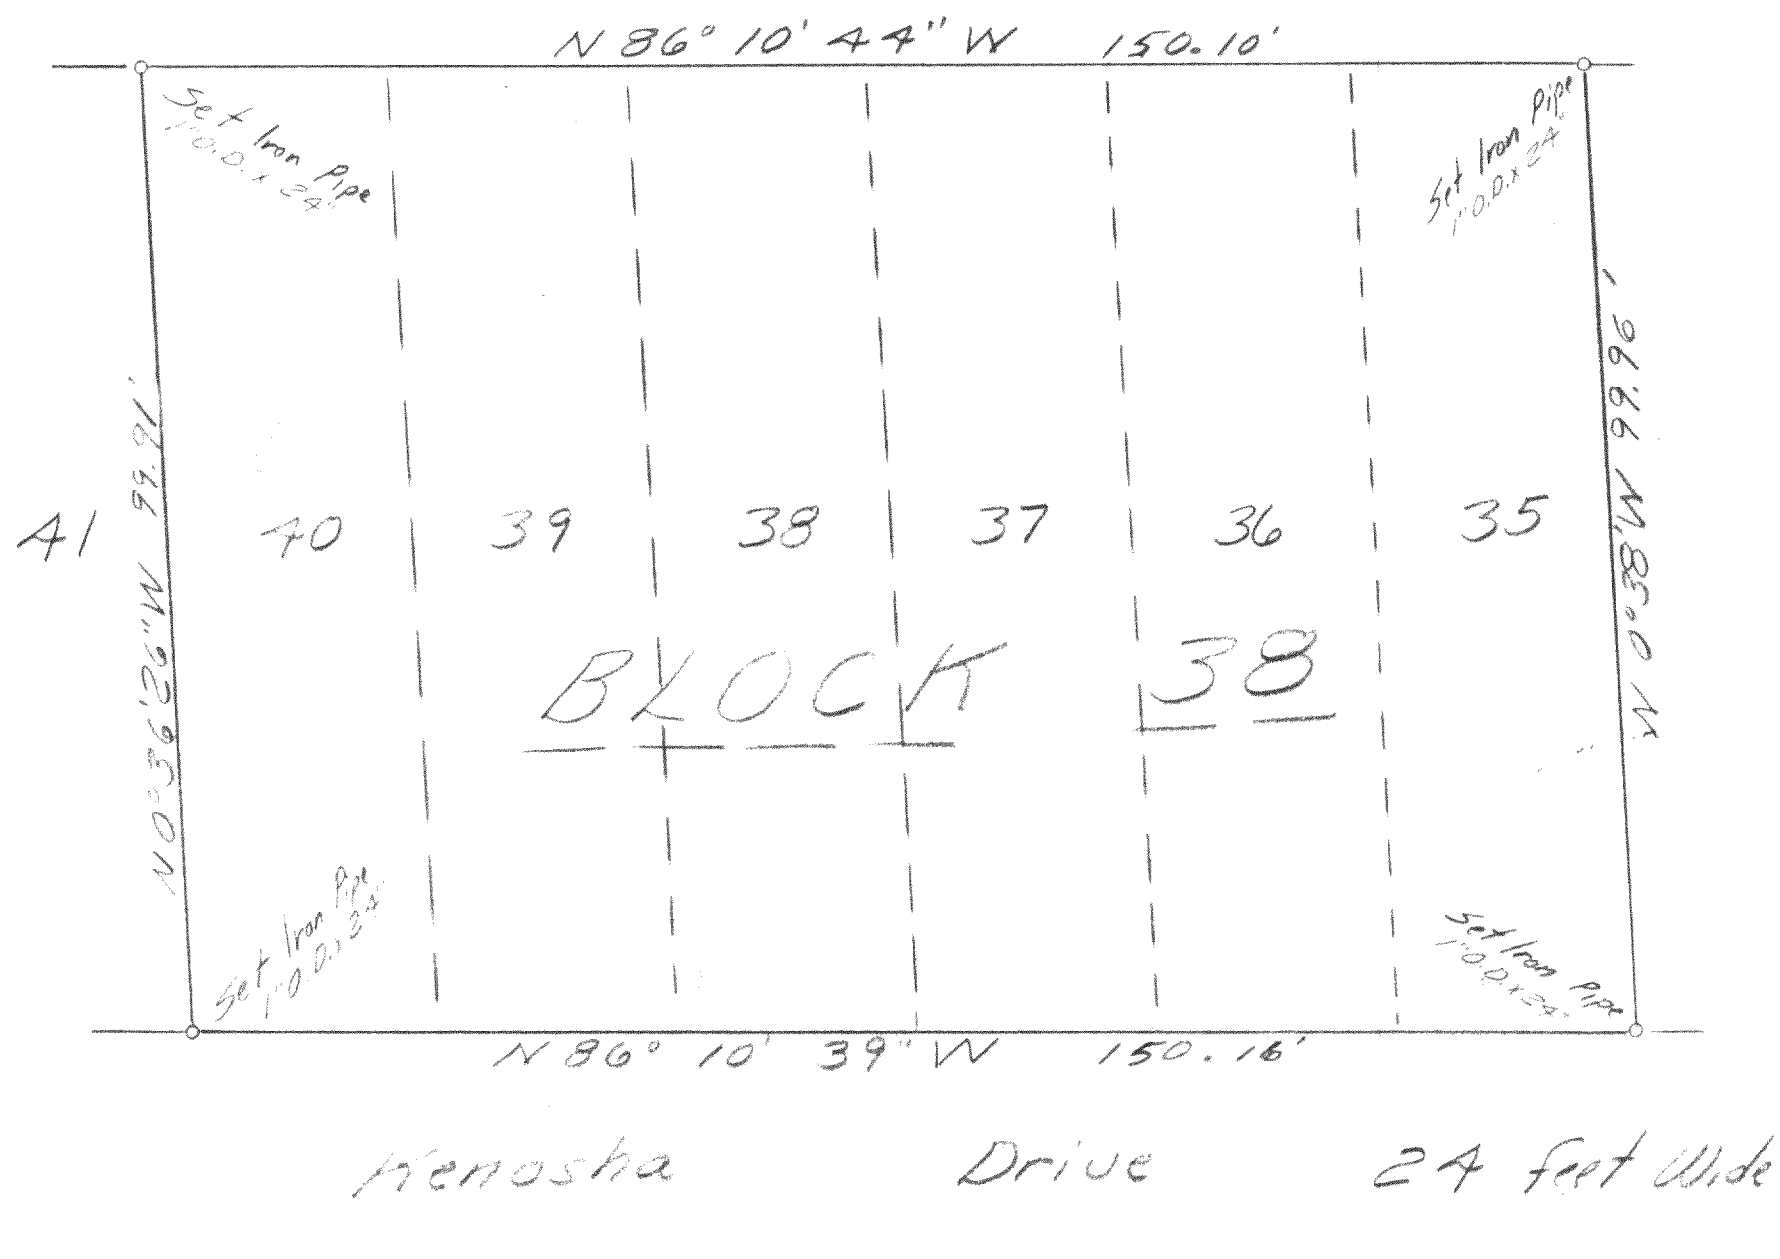

Jensen & Johnson
Elkhorn, Wisconsin

I, Thomas P.A. Jensen, surveyor, do hereby certify that under my direction the lands shown hereon have been surveyed and mapped, and that this plat of Survey is a true and accurate representation of the lot lines to the best of my knowledge and belief.

Dated this 21 day of Oct, 1976
Thomas P.A. Jensen S-1084

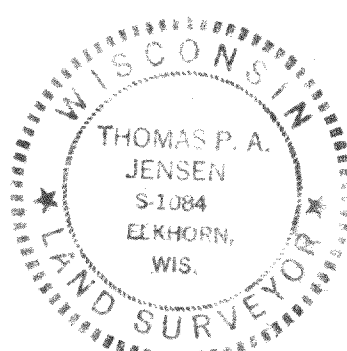

JOB #1658.080 #3
WORK ORDERED BY THOMAS GRZECZOWIAK

PLAT OF SURVEY OF

LOTS 35, 36, 37, 38, 39, & 40 OF BLOCK 38
OF LAKE WANDAWEGA SUBDIVISION LOCATED
IN THE NW 1/4 OF SE 1/4 OF SECTION 2, TOWN
3 NORTH, RANGE 16 EAST, WALWORTH COUNTY,
WISCONSIN

SCALE 1" = 20 feet

DATE 21 Oct 1976

GLW-16