

PREPARED FOR  
JEFF CARLS  
W5610 AMOS RD.  
ELKHORN WI. 53121


# PLAT OF SURVEY

-OF-

KROTT SURVEYING INC.

N3705 WILLOW BEND LANE  
LAKE GENEVA WI. 53147  
PHONE # (262)248-3697  
FAX # (262)249-0639

LOT 1 OF CERTIFIED SURVEY MAP NO. 3451, LOCATED IN THE SOUTHWEST 1/4 OF THE SOUTHWEST 1/4  
OF SECTION 35, TOWN 3 NORTH, RANGE 16 EAST, TOWN OF SUGAR CREEK, WALWORTH COUNTY, WISCONSIN.

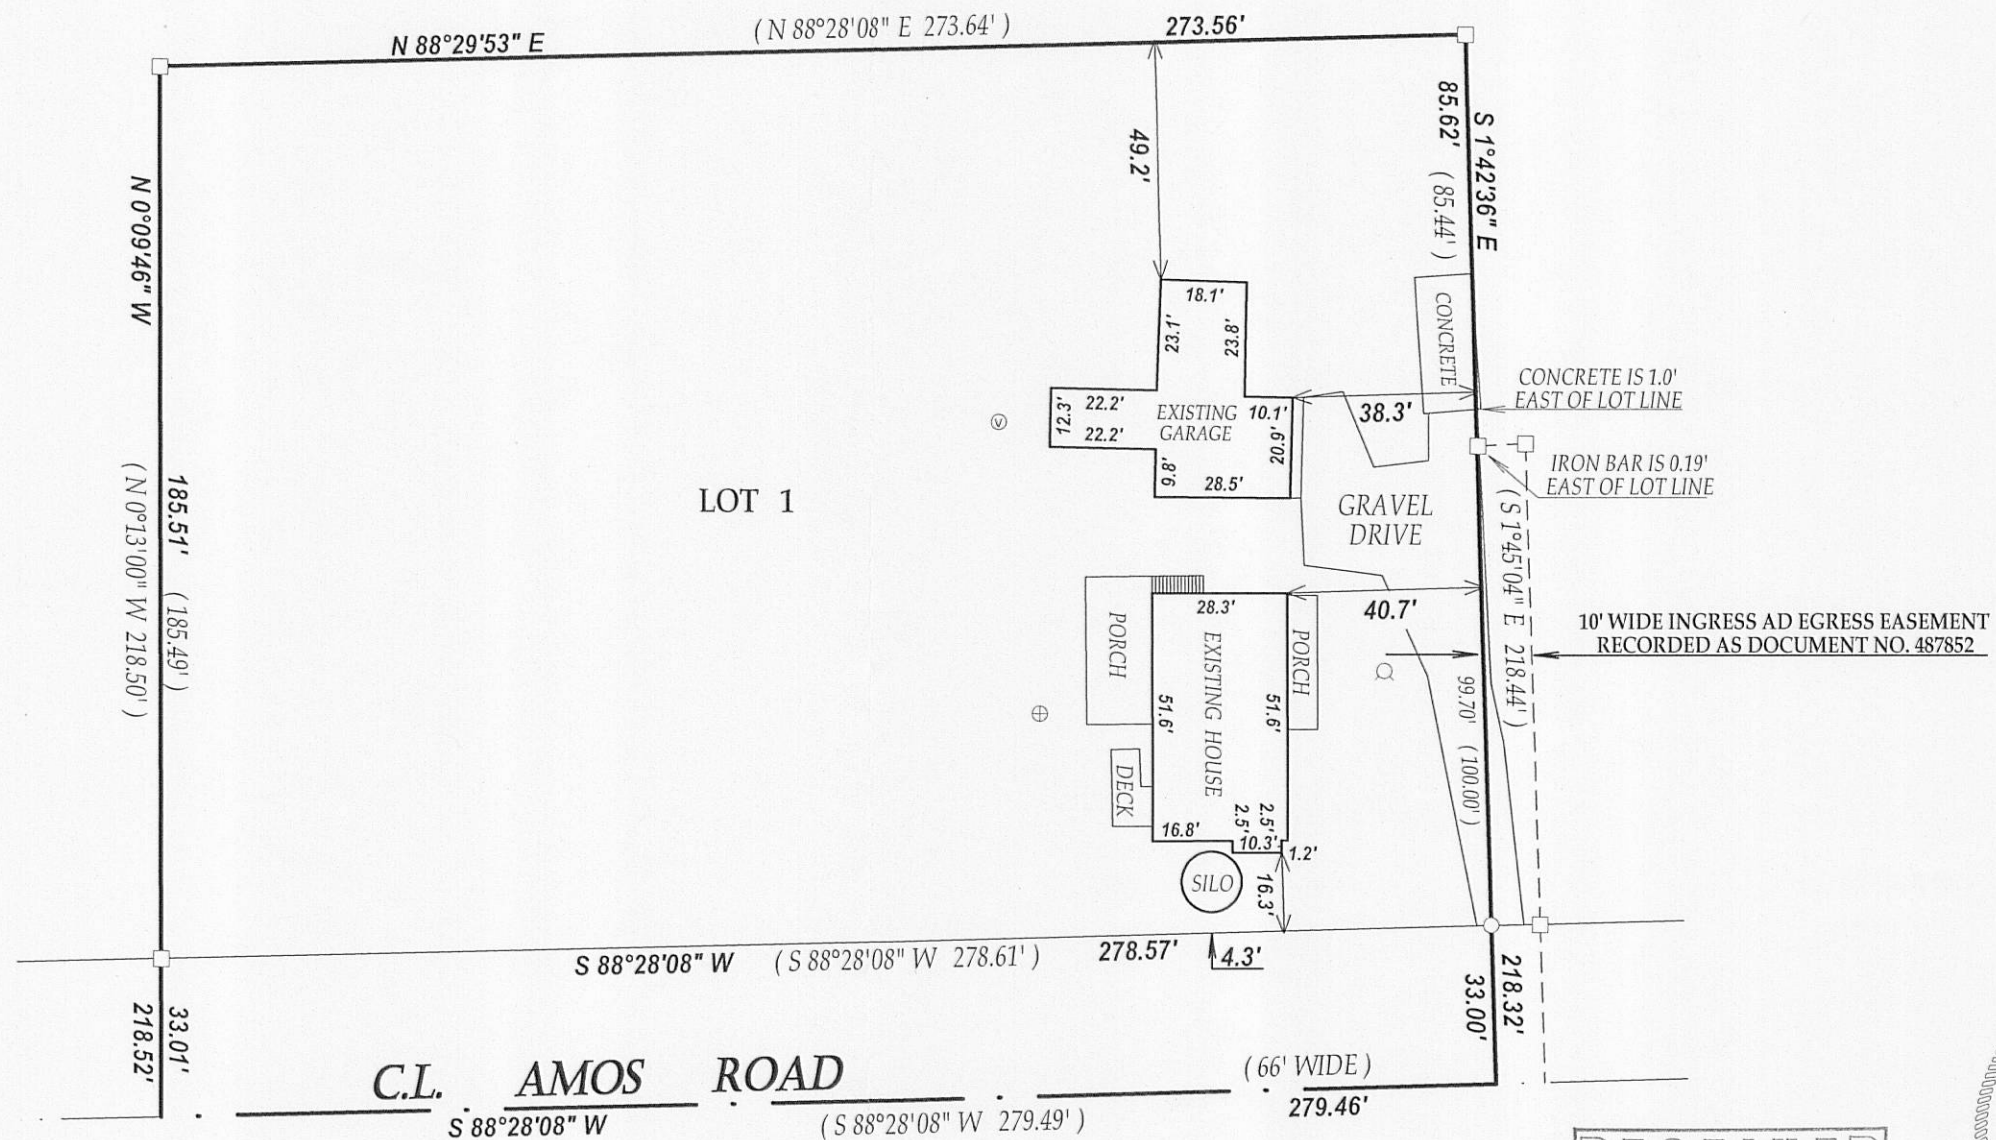

## LEGEND

- FOUND IRON PIPE
- FOUND IRON BAR
- ⊙ WELL
- ⊕ CONCRETE LID
- ⊙ VENT


(xx) RECORDED AS

TAX ID # GA345100001


JOB # 11-133

I have surveyed the above-described property and the above map is a true representation thereof and shows the size and location of the property, its exterior boundaries, the location and dimensions of all structures thereon, fences, apparent easements and roadways and visible encroachments, if any.



This survey is made for the exclusive use of the present owners of the property, and also those who purchase, mortgage, or insure the title thereto within one (1) year from date hereof; and as to them I warrant the accuracy of said survey map.

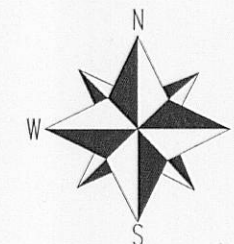

SCALE 1"=40'

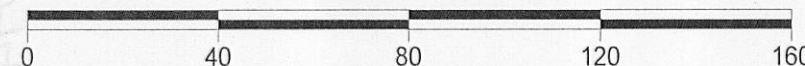

NOTE: BEARINGS ARE REFERENCED TO THE RECORD C.S.M.

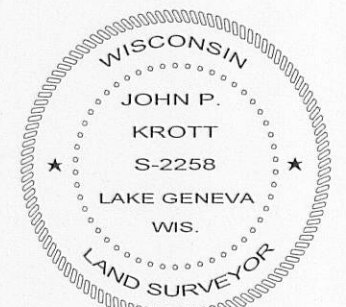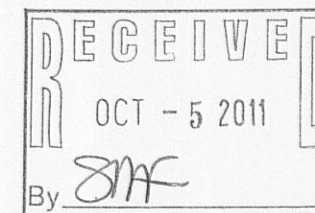

DATED THIS 15th DAY OF SEPTEMBER 2011.

*John P. Krott*  
JOHN KROTT S - 2258  
Wisconsin Registered Land Surveyor  
(original if signed in red)

316 - 2094