


LAND-MARK SURVEYING
Mark L. Miritz
Wisconsin Registered Land Surveyor S-2582

N9330 Knuteson Drive
Whitewater, WI 53190
Phone: (262) 495-3284
FAX: (262) 495-8421
LAND-MARKSURVEYING.COM

PLAT OF SURVEY

LOT 10 AND LOT 11 OF CHARL-MAR SUBDIVISION, LOCATED IN THE
NORTHWEST 1/4 OF THE NORTHEAST 1/4 OF SECTION 1, TOWN 3 NORTH,
RANGE 16 EAST, SUGAR CREEK TOWNSHIP, WALWORTH COUNTY,
WISCONSIN.

ORDERED BY: CONNIE POGGENSEE
THE RAULAND AGENCY
118 KENOSHA STREET
WALWORTH, WI 53184

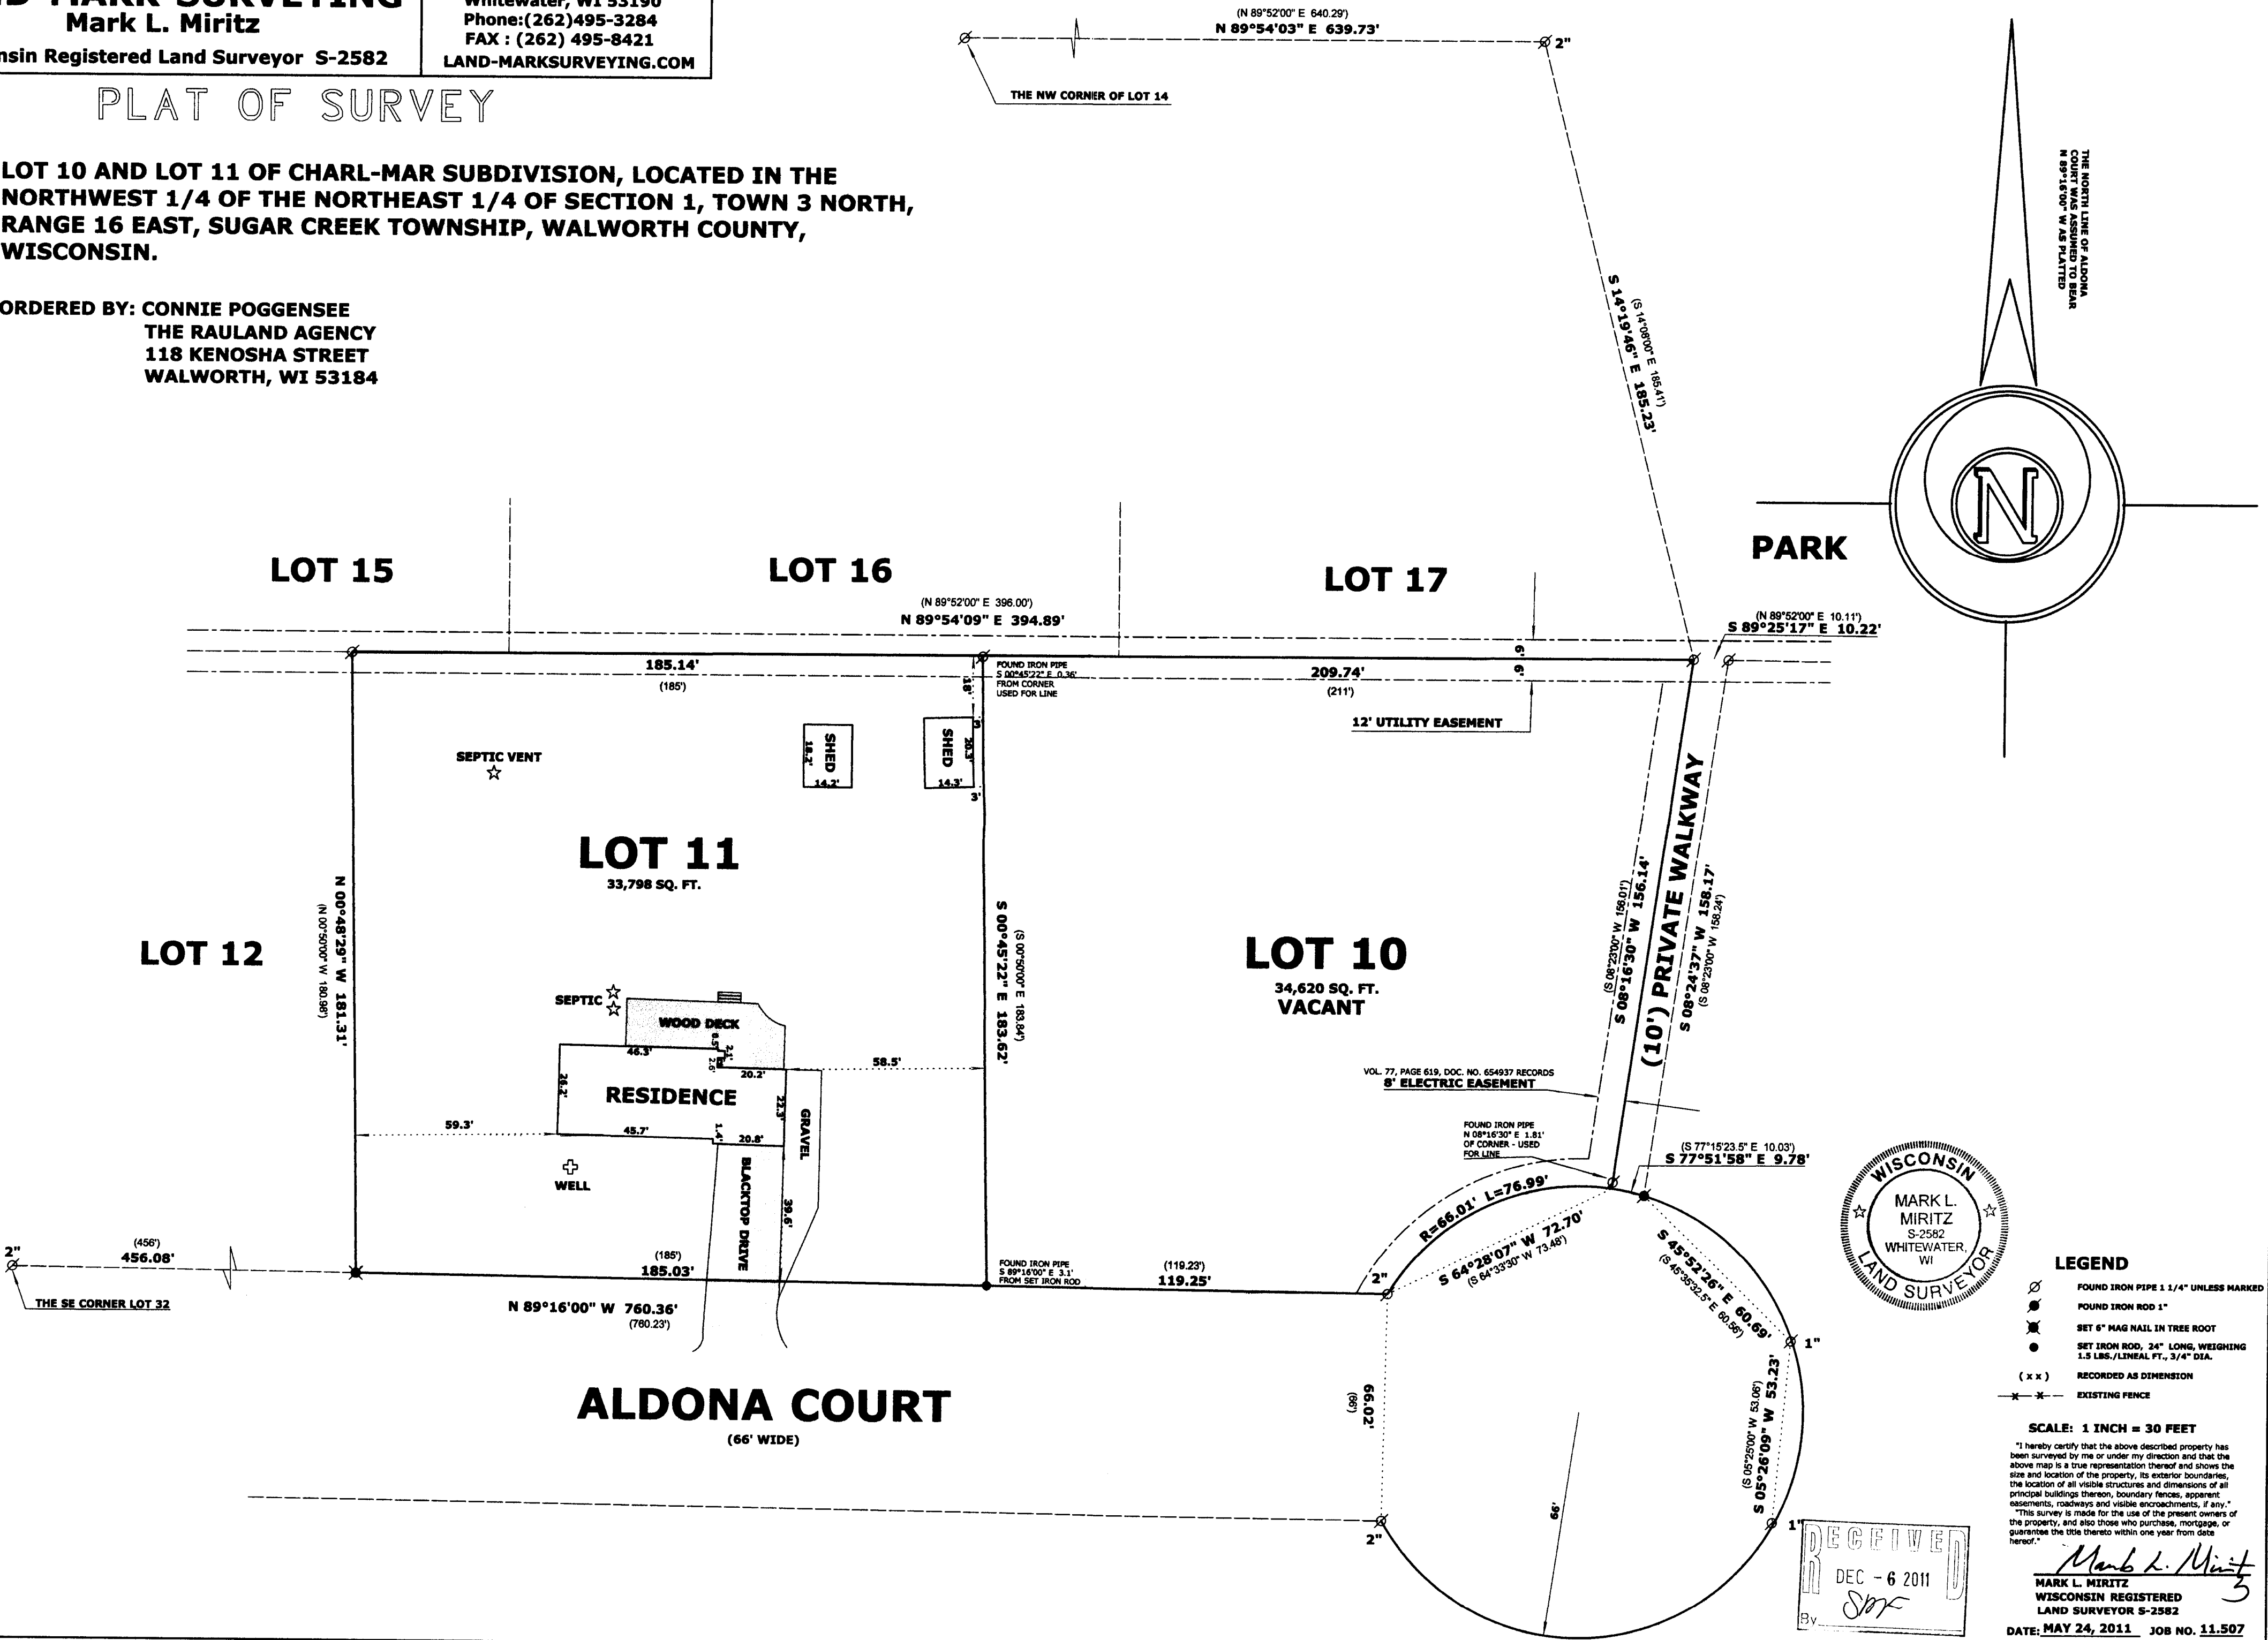

GCH-10 GCH-11

316-2097