

Plat of Survey


of
Lots 8, 21 and the Reserved Lot in Block 75
in the 5th Map of Interlaken,

a subdivision located in the Northwest 1/4 of Section 14, Town 3 North,
Range 16 East, Town of Sugar Creek, Walworth County, Wisconsin.



EXCEPTING therefrom the North 8 feet.

Surveyed for: **Rebuild & Restore, LLC.**

N6884 Avataia Trail
Elkhorn, Wisconsin. 53121

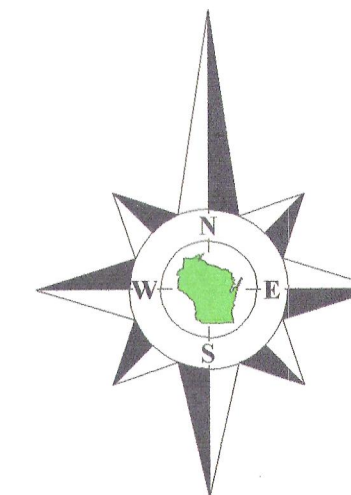

Bearings reference to previous
surveys of record.

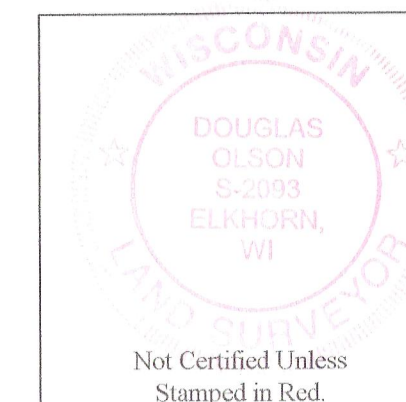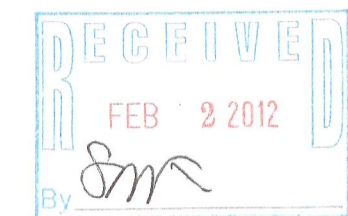

Notes:

- 1) This survey plat is not certified unless signed and sealed in red ink.
- 2) This survey is subject to Wisconsin lien laws. This Plat of Survey is the notice of intent to file lien. Lien waiver required.

Copyright 2011 by Jensen & Olson Land Surveying, LLC.

All rights reserved. No part of this survey plat may be reproduced or transmitted in any form by any means - graphic, electronic, or mechanical, including photocopying, tracing, or information storage and retrieval systems - without permission in writing from Douglas G. Olson, Jensen & Olson Land Surveying, LLC.

I hereby certify that I have surveyed the above described property and the map hereon is correct to the best of my professional knowledge and belief and shows the size and location of the property, its exterior boundaries, the location and dimensions of all visible structures thereon, boundary fences, apparent easements and roadways and visible encroachments, if any.

This survey is made for the exclusive use of the present owners of the property, and also those who purchase, mortgage or guarantee title thereto, within one year from the date hereof.

Douglas G. Olson
Wisconsin Registered Land Surveyor - 2093

Renamed, see Doc. No. 526337.

(Evergreen Road)

Babcock Road

(50' Wide)

S89°47'29"E 119.97'

Culvert (60')

Lot 8

House Under Construction

"Reserved Lot"

Reservation for "WATER SUPPLY AND PLAYGROUND PURPOSES" restriction has been removed by Affidavit of Correction recorded October 21, 2011, as Doc. No. 824396.

Tax Parcel GI 00658B

0.529 Acre
23,037 Sq.Ft.

Lot 21

B l o c k 7 5

Utility Easement
Recorded April 11, 2003,
in Doc. No. 551694.

See Application to Vacate
Doc. No. 381669.

Unimproved

Fern Road

Also
Utility Easement
Recorded Sept. 23, 2003,
in Doc. No. 576808.

(50' Wide)

10' Common Force Main Area
Doc. No. 576808.

Edge of mown grass
Edge of corn field

N89°45'50"W 119.96'

Approximate location of Unit 40
Doc. No. 576808.

Approximate location of Unit 41
Doc. No. 576808.

Approximate location of Unit 43
Doc. No. 576808.

Survey Date: Sept. 16, 2011.
Revisions: No. 1 - Proposed House
No. 2 - House under construction

Scale in Feet
1" = 20'
0' 10' 20' 40'

Jensen & Olson Land Surveying, LLC

45 South Wisconsin Street * P.O. Box 322 * Elkhorn, Wisconsin. 53121
Telephone: (262) 723-3434 * Facsimile: (262) 723-8044
Email: jensen.olson@elknet.net

Legend
● Found Iron Rod
() Recorded Information
⊠ Utility Box or Pedestal
◇ PVC Vent or Cap
▨ Asphalt Surface
▩ Concrete Surface
▧ Gravel Surface

Sheet 1 of 1 Sheets
Drawing Name: D:\ar\6-2011\114-2011\114Plat.sjg
Job Reference Number
2011.114

2011.114

GI 658B

316-2104