

PLAT OF SURVEY
OF
SCHWABE FARM


LOCATED IN THE SW 1/4 AND NW 1/4 OF SECTION 12 AND THE NE 1/4 AND SE 1/4
OF SECTION 11, TOWN 3 NORTH, RANGE 16 EAST, WALWORTH COUNTY, WISCONSIN

DESCRIPTION

A parcel of land located in the SW 1/4 and the NW 1/4 of Section 12 and the NE 1/4 and the SE 1/4 of Section 11, Town 3 North, Range 16 East, Walworth County, Wisconsin.


Beginning at the SW corner of said Section 12; thence S 89°47'19" E, 242.38 feet (recorded as East 236.85 feet); thence N 0°23'22" W, 241.02 feet (recorded as N 1°15' W); thence S 88°47'13" E (recorded as West), 241.02 feet to the centerline of Stallman Road; thence N 0°23'22" W along the centerline of said road which is parallel to the North-South 1/4 Section line of Section 12, 2922.25 feet; thence S 57°11'29" W, 350.80 feet; thence N 0°23'22" W, 360.99 feet to the centerline of County Hwy. "A"; thence S 57°11'29" W along the said centerline, 952.46 feet; thence S 56°59'03" W, 813.76 feet to the Easterly line of Interlaken No. 2 Subdivision; thence S 0°21'43" E along the Easterly line of said Subdivision, 1183.53 feet; thence S 89°36'32" W along said Subdivision Southerly line 419.23 feet; thence S 71°31'21" W, along the Southerly line of said Subdivision, 605.42 feet to the centerline of County Trunk Hwy. "B"; thence along the centerline of said road S 31°43' E, 691.70 feet to the point of curvature; thence continue S 31°43' E, 149.06 feet along the tangent of said curve to an iron pipe on a meander line, said iron pipe located N 31°43' W, 24 feet more or less from the shore of Silver Lake; thence along the said meander line S 83°33'00" E, 232.82 feet; thence N 83°10'36" E, along said meander line 319.72 feet to the end of said meander line located N 0°29'45" W, 12 feet more or less from the shore of Silver Lake; thence N 0°29'45" W, 33.13 feet to the point of curvature on the centerline of said Hwy.; thence Easterly 241.45 feet along the arc of a curve to the right having a radius of 109.11 feet and long chord which bears S 77°27'08.5" E, 237.42 feet; thence S 59°16'08" E, 223.12 feet to the point of curvature; thence Southeasterly 511.87 feet along the arc of a curve to the left having a radius of 109.11 feet and a chord which bears S 73°47'35.5" E, 506.40 feet; thence S 88°19'03" E, 418.97 feet to the point of beginning. Also, all the land between the above described meander line and the shore of Silver Lake.

The above described property has been surveyed under my direction and the plat shown is an accurate survey and a true representation thereof and correctly shows the exterior boundary lines and all divisions of said property to the best of my knowledge and belief.

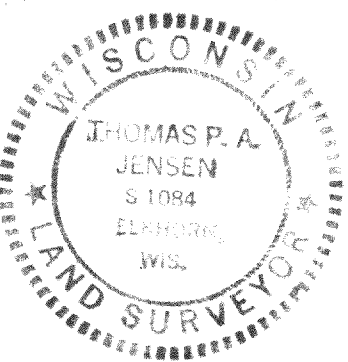


Thomas P. A. Jensen
Elkhorn, Wisconsin

131.42 AC.

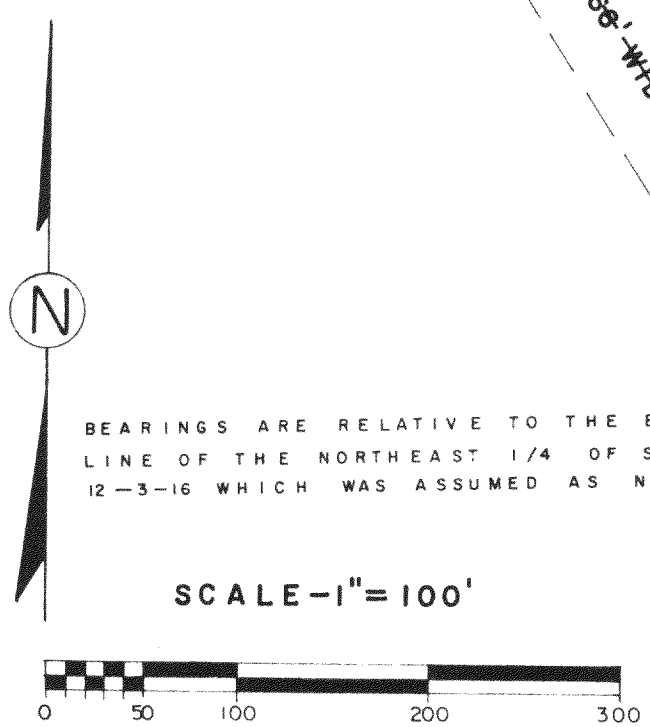

LEGEND

- - STONE OR CONCRETE MONUMENT
- - CONCRETE MONUMENT
- - 1 3/8" IN DIA. ROUND IRON BAR 30" LONG 3.77 LB./LIN. FT.
- - 3/4" IN DIA. ROUND IRON BAR 30" LONG 1.26 LB./LIN. FT.
- - P.K. NAIL
- - IRON PIPE FOUND

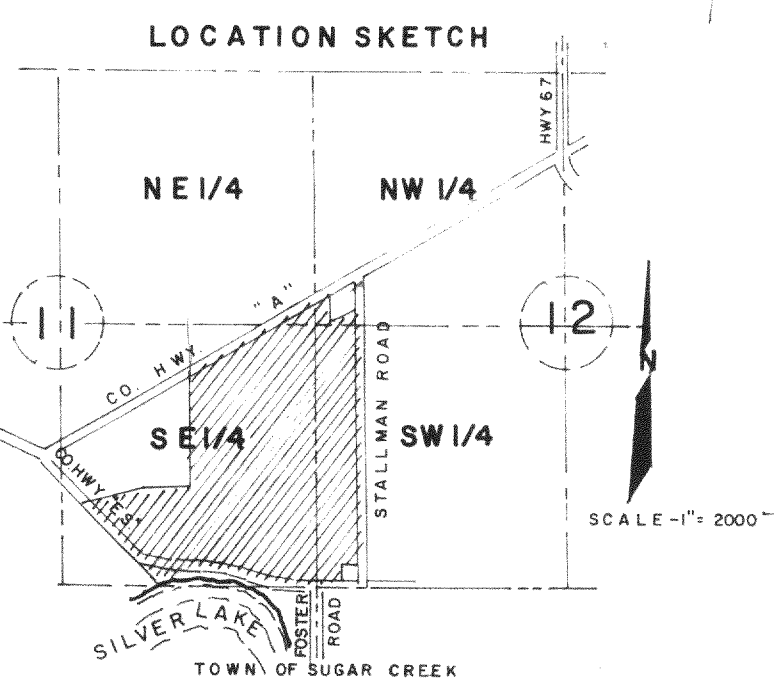

PREPARED BY
JENSEN & JOHNSON, INC.
ELKHORN, WIS.

