



# PLAT OF SURVEY LOT 7 GRANVILLE ESTATES, A SUBDIVISION

PART OF THE NE 1/4 SECTION 34  
TOWN 3 NORTH, RANGE 16 EAST  
WALWORTH COUNTY, WISCONSIN

Legal Description:  
Lot 7, Granville Estates, a subdivision located in the Southwest 1/4 and Southeast 1/4 of the Northeast 1/4 of Section 34, Township 3 North, Range 16 East, Town of Sugar Creek, Walworth County, Wisconsin.  
  
For Informational Purposes Only:  
Address: N5155 Granville Ct., Elkhorn, WI 53121  
Parcel Identification No. GGR 00007

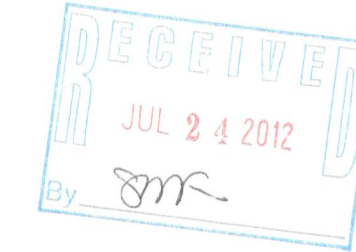

LOT 8

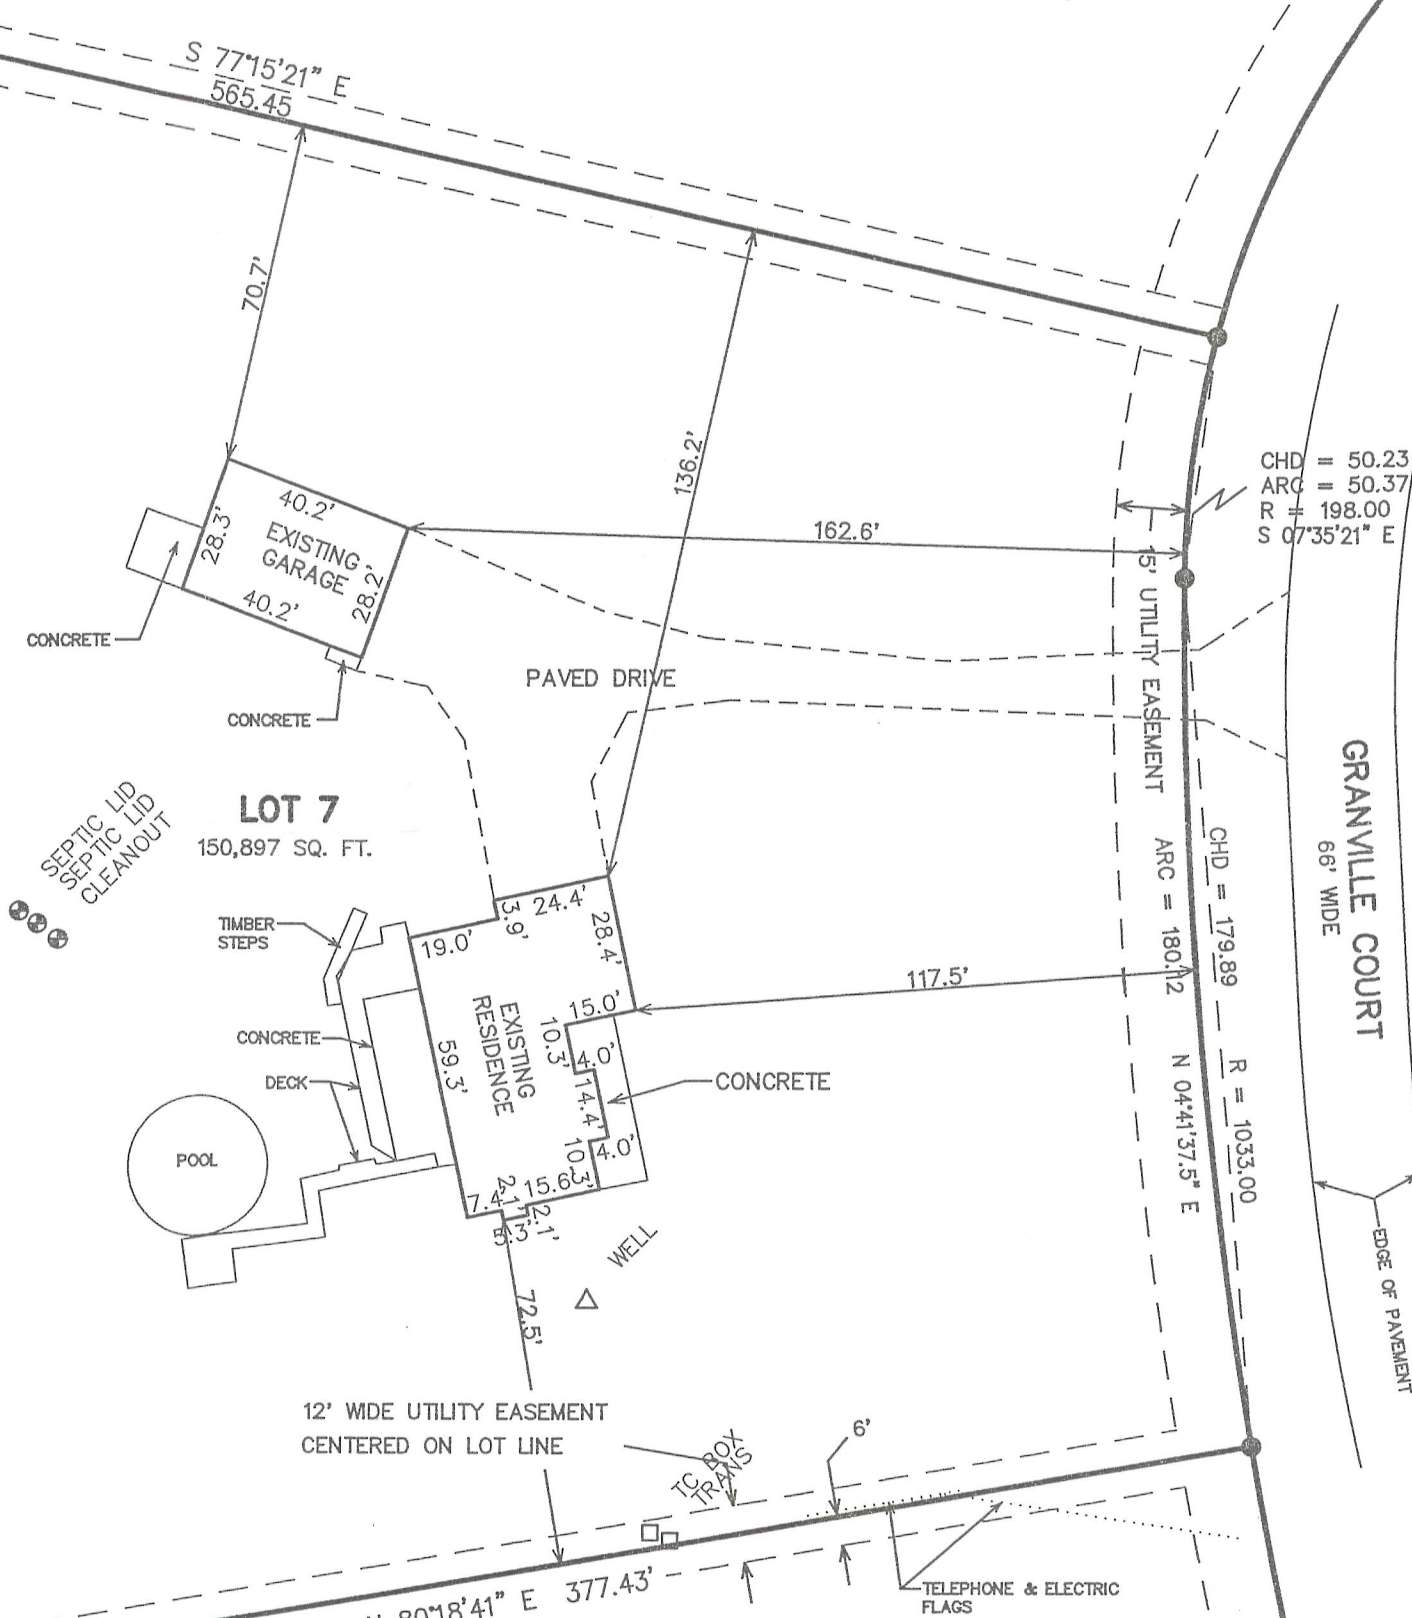


LEGEND  
● = FOUND IRON REBAR STAKE  
(xxx) = RECORDED AS

NOTE: COPIES OF THIS MAP TO WHICH THE FOLLOWING CERTIFICATE WILL APPLY SHOW THE SURVEYOR'S ORIGINAL SEAL AND SIGNATURE IN RED INK. COPIES BY ANY OTHER MEANS MAY HAVE ALTERATIONS WHICH DO NOT REPRESENT THE SURVEYOR'S WORK PRODUCT.


I HEREBY CERTIFY THAT THE ABOVE DESCRIBED PROPERTY HAS BEEN SURVEYED UNDER MY DIRECTION AND THAT THE ABOVE MAP IS A TRUE REPRESENTATION THEREOF AND SHOWS THE SIZE AND LOCATION OF THE PROPERTY, ITS EXTERIOR BOUNDARIES, THE LOCATION OF ALL VISIBLE STRUCTURES, AND DIMENSIONS OF ALL PRINCIPLE BUILDINGS THEREON, BOUNDARY FENCES, APPARENT EASEMENTS, ROADWAYS, AND VISIBLE ENCROACHMENTS, IF ANY. THIS SURVEY IS MADE FOR THE USE OF THE PRESENT OWNERS OF THE PROPERTY, AND ALSO THOSE WHO PURCHASE, MORTGAGE, OR GUARANTEE THE TITLE THERETO WITHIN ONE YEAR FROM THE DATE HEREOF.

DATED: JUNE 25, 2012

PETER S. GORDON  
LAND SURVEYOR

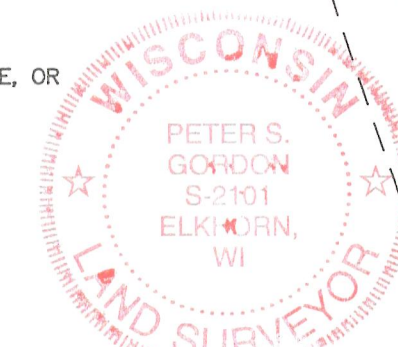

MAP SCALE IN FEET ORIGINAL 1" = 40'

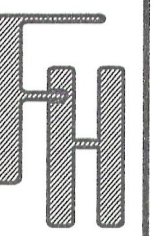

WORK ORDERED BY: TOM KIELTY  
N5155 GRANVILLE COURT  
ELKHORN, WI 53121

FARRIS, HANSEN & ASSOCIATES, INC.  
Engineering, Architecture, Surveying  
7 Ridgeway Court P.O. Box 437  
ELKHORN, WISCONSIN 53121  
Office: (414) 723-2098  
Fax: (414) 723-5886

REVISIONS  
06-25-2012  
RESURVEY

PROJECT NO.  
4872.7  
DATE:  
12-27-00  
SHEET NO.  
1 OF 1

316-2120

GGR-7