

PREPARED FOR
KATHY WEBER
KEEFE REAL ESTATE
LAKE GENEVA WI.


PLAT OF SURVEY

- OF -
LOT 6 PINEHURST, A SUBDIVISION LOCATED IN THE NW 1/4
OF THE SE 1/4 AND THE NE 1/4 OF THE SW 1/4 OF SECTION 23,
TOWN 3 NORTH, RANGE 16 EAST, TOWN OF SUGAR CREEK,
WALWORTH COUNTY, WISCONSIN.


PATHFINDER SURVEYING INC.
(formerly)
J.K. SURVEYING INC.
P.O BOX 322
LAKE GENEVA, WI. 53147
WWW.PATHFINDERSURVEYING.NET
262-248-8303

EVERGREEN ROAD

(PLATTED AS 66' WIDE)

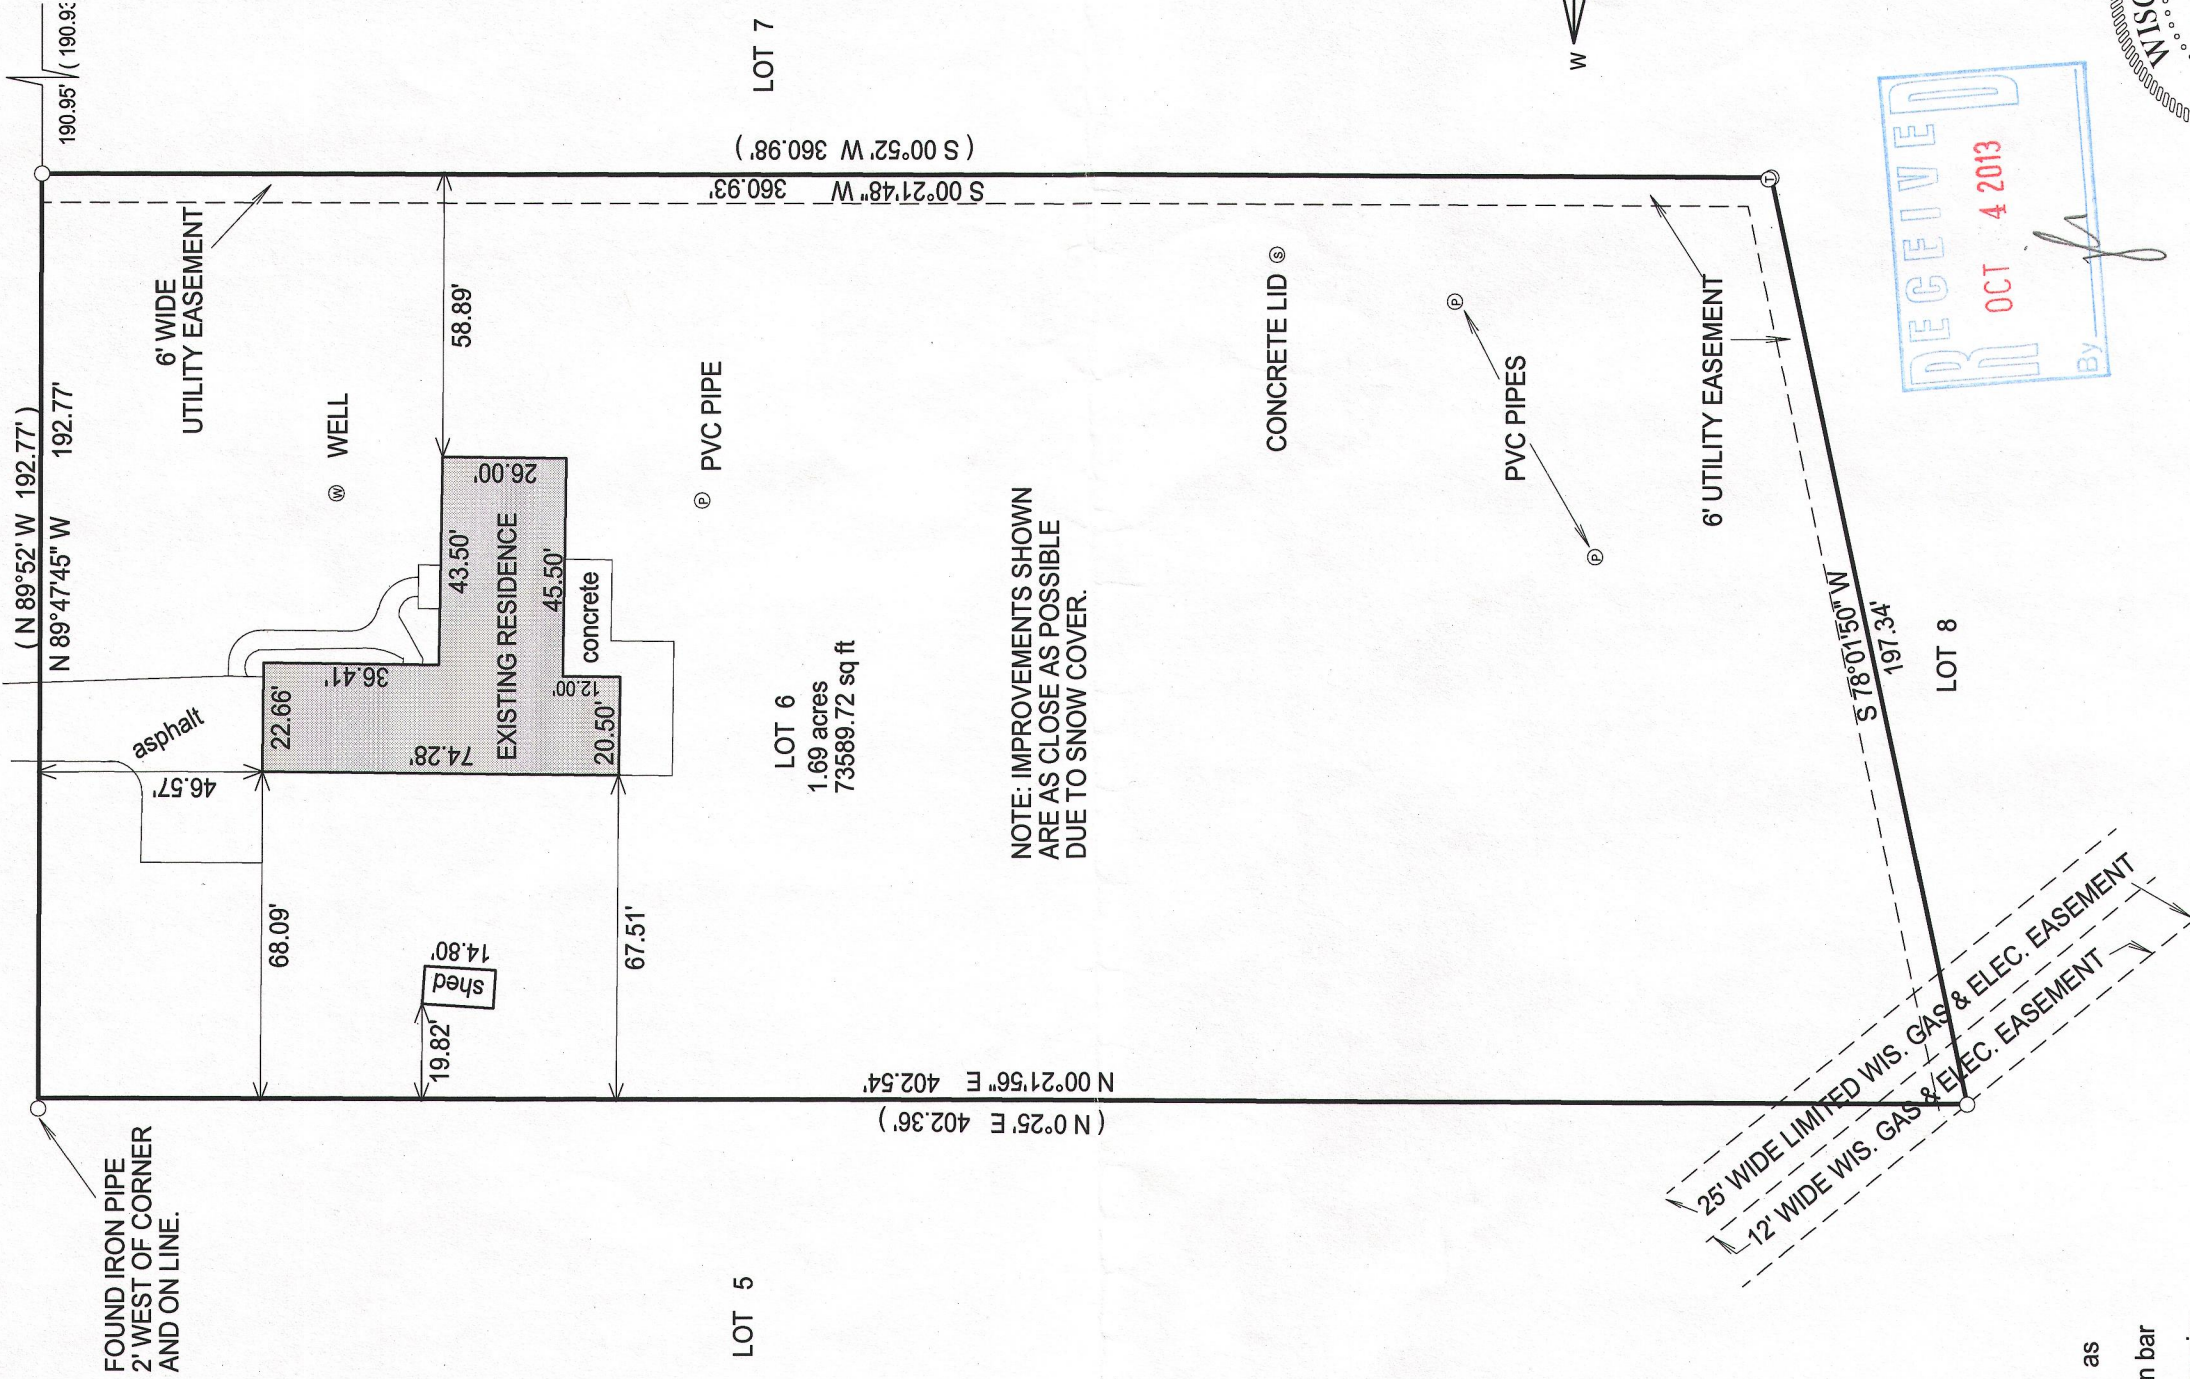

NOTE: IMPROVEMENTS SHOWN
ARE AS CLOSE AS POSSIBLE
DUE TO SNOW COVER.

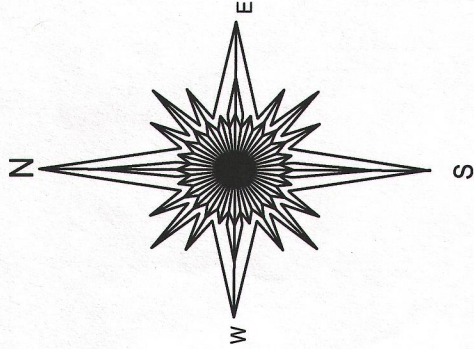


- () = recorded as
- = found iron bar
 - = found iron pipe
 - = set iron pipe
 - = set iron bar

SCALE 1" = 20'

JOB # 13-05

TAX ID #

GPH 00006

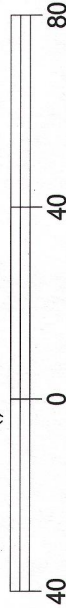

BASIS OF BEARING OF THIS PLAT: THE SOUTH LINE OF LOT 6
PINEHURST WAS ASSUMED TO BEAR S78°01'50" W AS SHOWN
ON THE RECORD PLAT.

I hereby certify that I have surveyed the above- described property and the
above map is a true representation thereof and shows the size and
location of the property, its exterior boundaries, the location and
dimensions of all structures thereon, fences, apparent easements and
roadways and visible encroachments if any.

This survey is made for the present owners of the property, and those who
purchase, mortgage, or guarantee the title thereto, within one year from
the date hereof.

DATED THIS 4th day of February, 2013.



JEFFREY L KIMPS S - 2436
Wisconsin Registered Land Surveyor
(original if signed in red)

316-2152