

LAND-MARK SURVEYING
Mark L. Miritz

Wisconsin Registered Land Surveyor S-2582

N9330 Knuteson Drive
Whitewater, WI 53190
Phone: (262) 495-3284
FAX : (262) 495-8421
LAND-MARKSURVEYING.COM

LOT 75

PLAT OF SURVEY



LOT 78 OF BAYWOOD ESTATES 3RD ADDITION,
LOCATED IN SECTION 1, TOWN 3 NORTH, RANGE
16 EAST, TOWN OF SUGAR CREEK, WALWORTH
COUNTY, WISCONSIN.

ORDERED BY: CONNIE POGGENSEE
THE RAULAND AGENCY
118 KENOSHA STREET
WALWORTH, WI 53184

LOT 77

LOT 78
20,240 SQ. FT.

LOT 79

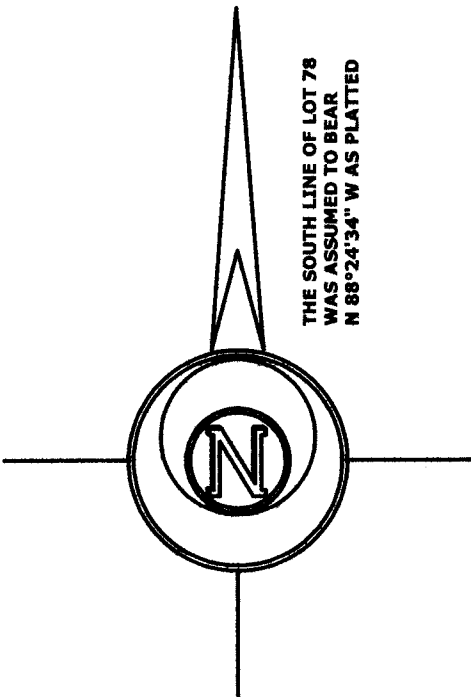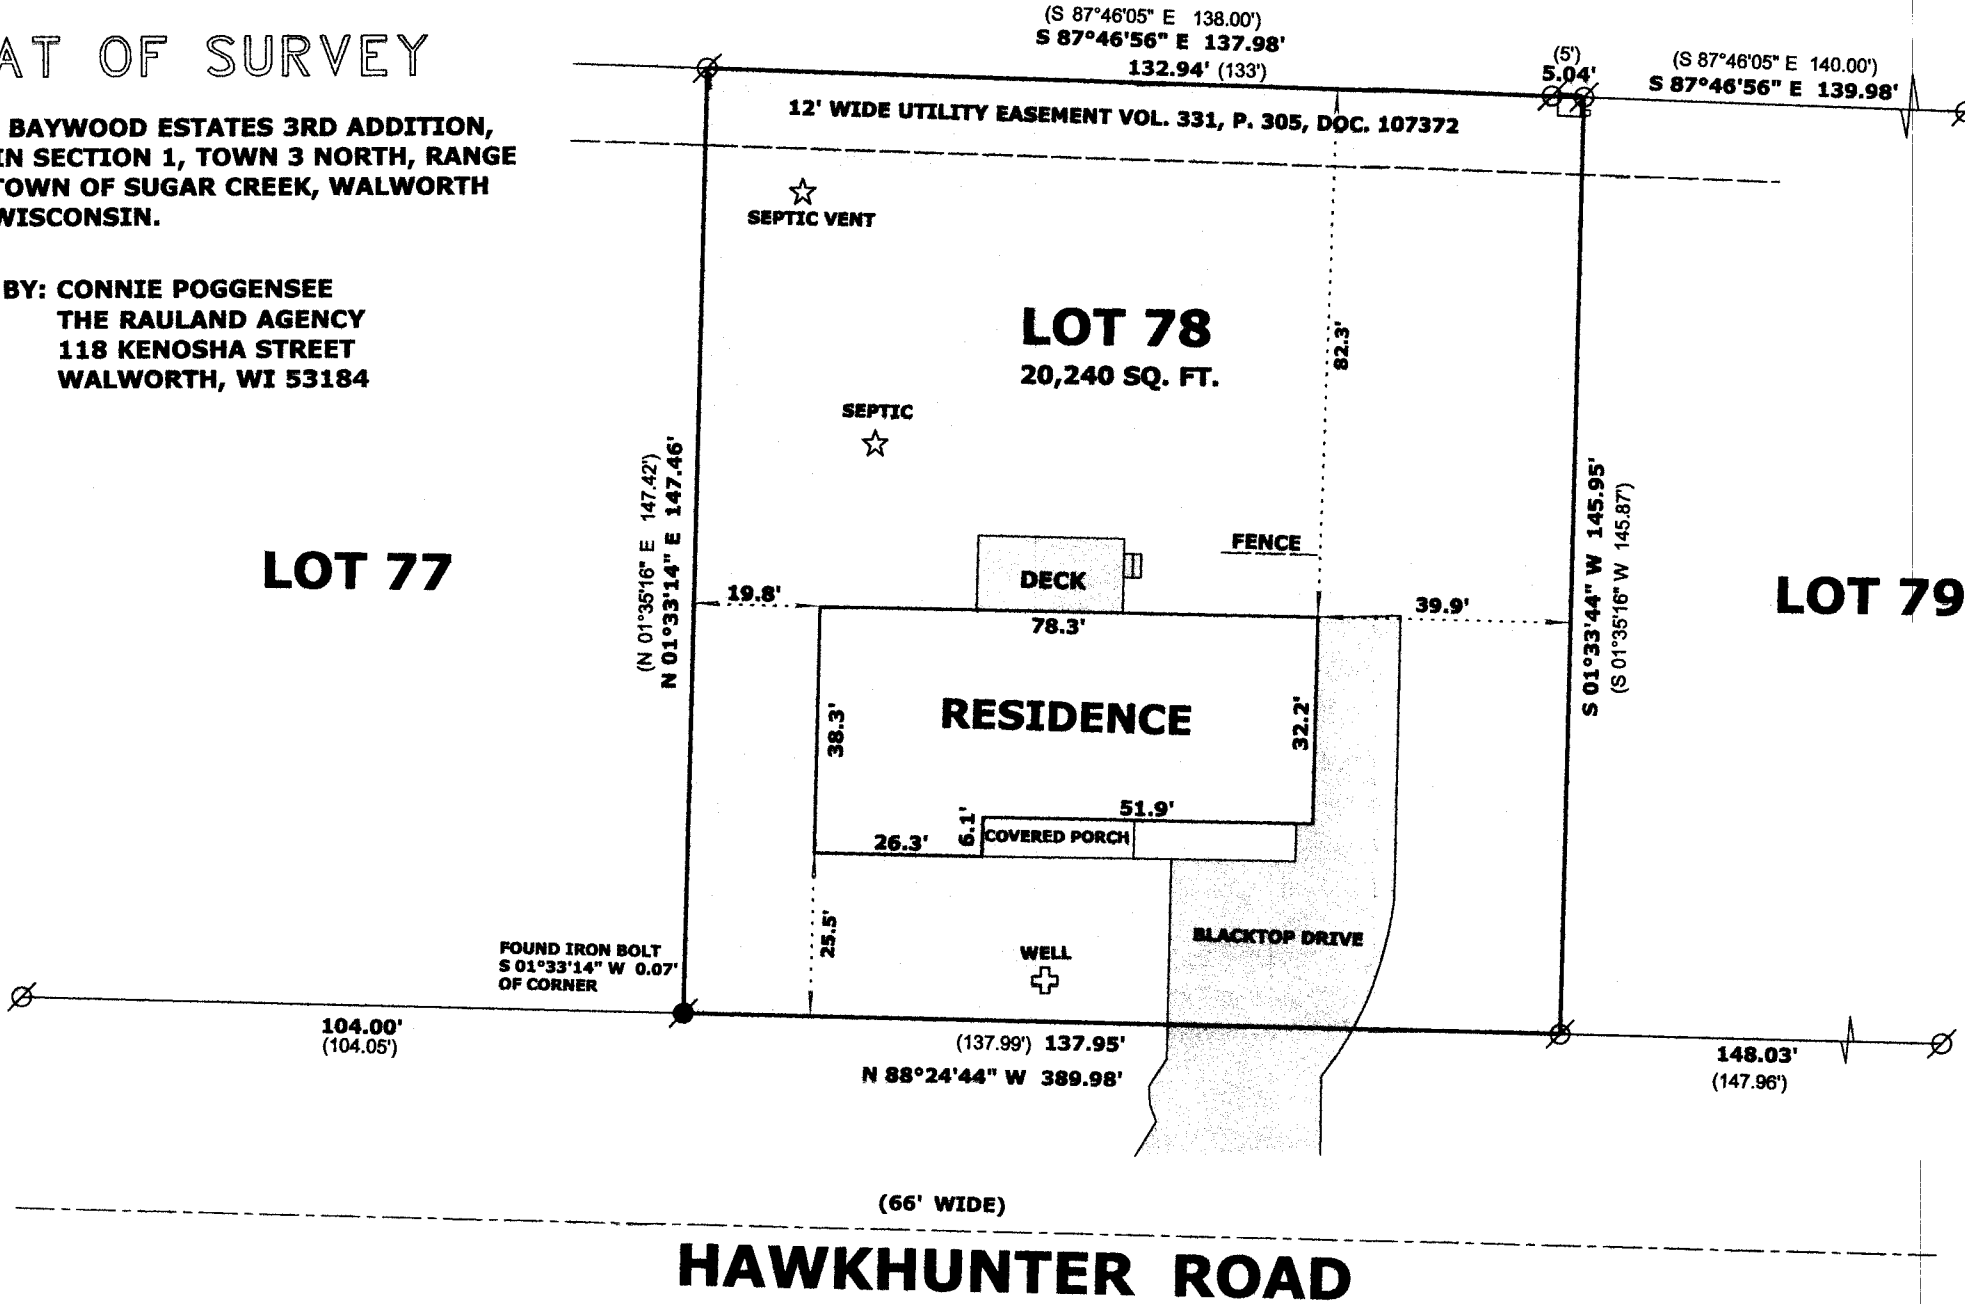

LEGEND

- FOUND IRON PIPE
- FOUND IRON BOLT
- RECORDED AS DIMENSION

DEC 1, 2 2013

flc

SCALE: 1 INCH = 30 FEET

"I hereby certify that the above described property has been surveyed by me or under my direction and that the above map is a true representation thereof and shows the size and location of the property, its exterior boundaries, the location of all visible structures and dimensions of all principal buildings thereon, boundary fences, apparent easements, roadways and visible encroachments, if any."
"This survey is made for the use of the present owners of the property, and also those who purchase, mortgage, or guarantee the title thereto within one year from date hereof."

Mark L. Miritz
MARK L. MIRITZ

WISCONSIN REGISTERED
LAND SURVEYOR S-2582

DATE: SEPT. 17, 2013 JOB NO. 13.905



GBEC-9

316-2161