

LAND-MARK SURVEYING

Mark L. Miritz

Wisconsin Registered Land Surveyor S-2582

N9330 Knuteson Drive

Whitewater, WI 53190

Phone: (262) 495-3284


MARKMIRITZ@

LAND-MARKSURVEYING.COM

PLAT OF SURVEY


LOTS FOURTEEN (14), FIFTEEN (15) AND SIXTEEN (16), IN BLOCK ONE HUNDRED SIXTEEN (116), IN LAKE WANDAWEGA SUBDIVISION, ACCORDING TO THE RECORDED PLAT THEREOF, IN TOWN OF SUGAR CREEK, WALWORTH COUNTY, WISCONSIN. ALSO A PARCEL OF LAND LOCATED IN THE SOUTHWEST 1/4 OF SECTION 1, TOWN 3 NORTH, RANGE 16 EAST, DESCRIBED AS FOLLOWS: COMMENCING AT THE SOUTHWEST CORNER OF LOT 31, BLOCK 116, LAKE WANDAWEGA SUBDIVISION, THENCE WEST TO THE EAST LINE OF SUGAR CREEK LANE AND THE PLACE OF BEGINNING; RUN THENCE EAST TO THE SOUTHWEST CORNER OF LOT 31, BLOCK 116, LAKE WANDAWEGA SUBDIVISION; THENCE NORTH TO THE SOUTHEAST CORNER OF LOT 16, BLOCK 116, THENCE WEST TO THE EAST LINE OF SUGAR CREEK LANE; THENCE SOUTH TO THE PLACE OF BEGINNING, FORMERLY DESCRIBED AS LOTS 17 AND 18, BLOCK 116, LAKE WANDAWEGA SUBDIVISION.

ORDERED BY: CONNIE POGGENSEE
THE RAULAND AGENCY
118 KENOSHA STREET
WALWORTH, WI 53184

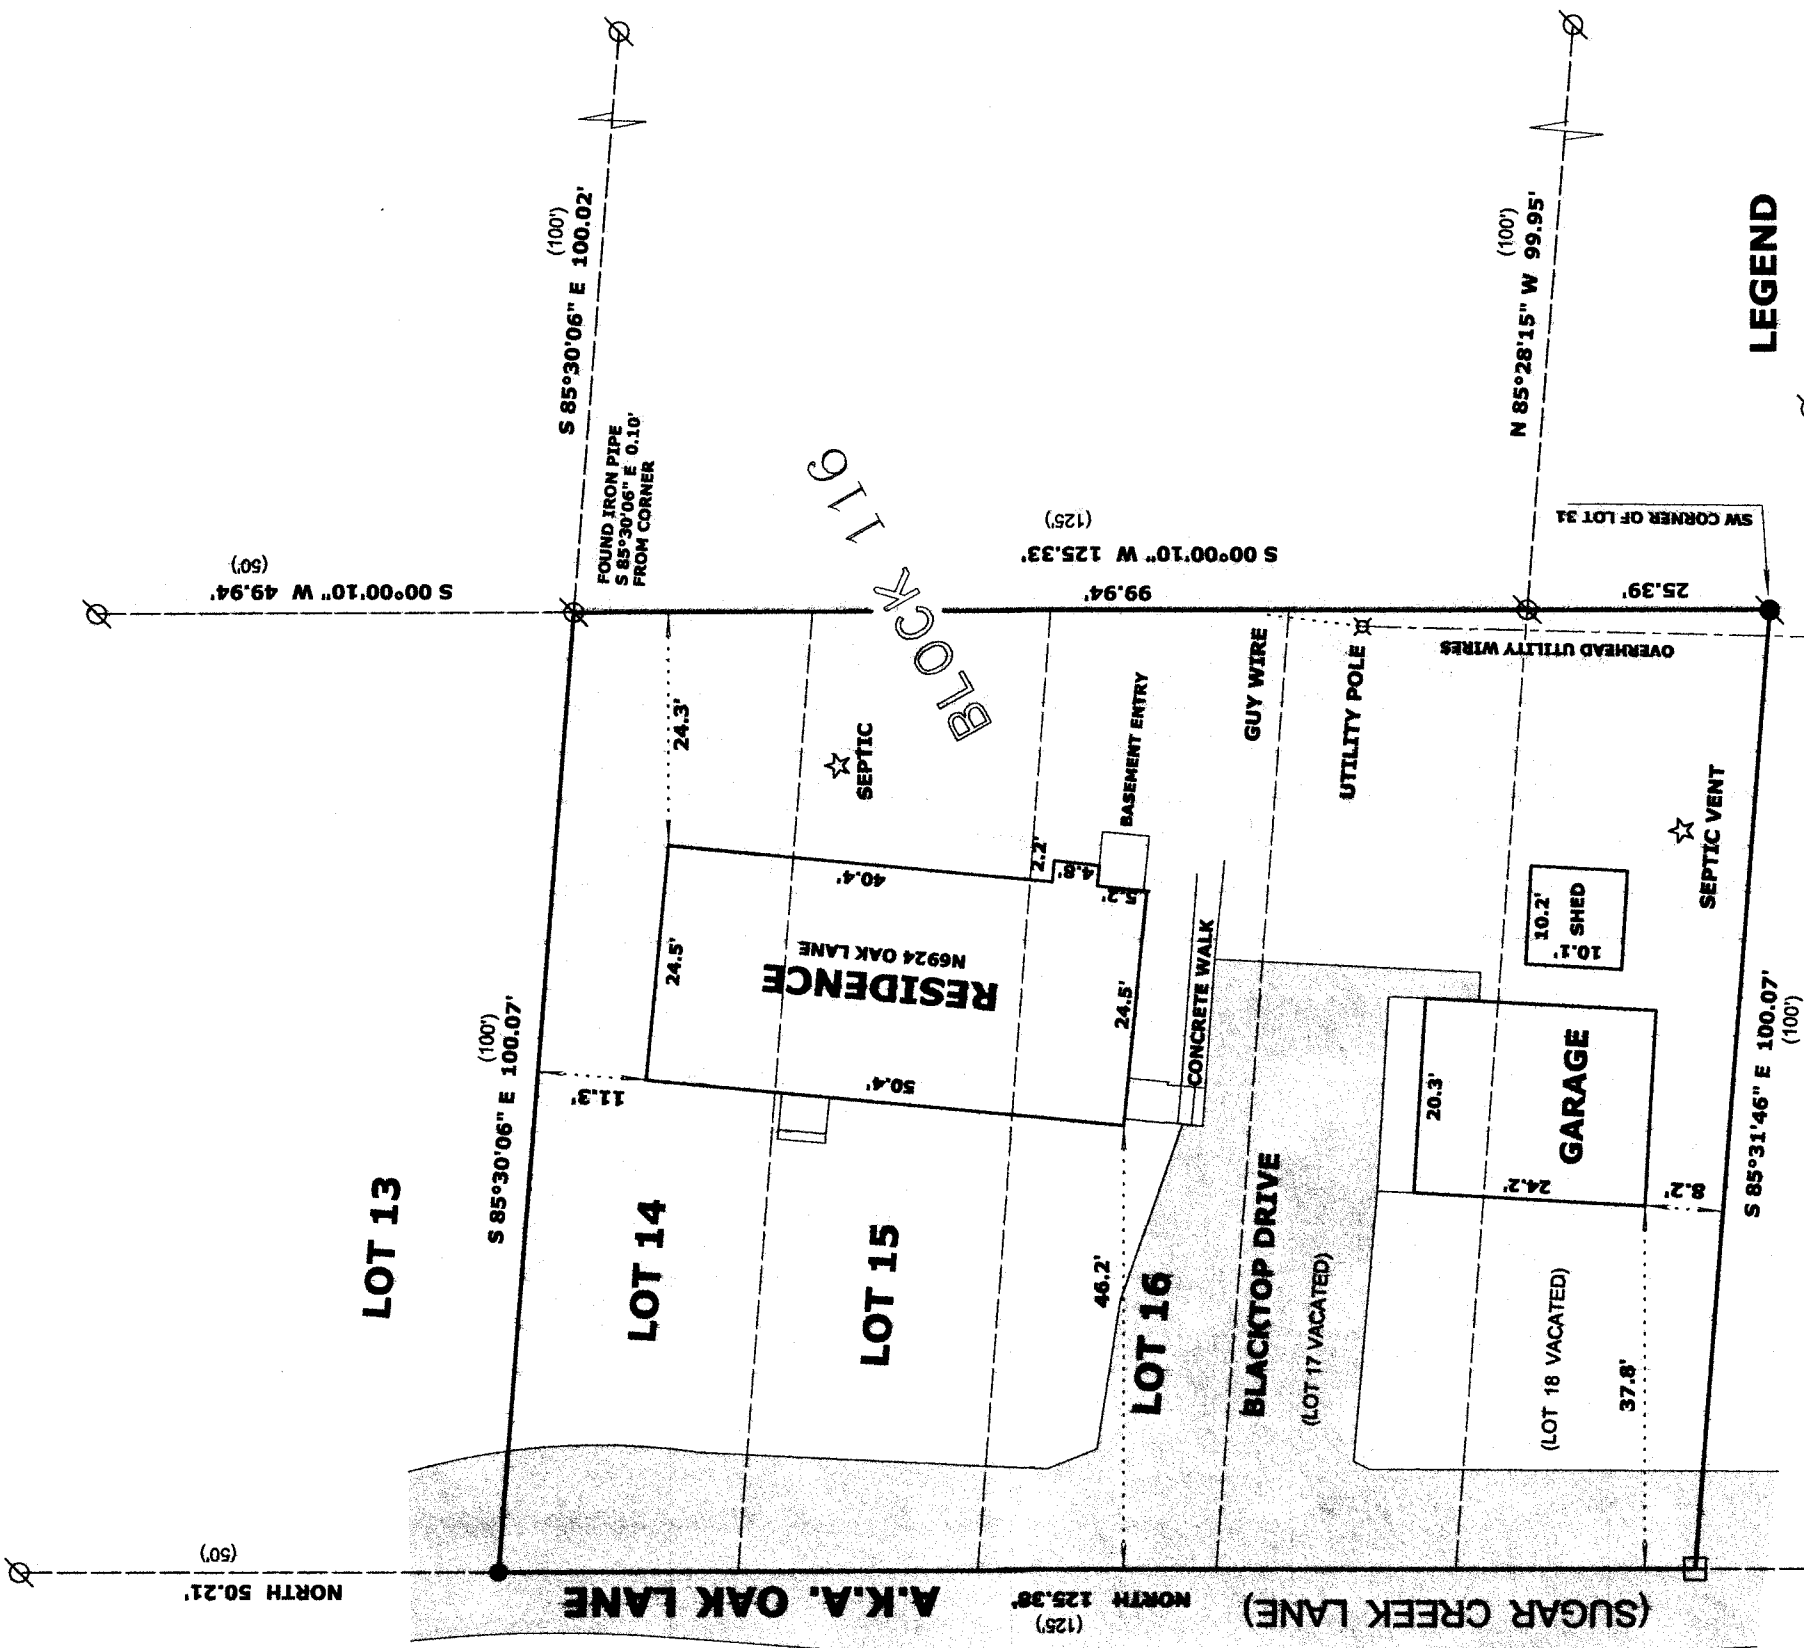

THE EAST LINE OF SUGAR CREEK LANE WAS ASSUMED TO BEAR NORTH

DEC 1 2 2013

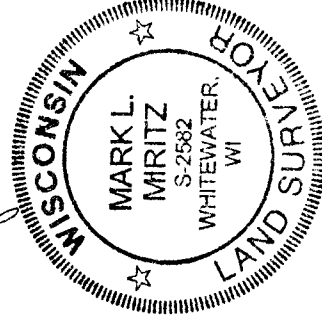

GLW-347
G 8C 1-11B1

Mark L. Miritz
MARK L. MIRITZ
WISCONSIN REGISTERED
LAND SURVEYOR S-2582

DATE: OCT. 11, 2013 JOB NO. 13.1006