



FARRIS, HANSEN & ASSOCIATES, INC.

ENGINEERING - ARCHITECTURE - SURVEYING
7 RIDGWAY COURT - P.O. BOX 437 - ELKHORN, WISCONSIN 53121
PHONE: (262) 723-2098 FAX: (262) 723-5886


PLAT OF SURVEY

LOCATED IN THE NW 1/4 SEC. 12
TOWN 3 NORTH, RANGE 16 EAST
WALWORTH COUNTY, WI.

WORK ORDERED BY -
SUGAR CREEK FOOD & FUEL PROPERTY, INC.
W5180 CTY ROAD A
ELKHORN, WI. 53121

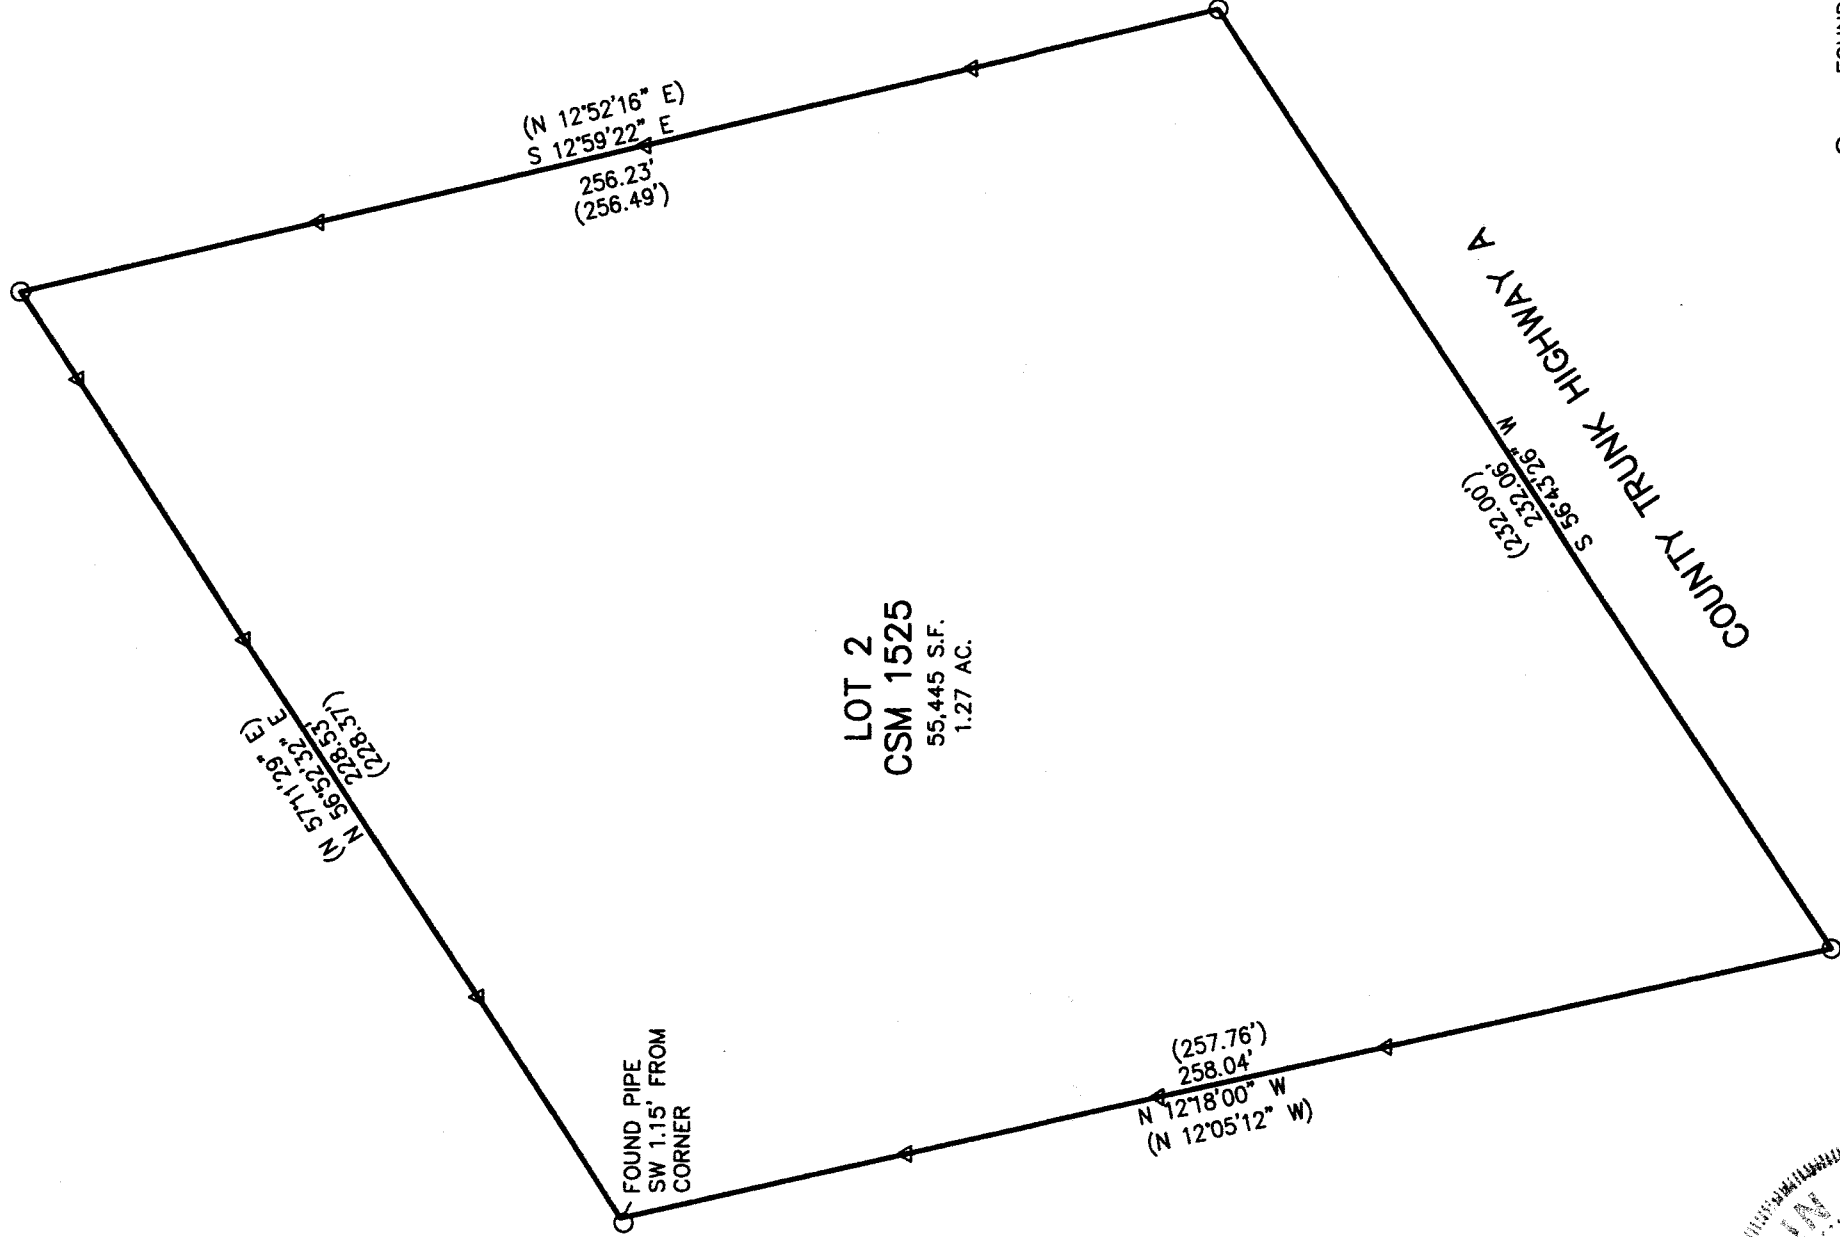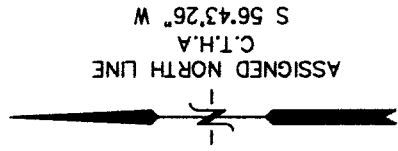


- LEGEND
- O = FOUND IRON PIPE STAKE
 - Δ = SET WOOD LATH ON LINE
 - (XXX) = RECORDED AS

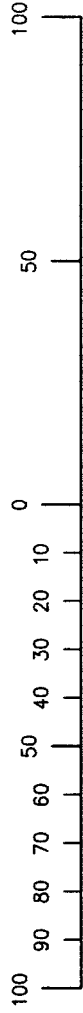

NOTE: COPIES OF THIS MAP TO WHICH THE FOLLOWING CERTIFICATE WILL APPLY SHOW THE SURVEYOR'S ORIGINAL SEAL AND SIGNATURE IN RED INK. COPIES BY ANY OTHER MEANS MAY HAVE ALTERATIONS WHICH DO NOT REPRESENT THE SURVEYOR'S WORK PRODUCT.

I HEREBY CERTIFY THAT THE ABOVE DESCRIBED PROPERTY HAS BEEN SURVEYED UNDER MY DIRECTION AND THAT THE ABOVE MAP IS A TRUE REPRESENTATION THEREOF AND SHOWS THE SIZE AND LOCATION OF THE PROPERTY AND ITS EXTERIOR BOUNDARIES. THIS SURVEY IS MADE FOR THE USE OF THE PRESENT OWNERS OF THE PROPERTY, AND ALSO THOSE WHO PURCHASE, MORTGAGE, OR GUARANTEE THE TITLE THERETO WITHIN ONE YEAR FROM THE DATE HEREOF.

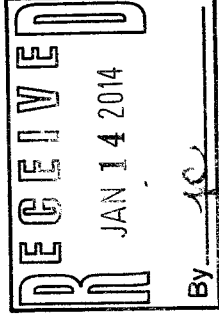

DATED: DECEMBER 23, 2013

PETER S. GORDON R.L.S. 2101

PROJECT: 8940
DATE: 12-23-2013
SHEET 1 OF 1

DEC 23 2013

GA1525-2

316-2169