

LAND-MARK SURVEYING
Mark L. Miritz

Wisconsin Registered Land Surveyor S-2582

N9330 Knuteson Drive
Whitewater, WI 53190
Phone: (262) 495-3284
FAX : (262) 495-8421
LAND-MARKSURVEYING.COM


ORDERED BY: CONNIE POGGENSEE
RAULAND AGENCY INC.
118 KENOSHA STREET
WALWORTH, WI 53184

PLAT OF SURVEY


LOTS 58, 59, 60, 61 AND 62, IN BLOCK "A", NORTH LAKE BEACH, TRACT NO. 1,
AS PLATTED, SAID PLAT BEING RECORDED IN VOLUME 7 OF PLATS ON PAGE 166,
TOWN OF SUGAR CREEK, WALWORTH COUNTY, WISCONSIN.

FOUND IRON PIPE IN
THE WATER BY 0.5'

NORTH LAKE

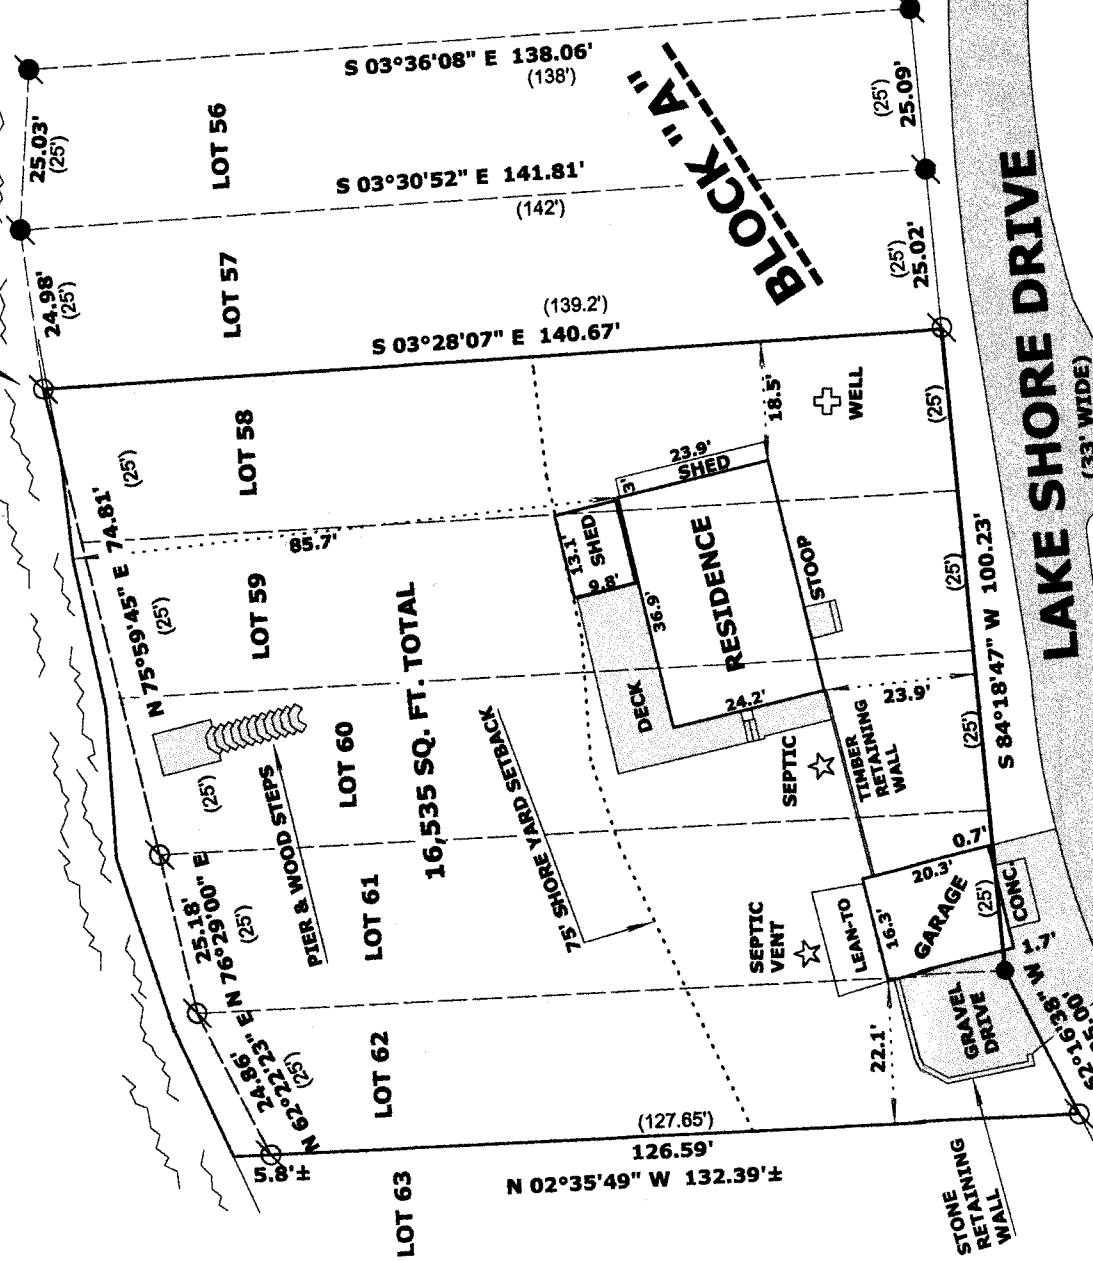

RECEIVED
JUN 20 2014
By *Jan*

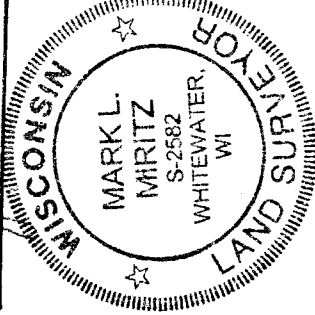

THE NORTH LINE OF LAKE SHORE DR.
WAS ASSUMED TO BEAR N 84°18'47" E
AS PER PREVIOUS SURVEYS

SCALE: 1 INCH = 30 FEET

"I hereby certify that the above described property has been surveyed by me or under my direction and that the above map is a true representation thereof and shows the size and location of the property, its exterior boundaries, the location of all visible structures and dimensions of all principal buildings thereon, boundary fences, apparent easements, roadways and visible encroachments, if any."
"This survey is made for the use of the present owners of the property, and also those who purchase, mortgage, or guarantee the title thereto within one year from date hereof."

Mark L. Miritz
MARK L. MIRITZ
WISCONSIN REGISTERED
LAND SURVEYOR S-2582

DATE: MAY 13, 2014 JOB NO. 14.502

LEGEND

- FOUND IRON PIPE
- FOUND IRON ROD
- FOUND COUNTY MONUMENT
- FOUND CONCRETE MONUMENT
- CHISEL CUT IN CONCRETE
- SET IRON ROD, 24" LONG, WEIGHING 1.5 LBS./LINEAL FT., 3/4" DIA.
- RECORDED AS DIMENSION
- EXISTING FENCE

G-NLB-30

316-2183