


PREPARED FOR
JANE St. JOHN
COLDWELL BANKER HONIG-BELL
226 BROAD ST.
LAKE GENEVA, WI. 53147

PLAT OF SURVEY

PATHFINDER SURVEYING INC.
(formerly)
J.K. SURVEYING INC.
P.O BOX 322
LAKE GENEVA, WI 53147
WWW.PATHFINDERSURVEYING.NET
262-248-8303

-OF-

LOTS 23, 24, 25, 26 AND 27, BLOCK 16, MAP OF INTERLAKEN, A SUBDIVISION LOCATED IN THE SE 1/4 OF SECTION 11, TOWN 3 NORTH, RANGE 16 EAST OF THE FOURTH PRINCIPAL MERIDIAN, TOWN OF SIGAR CREEK, WALWORTH COUNTY, WISCONSIN.

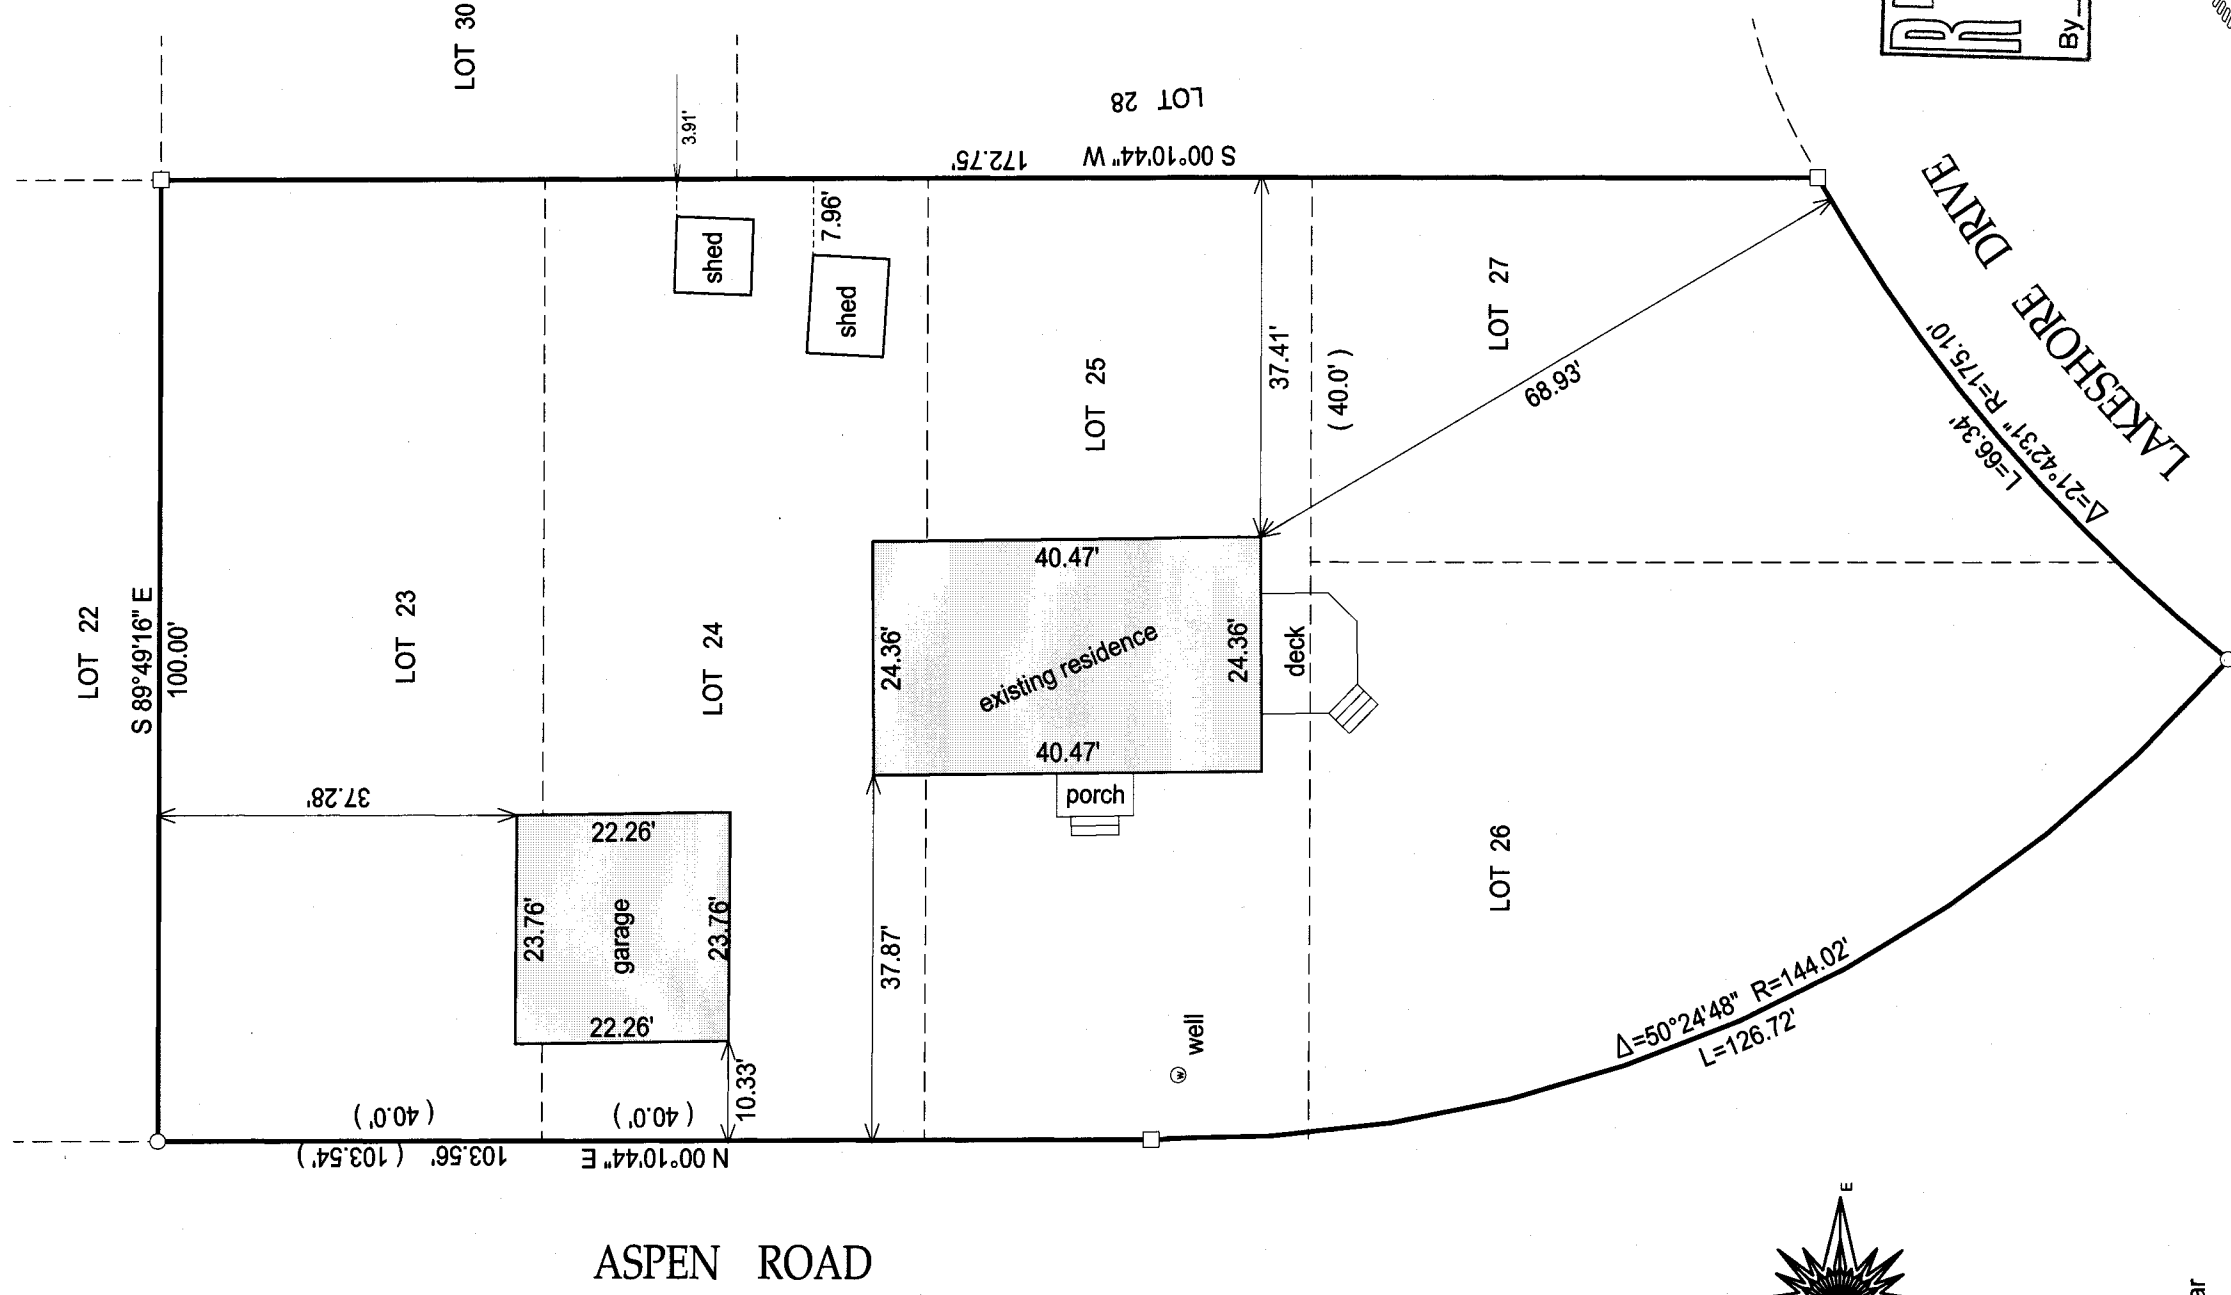

() = recorded as
 □ = found iron bar
 ○ = found iron pipe
 ● = set iron pipe
 ■ = set iron bar

SCALE 1" = 20'

JOB # 14-04

TAX ID #
GI 00209

DATED THIS 10TH DAY OF JANUARY, 2014.

This survey is made for the present owners of the property, and those who purchase, mortgage, or guarantee the title thereto, within one year from the date hereof.

(original if signed in red)

(original if signed in red)

GI - 209

316-2185