




PREPARED FOR
COLLEEN HINE

PLAT OF SURVEY

PATHFINDER SURVEYING INC.
(formerly)
J.K. SURVEYING INC.
P.O. BOX 322
LAKE GENEVA, WI. 53147
WWW.PATHFINDERSURVEYING.NET
262-248-8303

- OF -

LOT 7, BLOCK 10, COOL HILL PARK ADDITION No. 1, LOCATED IN THE
SW 1/4 OF SECTION 35 AND THE SE 1/4 OF SECTION 34, TOWN 4 NORTH,
RANGE 16 EAST AND IN THE NW 1/4 OF SECTION 2 AND THE NE 1/4 OF
SECTION 3, TOWN 3 NORTH, RANGE 16 EAST, WALWORTH COUNTY
WISCONSIN.

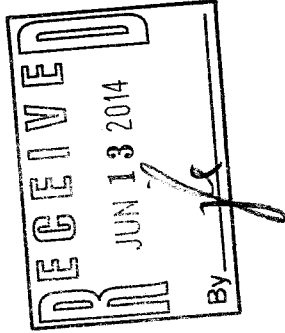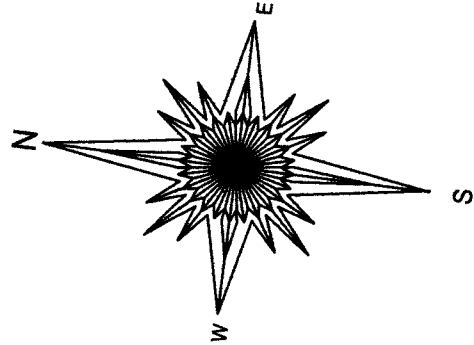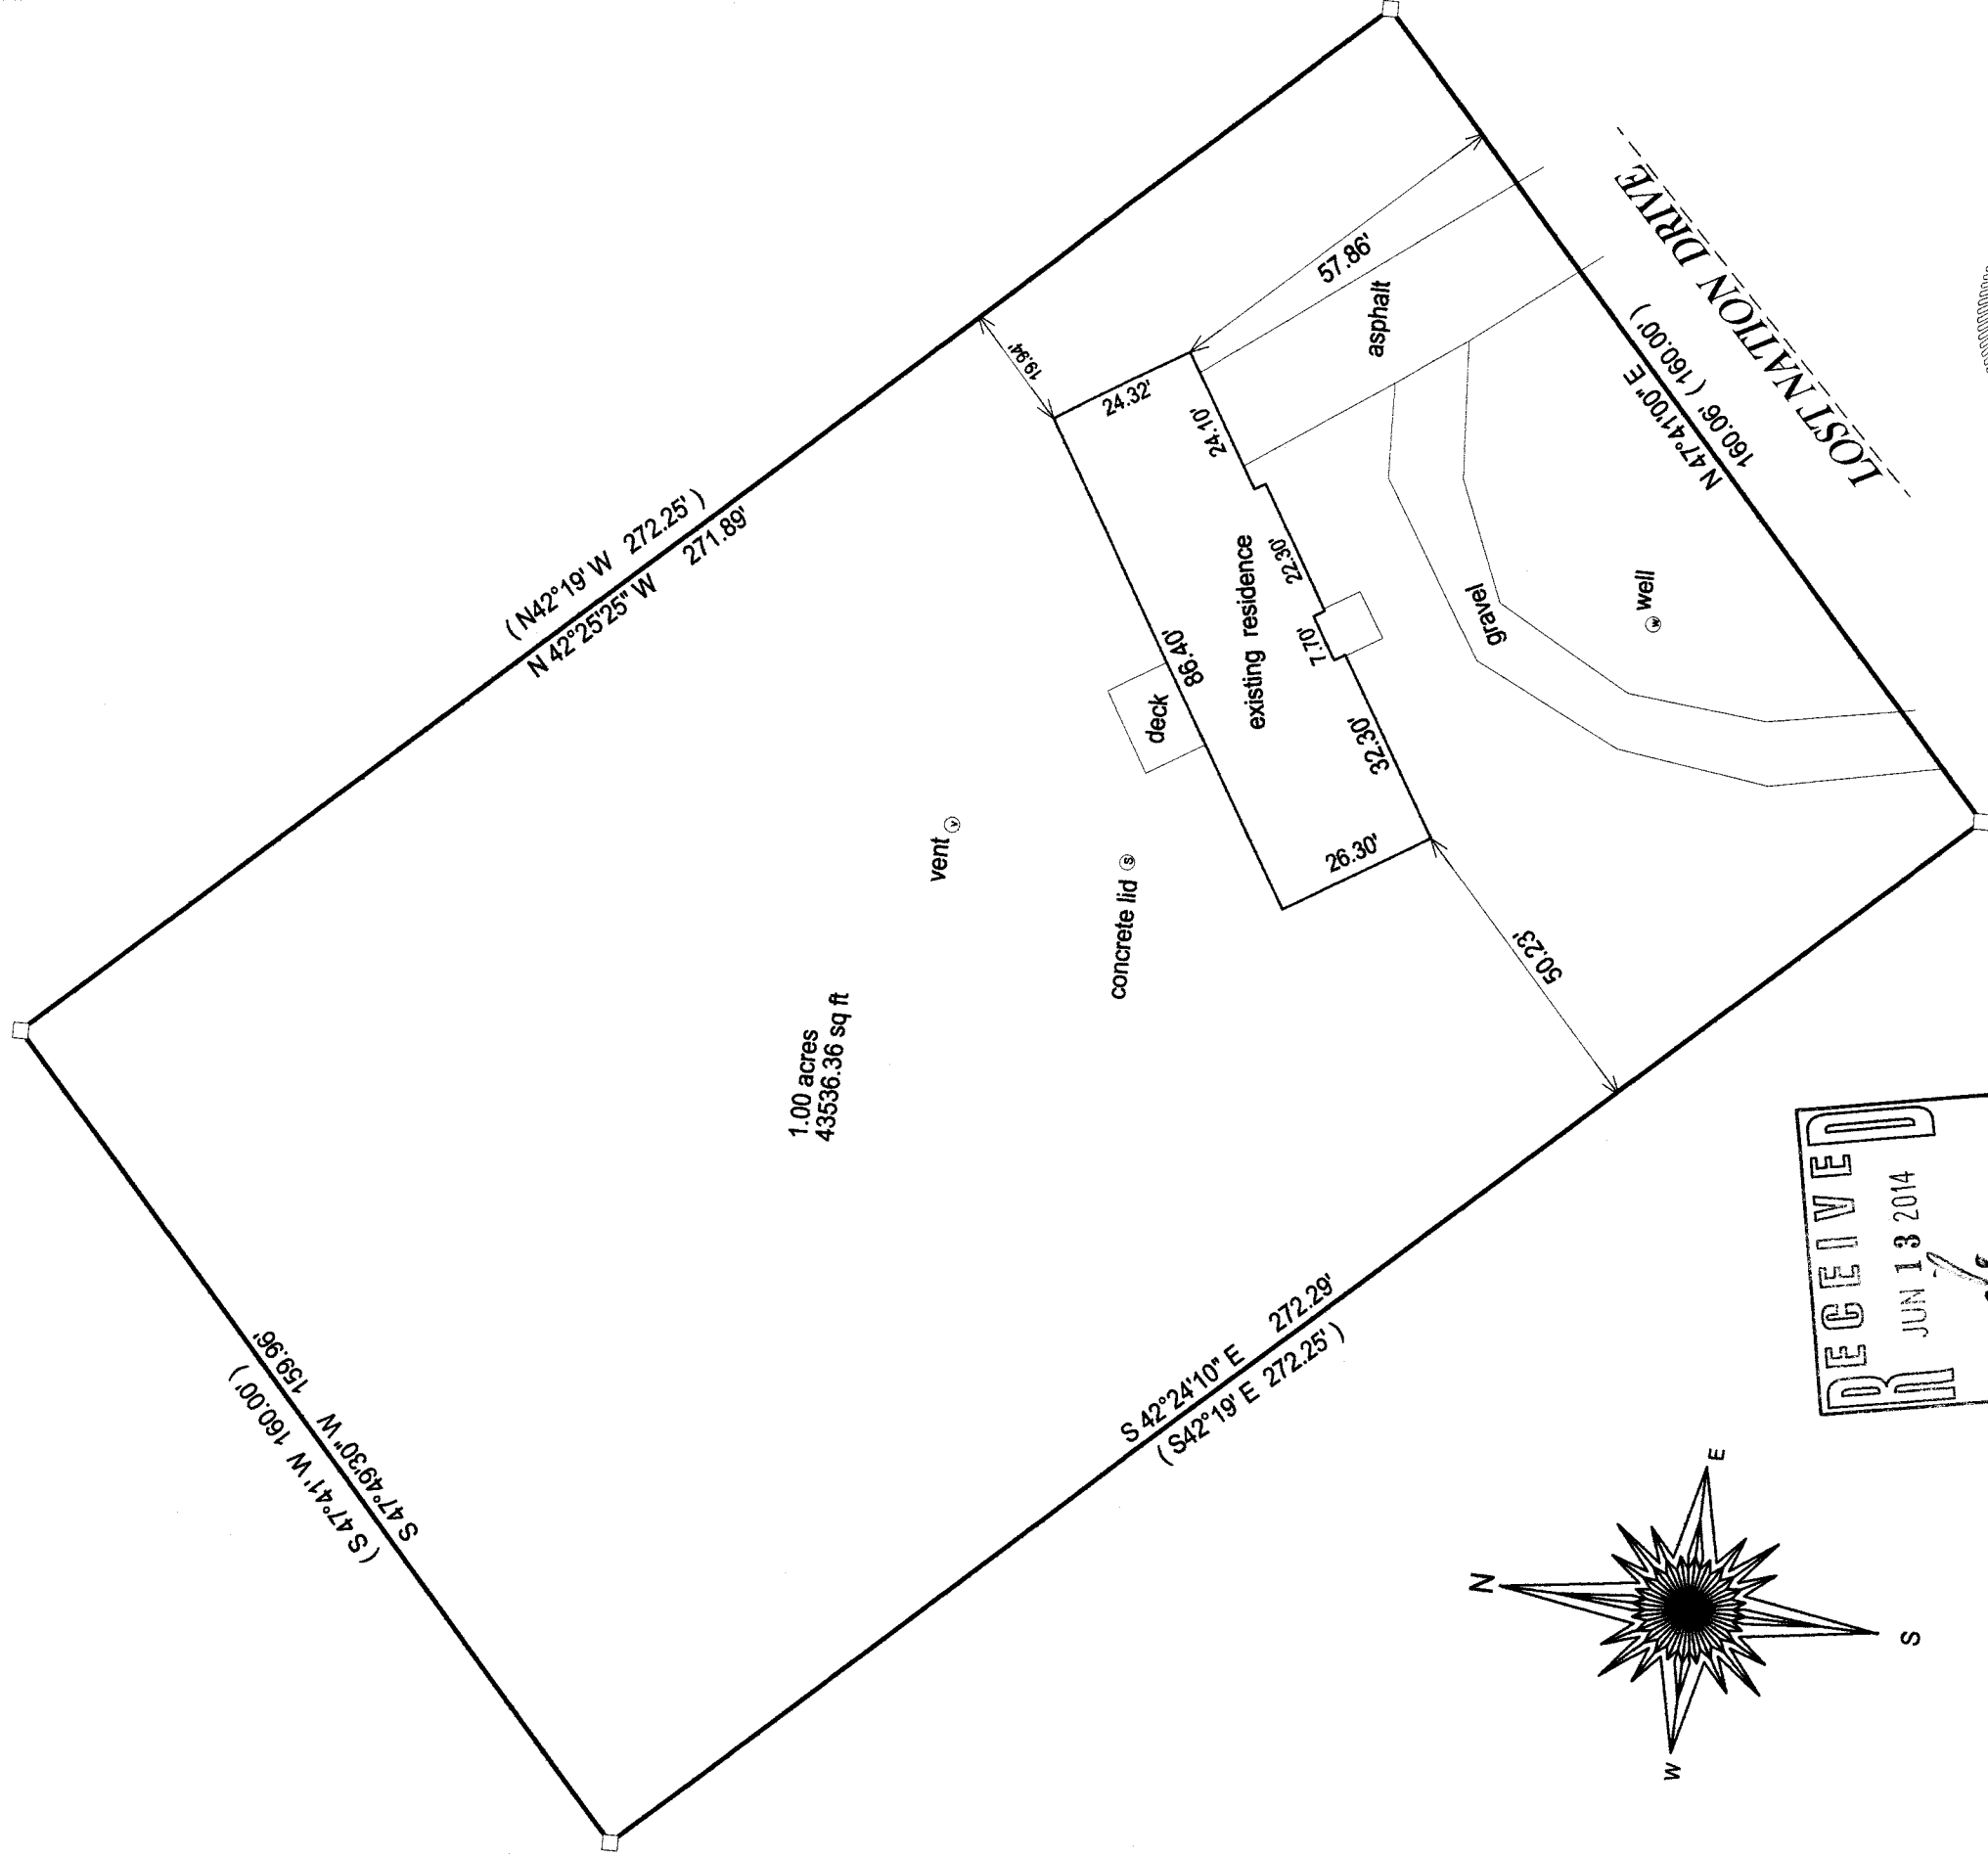

- () = recorded as
- = found iron bar
 - = found iron pipe
 - = set iron pipe
 - = set iron bar

SCALE 1" = 20'

JOB # 13-220

TAX ID #
GCHA 00007



BASIS OF BEARING OF THIS PLAT: THE NORTHERLY
LINE OF LOST NATION DR. WAS ASSUMED TO
BEAR N47°41' E AS SHOWN ON THE RECORD PLAT.

I hereby certify that I have surveyed the above-described property and the
above map is a true representation thereof and shows the size and
location of the property, its exterior boundaries, the location and
dimensions of all structures thereon, fences, apparent easements and
roadways and visible encroachments if any.

This survey is made for the present owners of the property, and those who
purchase, mortgage, or guarantee the title thereto, within one year from
the date hereof.

DATED THIS 26TH DAY OF OCTOBER, 2013.



Jeffrey L. Kimps
JEFFREY L. KIMPS S - 2436
Wisconsin Registered Land Surveyor
(original if signed in red)

GCHA -7 316-2189