
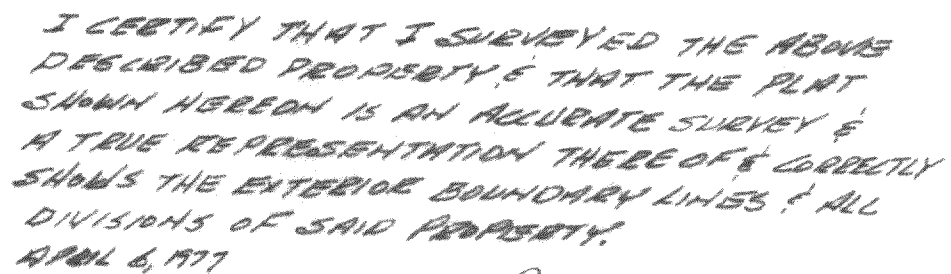


LOTS 26, 27, 28, 29, BLK 20, OF THE 2ND MAP OF
INTERLAKEN SUBDIVISION, LOCATED IN THE SE¹4 OF
SECTION 11, T34N R16E, WALWORTH COUNTY, WIS

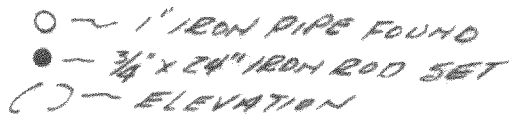

61-257
#1972011