


PLAT OF SURVEY

UNIT 20 OF LAUDERDALE LAKES ESTATES, A CONDOMINIUM, ADDENDUM # 1,
LOCATED IN PART OF THE SE 1/4 AND SW 1/4 OF THE NE 1/4 AND PART OF
THE NW 1/4 OF THE SE 1/4 OF SECTION 1, TOWN 3 NORTH, RANGE 16 EAST,
TOWN OF SUGAR CREEK, WALWORTH COUNTY, WISCONSIN.

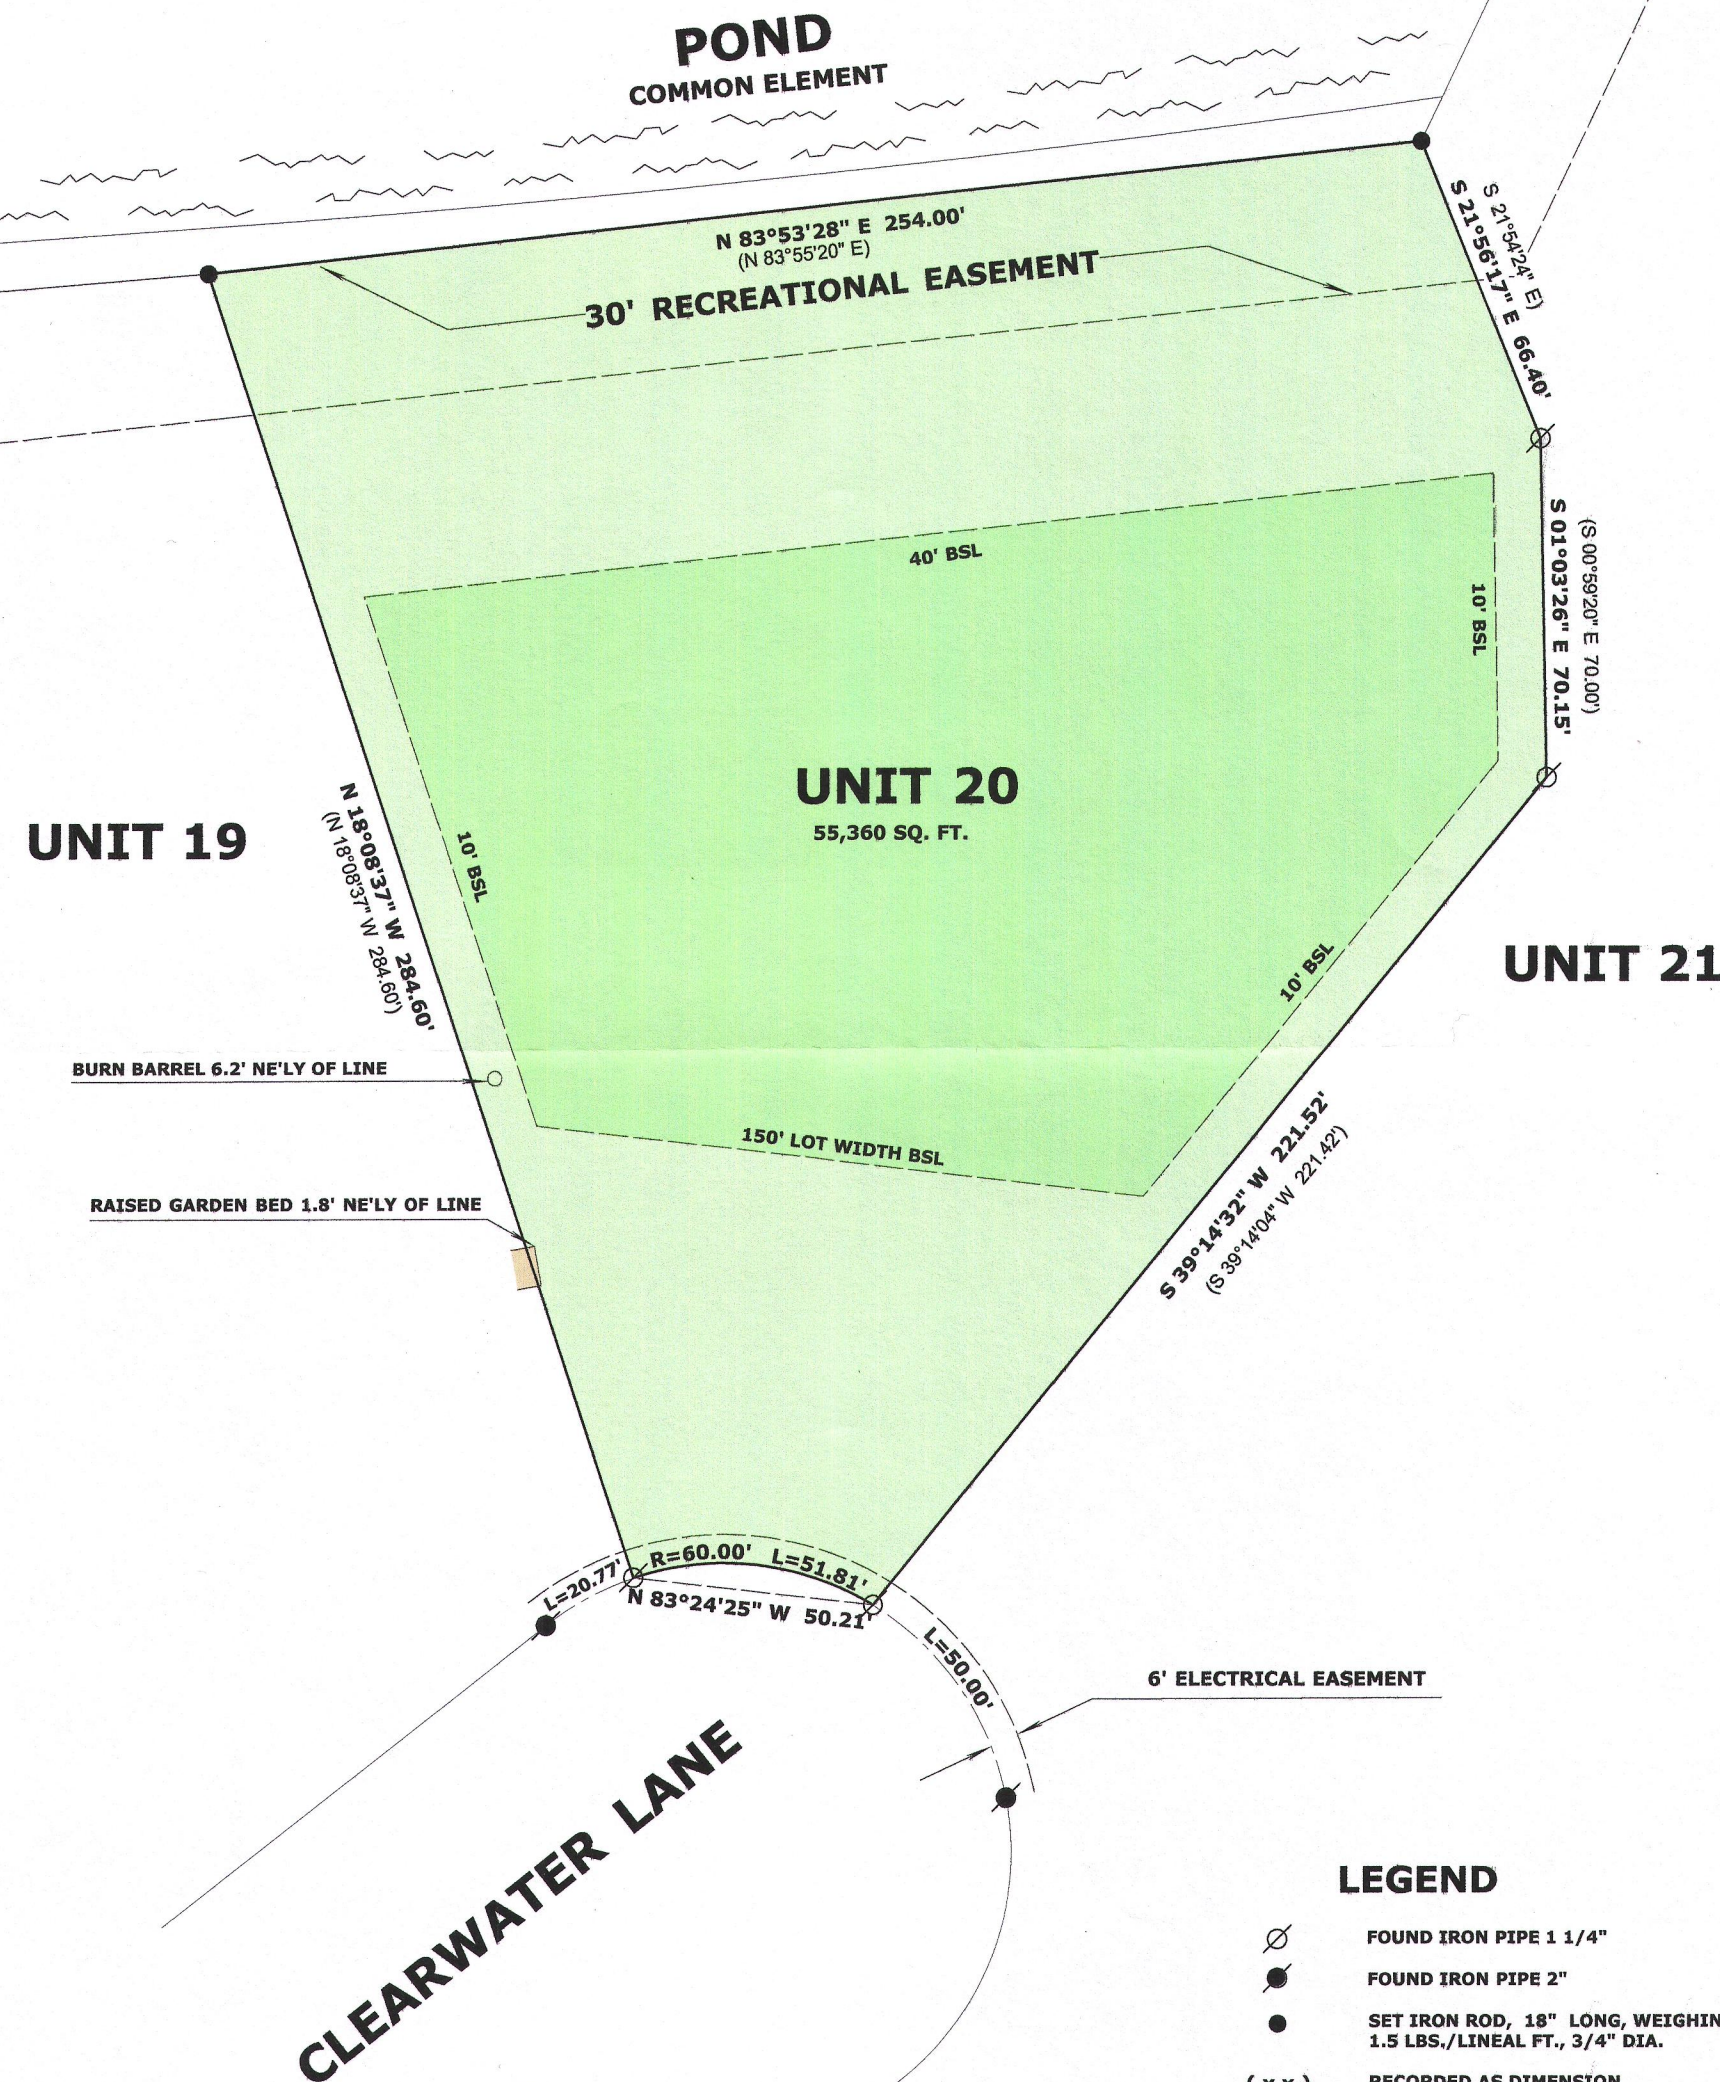


LEGEND

- Ø FOUND IRON PIPE 1 1/4"
- FOUND IRON PIPE 2"
- SET IRON ROD, 18" LONG, WEIGHING 1.5 LBS./LINEAL FT., 3/4" DIA.
- (x x) RECORDED AS DIMENSION
- BSL BUILDING SETBACK LINE

SCALE: 1 INCH = 40 FEET

"I hereby certify that the above described property has been surveyed by me or under my direction and that the above map is a true representation thereof and shows the size and location of the property, its exterior boundaries, the location of all visible structures and dimensions of all principal buildings thereon, boundary fences, apparent easements, roadways and visible encroachments, if any."
"This survey is made for the use of the present owners of the property, and also those who purchase, mortgage, or guarantee the title thereto within one year from date hereof."

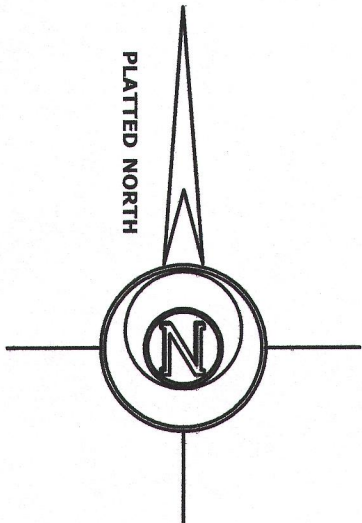

Mark L. Miritz
MARK L. MIRITZ
WISCONSIN PROFESSIONAL
LAND SURVEYOR S-2582

DATE: MARCH 25, 2015 JOB NO. 15.308