


PREPARED FOR:  
L.D. ROCKWELL  
N6618 GROVE RD.  
ELKHORN, WI 53121

# PLAT OF SURVEY

-OF-

LOTS 11, 12, 13, 14 AND THE EASTERLY 1/2 OF THE RESERVE LOT FOR  
BLOCK 7 ALL IN BLOCK 7, OF INTERLAKEN SUBDIVISION, TOWN OF  
SUGAR CREEK, WALWORTH COUNTY, WISCONSIN.

LYNCH & ASSOCIATES  
ENGINEERING CONSULTANTS, LLC.  
405 SKYLINE DRIVE, SUITE C  
LAKE GENEVA, WI 53147  
(262) 248-3697

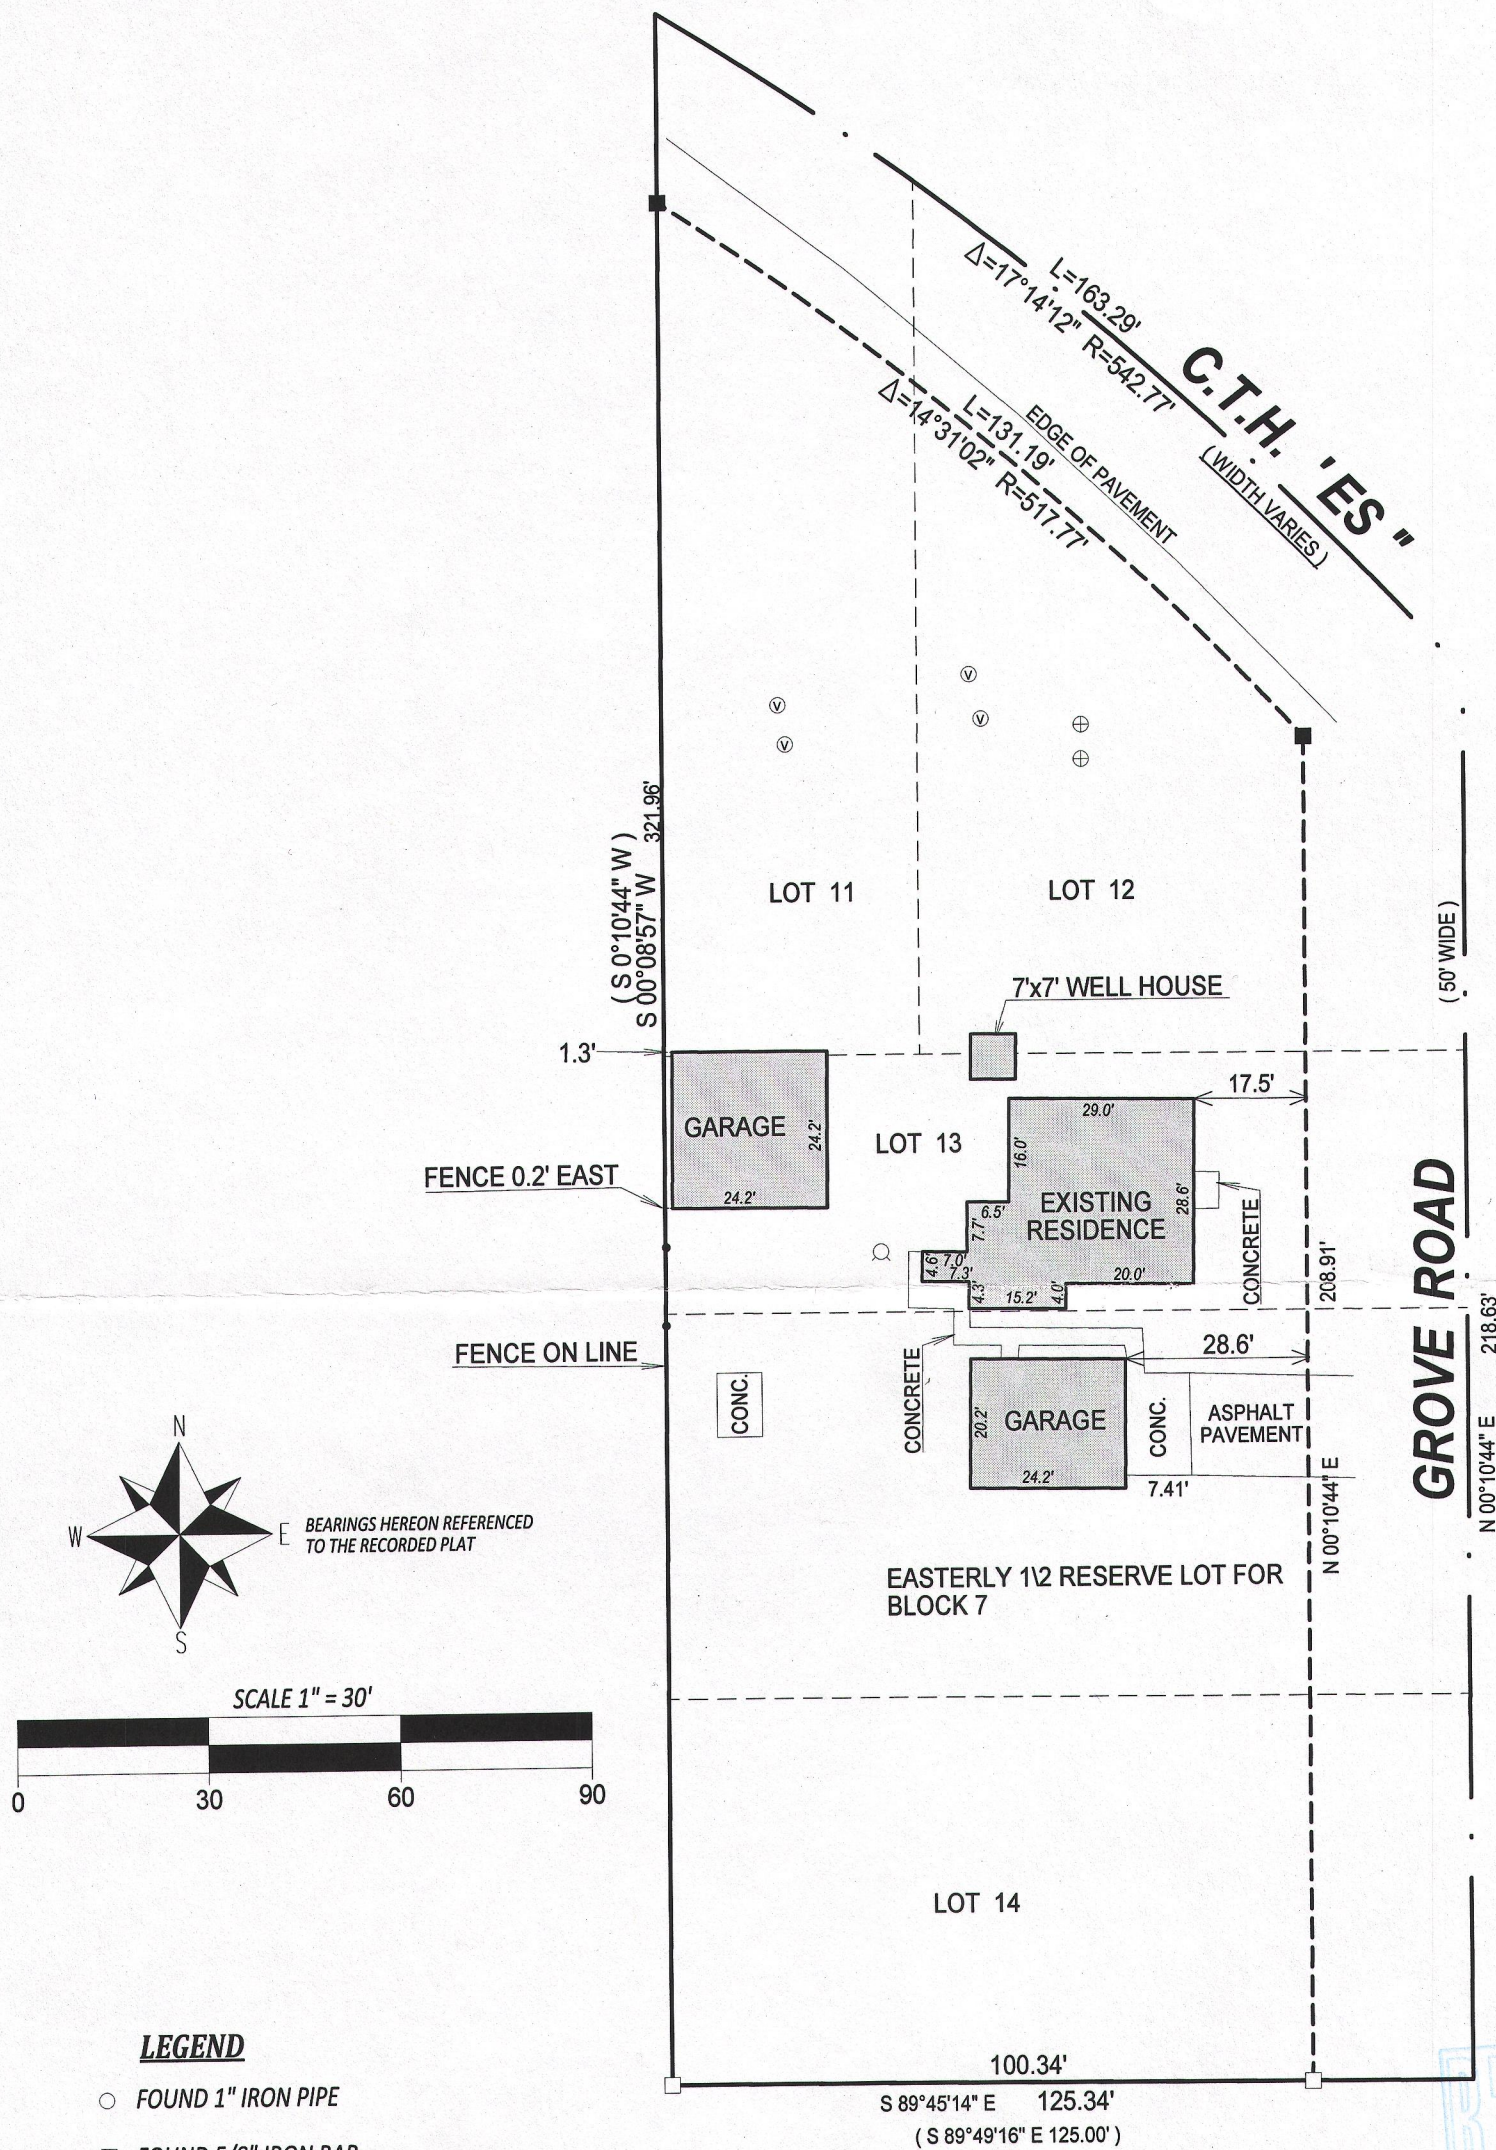

## LEGEND


- FOUND 1" IRON PIPE
- FOUND 5/8" IRON BAR
- SET 5/8" O.D. X 18" IRON BAR 1.13#/L.F.
- (XX) RECORDED AS
- ⊗ POWER POLE
- v— OVERHEAD UTILITY LINE
- WELL
- ⊙ SEPTIC VENT
- ⊕ SEPTIC TANK COVER

## NOTE:

No title commitment or results of a title search were provided to this office pertaining to this survey. This Plat Of Survey may not reflect easements of record, encumbrances, restrictions, ownership, title evidence, or other facts that a current and accurate title search may disclose.

I have surveyed the above-described property and the above map is a true representation thereof and shows the size and location of the property, its exterior boundaries, the location and dimensions of all structures thereon, fences apparent easements and roadways and visible encroachments. if any.

This survey is made for the exclusive use of the present owners of the property, and also those who purchase, mortgage, or insure the title thereto within one (1) year from date hereof; and as to them I warrant the accuracy of said survey map.

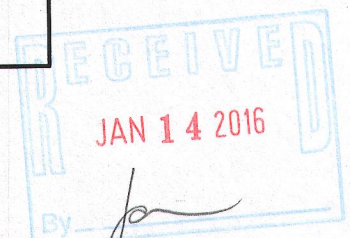

DATED THIS 2nd DAY OF SEPTEMBER, 2015

KENNETH B. MEHRING S - 2838  
Wisconsin Professional Land Surveyor  
(original if signed in red)

JOB # 15-624  
TAXID # GI 00072A, GI00072B AND GI 00073