## LAND-MARK SURVEYING

Mark L. Miritz


Wisconsin Registered Land Surveyor S-2582


N9330 Knuteson Drive
Whitewater, WI 53190
Phone:(262)495-3284
FAX: (262) 495-8421
LAND-MARKSURVEYING.COM

## PLAT OF SURVEY

LOT 75 OF BAYWOOD ESTATES 3RD ADDITION, LOCATED IN SECTION 1, TOWN 3 NORTH, RANGE 16 EAST, TOWN OF SUGAR CREEK, WALWORTH COUNTY, WISCONSIN.

ORDERED BY: CONNIE POGGENSEE
THE RAULAND AGENCY
118 KENOSHA STREET
WALWORTH, WI 53184

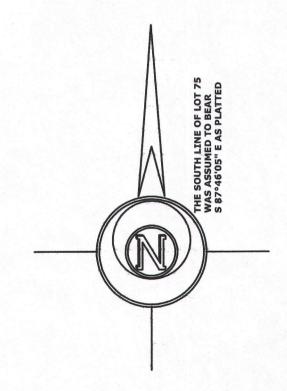

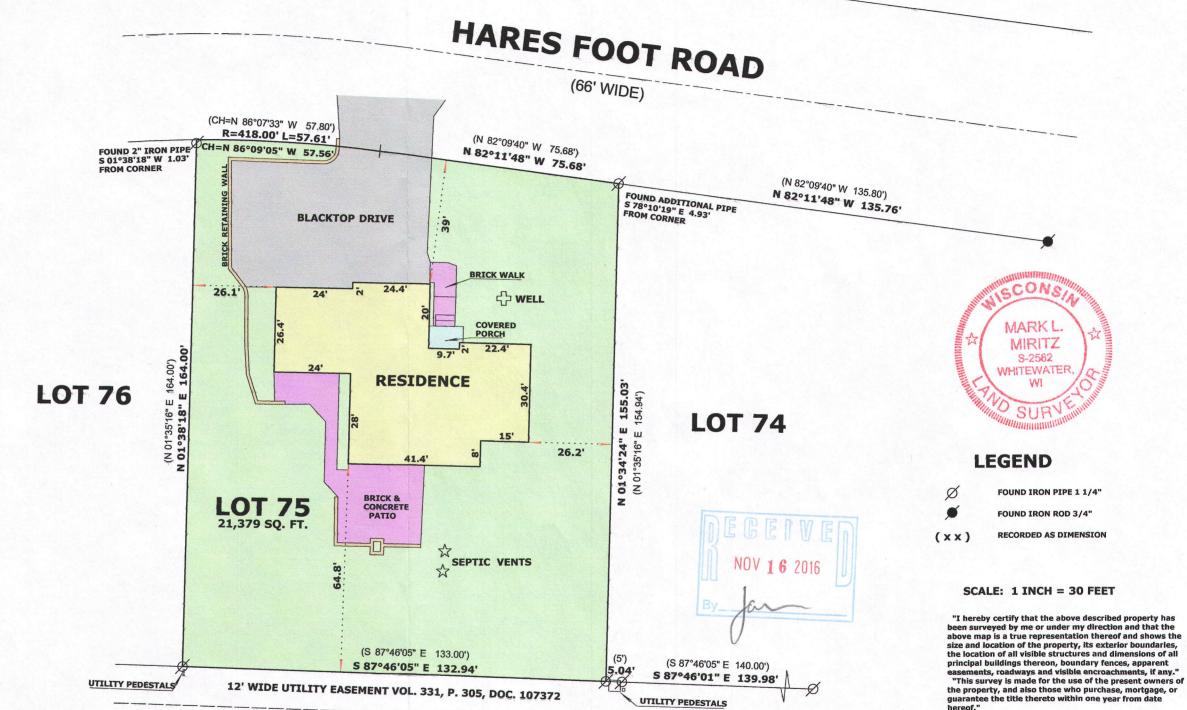

GBEC-6 316-2274

MARK L. MIRITZ

WISCONSIN REGISTERED

**LAND SURVEYOR S-2582** 

DATE: OCT. 26, 2016 JOB NO. 16.1010