



August 4, 1977

I certify that I have surveyed the above described land and that the plat shown hereon is an accurate survey and a true representation thereof and correctly shows the exterior boundary lines and all divisions of said property.

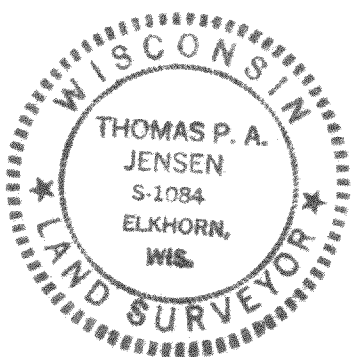

Thomas P.A. Jensen
Elkhorn, Wisconsin

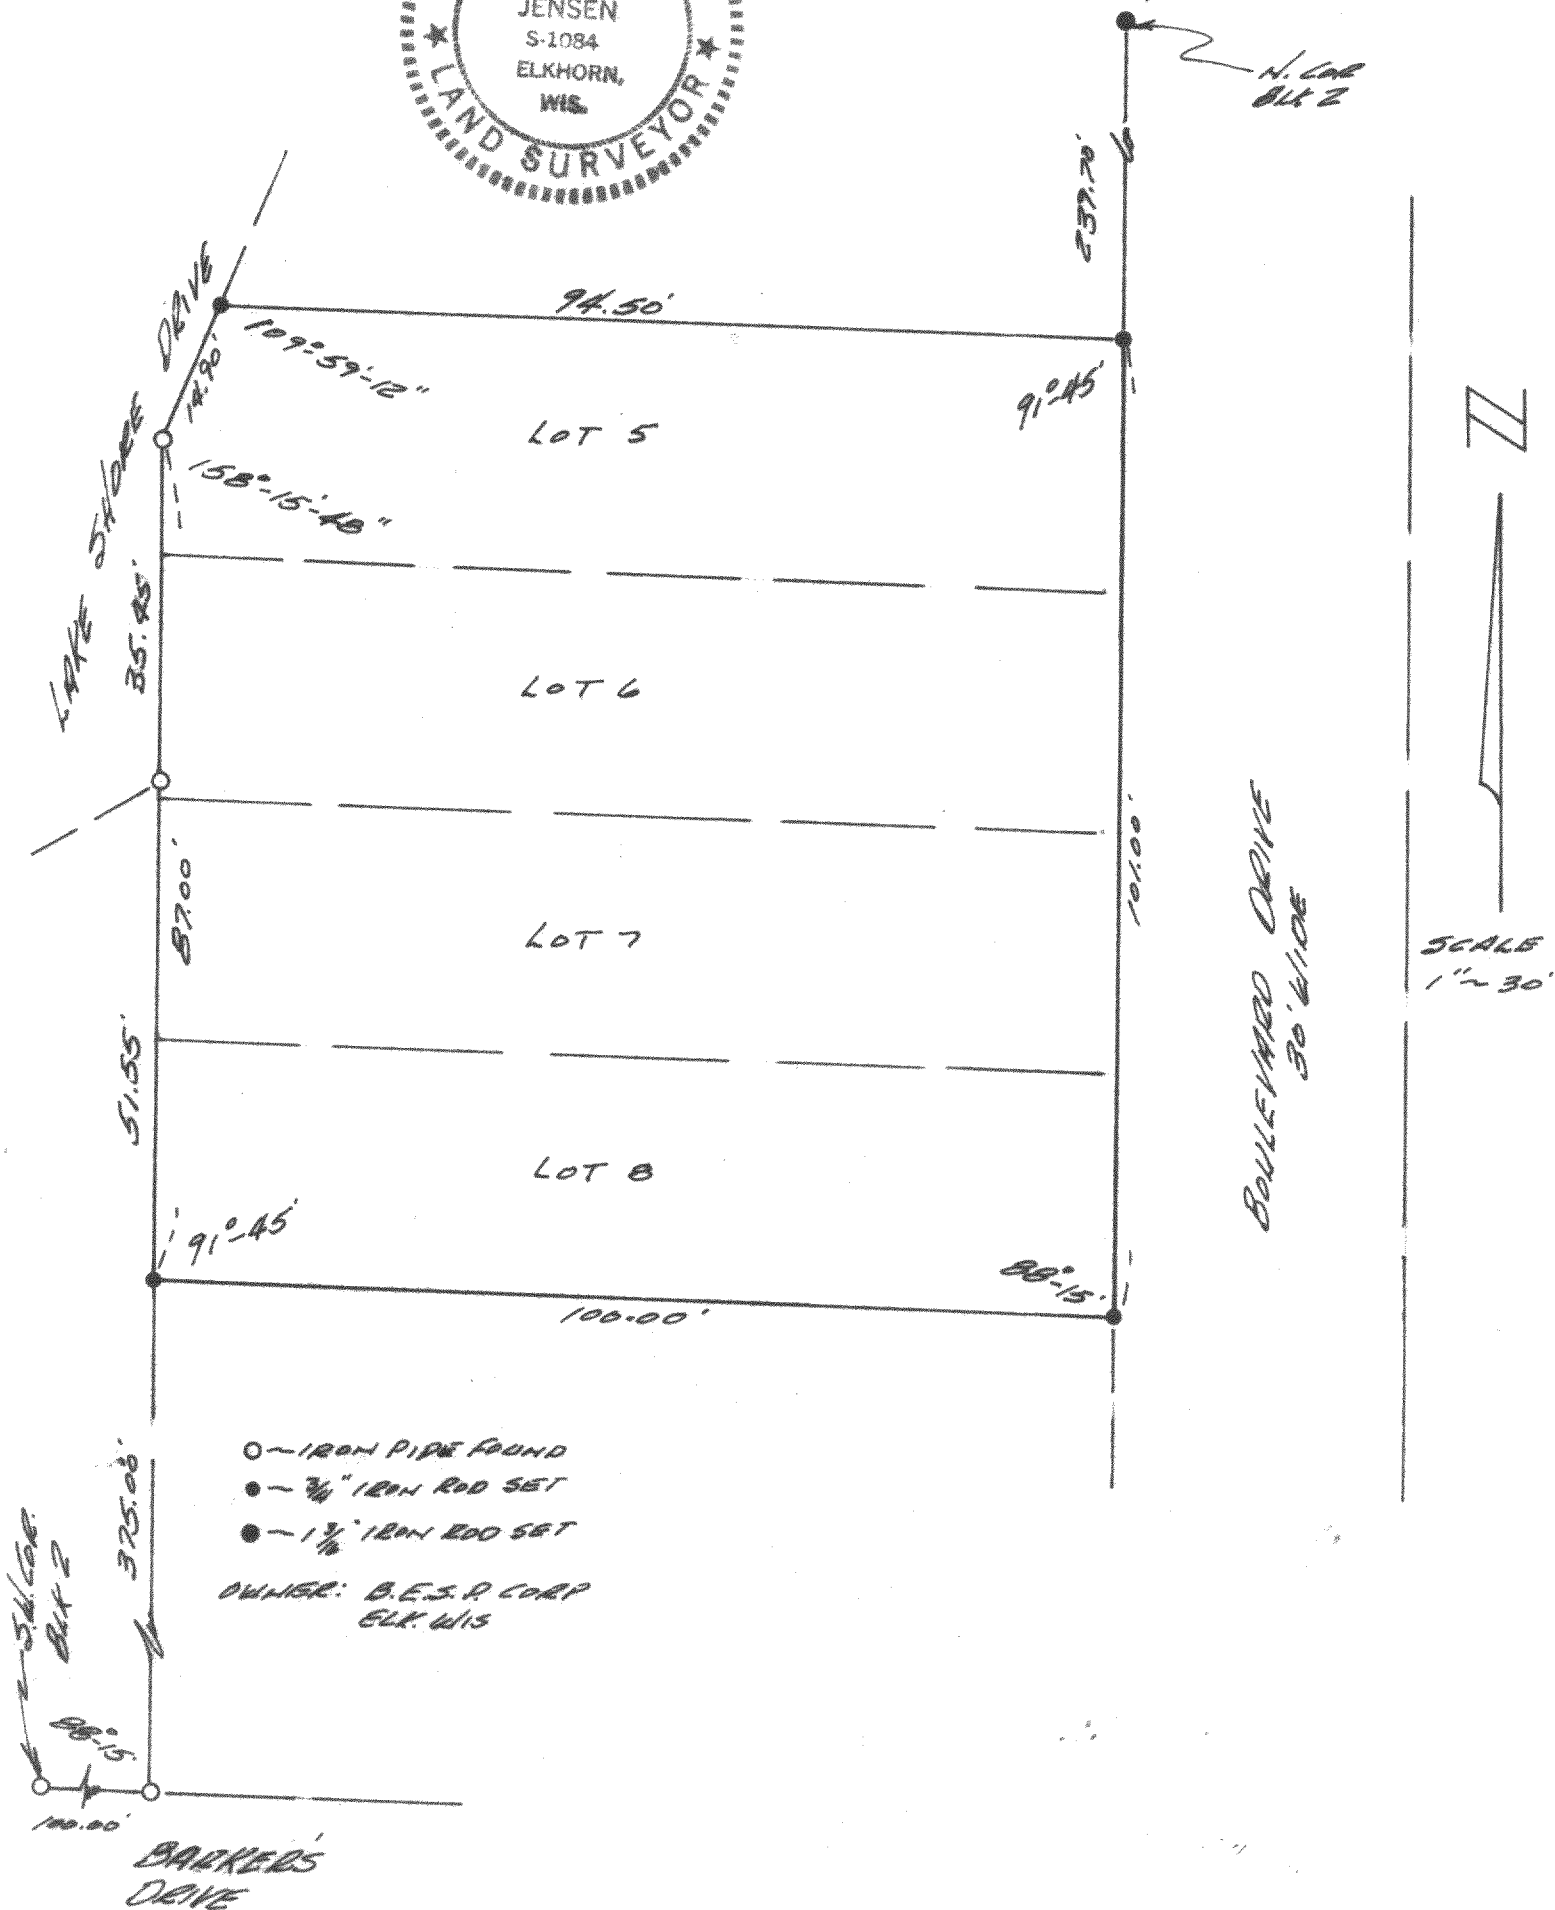

6 NLB3-347

316-231J