


DUNHAM SURVEYING, S.C.
SURVEYING & SUBDIVIDING
DELAVER, WISCONSIN 53115

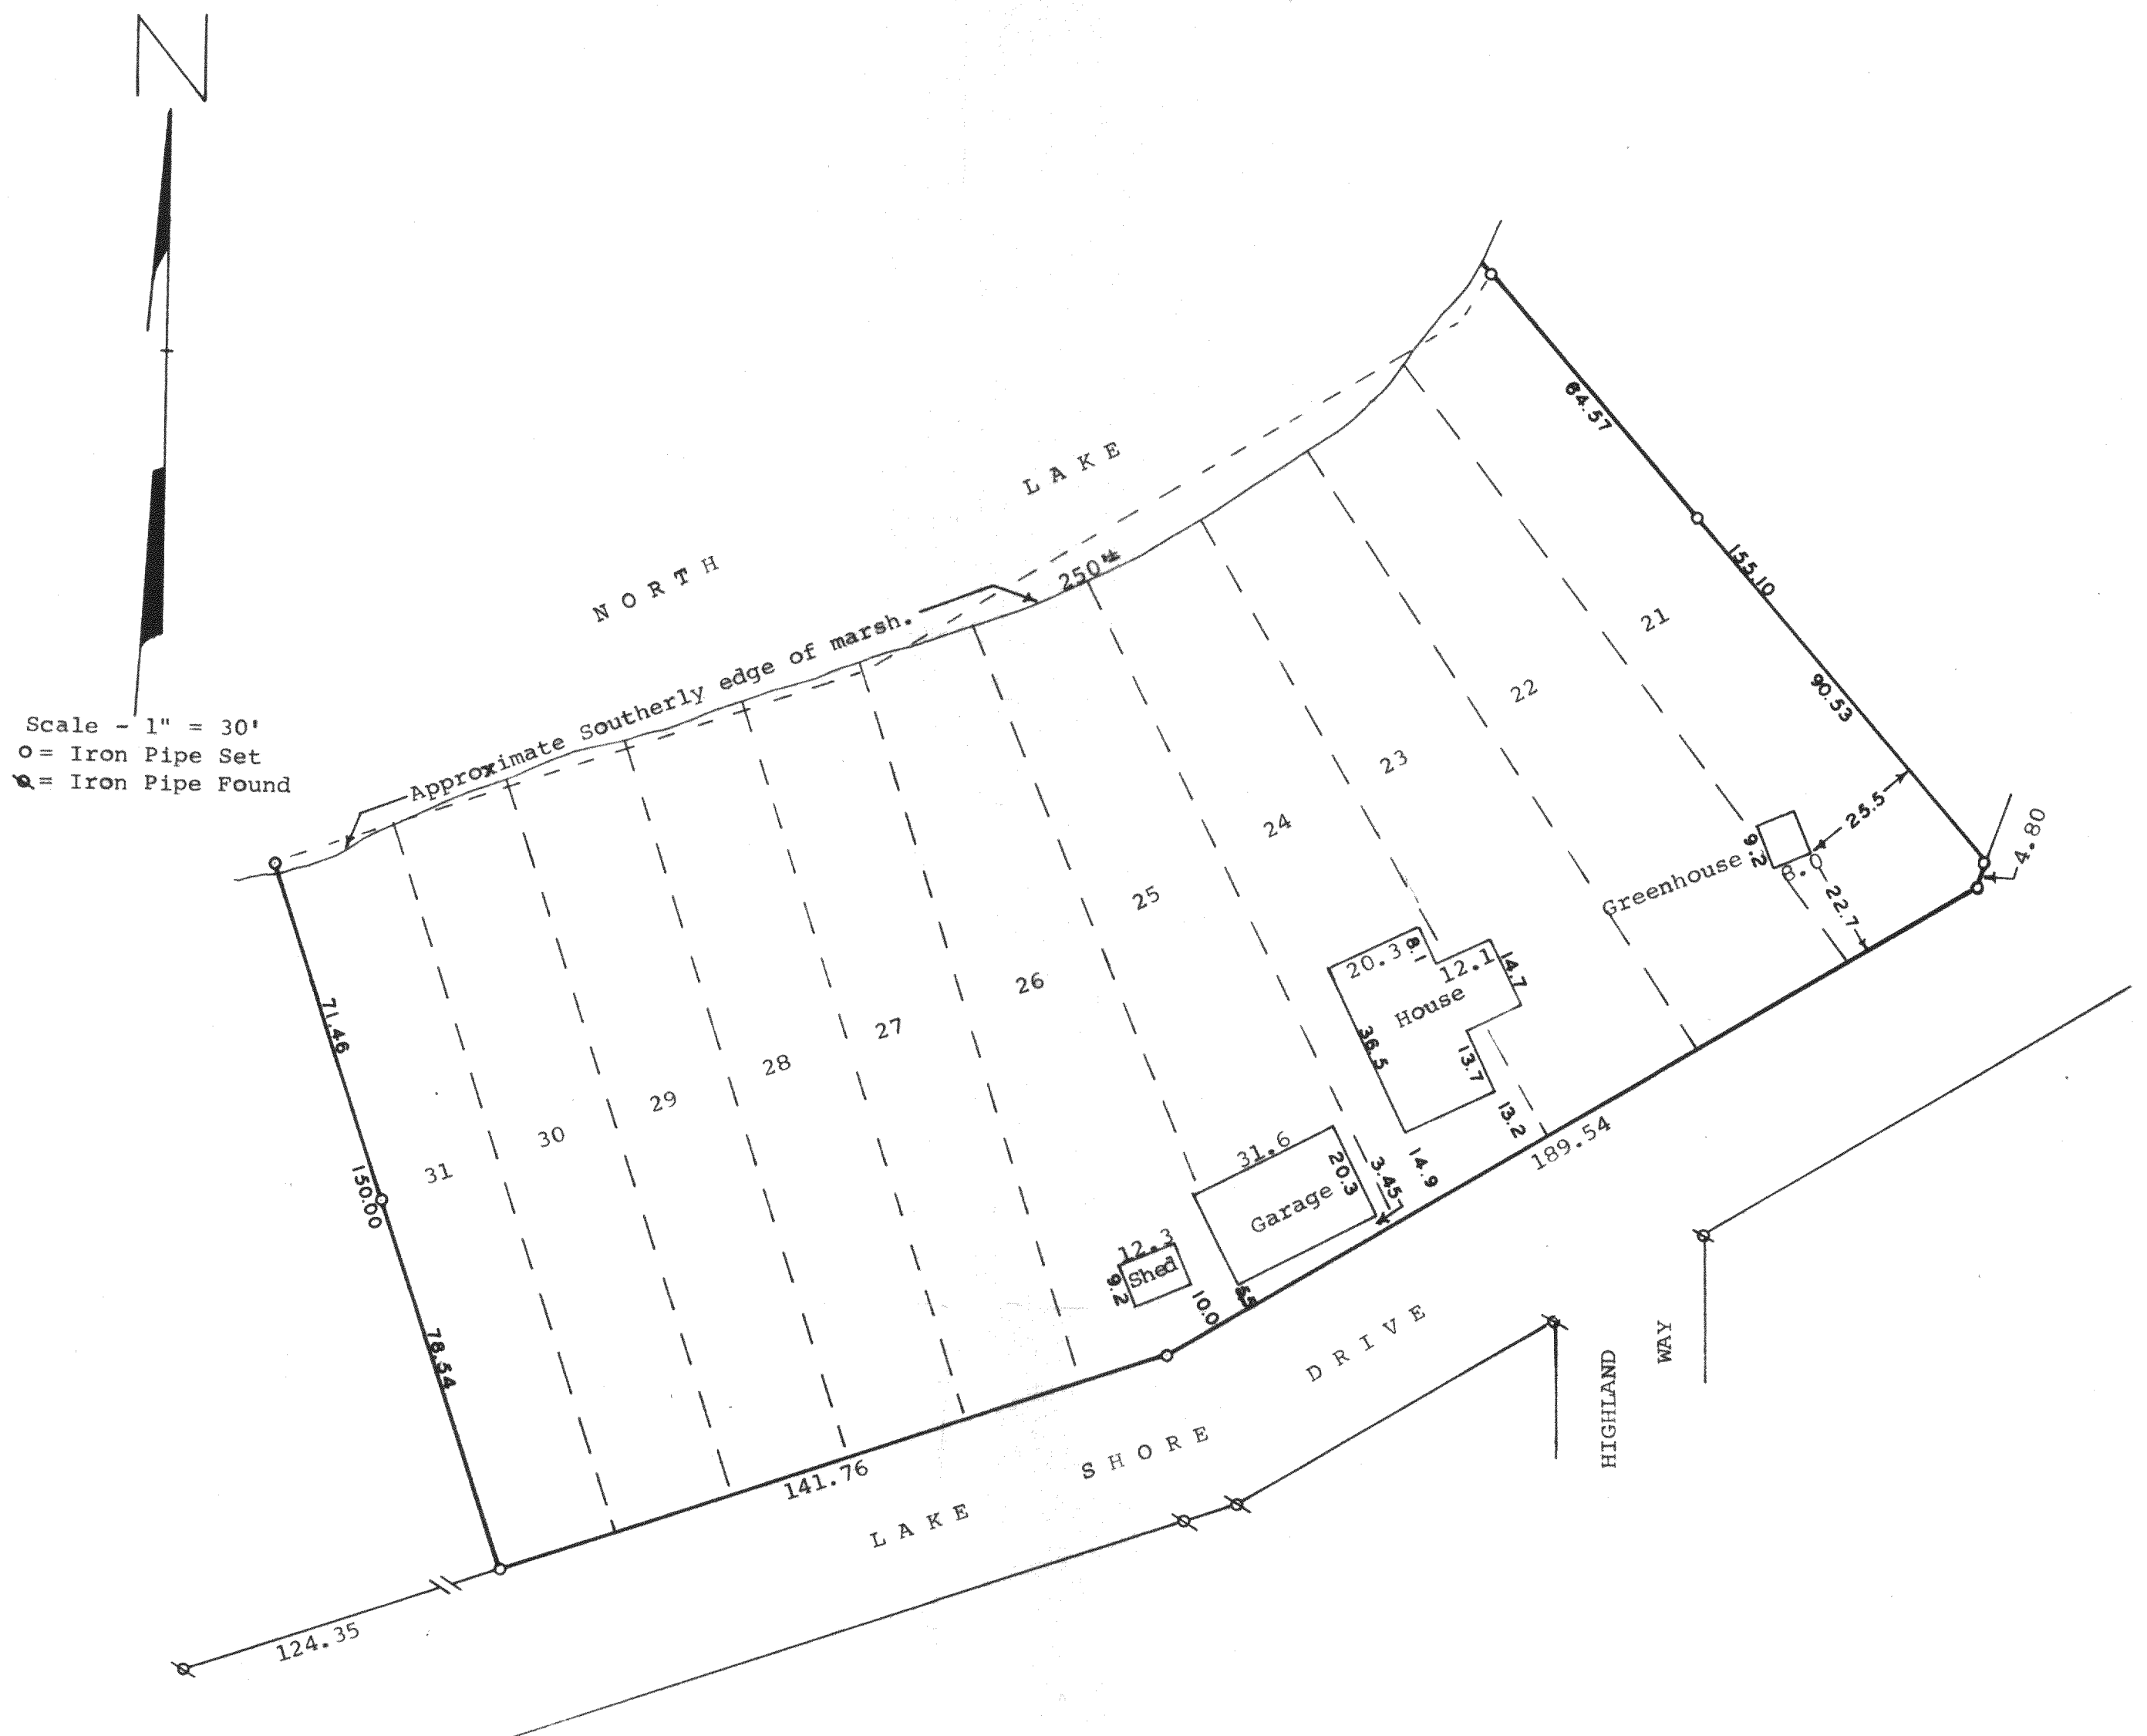

STATE OF WISCONSIN)
COUNTY OF WALWORTH)SS


I, George T. Dunham, Surveyor, certify that I have surveyed the property described as follows,

Lots 21-31, inclusive of Block "A" of North Lake Beach,
Tract No. 3, a subdivision located in Section 5, T3N, R16E,
Walworth County, Wisconsin,

and the above map is a true representation thereof and shows the size and location of the property, its exterior boundaries, the location and dimensions of all structures thereon, apparent easements and roadways and visible encroachments, if any.

October 28, 1977

George T. Dunham
George T. Dunham, Surveyor

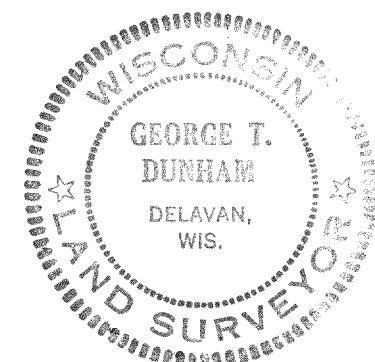

GMLB3-326
" 302
" 303
" 304
" 304A

316-243