


PLAT OF SURVEY  
FOUNDATION ASBUILT

LOT 2 OF CERTIFIED SURVEY MAP NUMBER 4064, BEING PART OF THE SOUTHWEST ¼ OF THE  
NORTHEAST ¼ OF SECTION 12, TOWN 3 NORTH, RANGE 16 EAST, LYING AND BEING IN THE  
TOWN OF SUGAR CREEK, COUNTY OF WALWORTH AND STATE OF WISCONSIN.



0' 30'  
SCALE 1" = 30'

NOTES:  
  
THIS PARCEL IS SUBJECT TO ALL AND ANY  
RESTRICTIONS, EASEMENTS AND NOTES  
SHOWN ON CERTIFIED SURVEY MAP  
NUMBER 4064 RECORDED AT THE WALWORTH  
COUNTY REGISTER OF DEEDS.  
  
PROPOSED GRADES PER GRADING PLAN OR  
ADJUSTED BY BUILDER. CONTRACTOR TO  
VERIFY ALL PROPOSED GRADES AND WALL  
HEIGHTS PRIOR TO EXCAVATION.

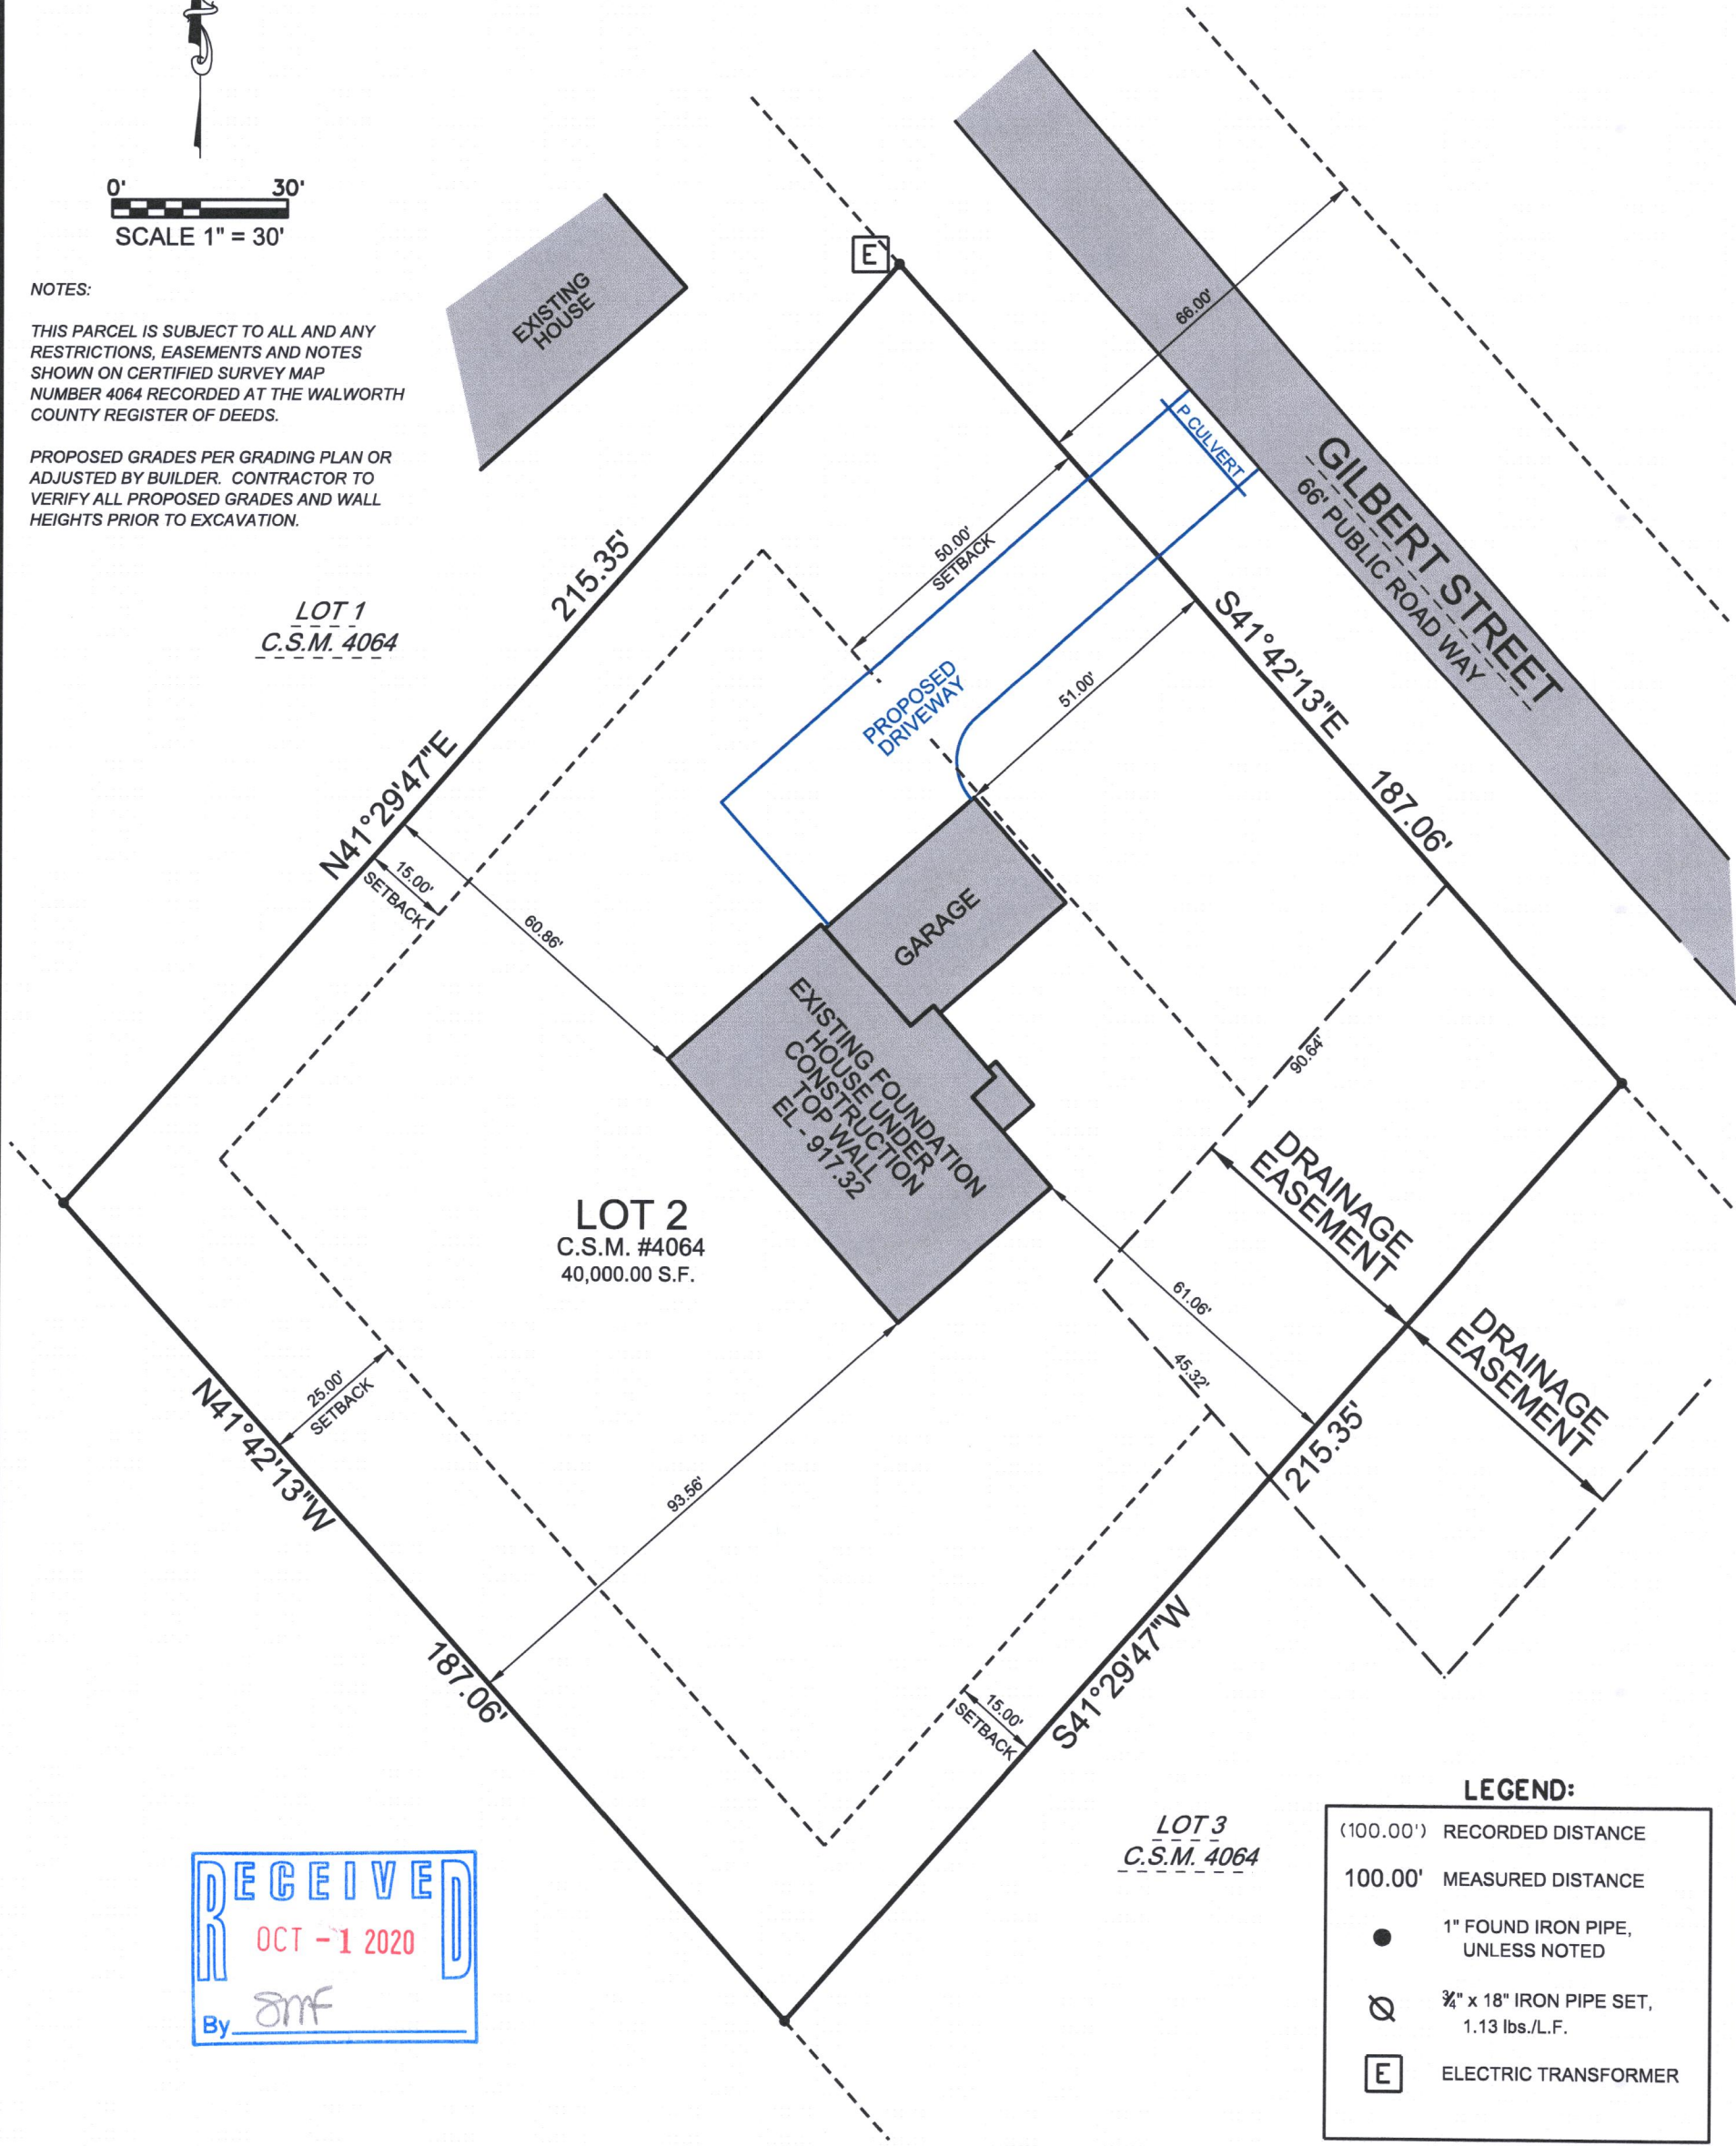

RECEIVED  
OCT -1 2020  
By *SMF*

LEGEND:

- (100.00') RECORDED DISTANCE
- 100.00' MEASURED DISTANCE
- 1" FOUND IRON PIPE, UNLESS NOTED
- ⊗ ¾" x 18" IRON PIPE SET, 1.13 lbs./L.F.
- [E] ELECTRIC TRANSFORMER

**V<sup>2</sup>G**  
SURVEYING, LLC

123 WOLF RUN - SUITE 4  
MUKWONAGO, WI 53149  
(262) 378-5097

SURVEY MADE FOR:	
BIELINSKI HOMES, INC. 1830 MEADOW LANE PEWAUKEE, WI 53072	
DATE	ITEM
01/20/2020	PRELIM. SURVEY
01/22/2020	FINAL SURVEY
03/18/2020	REV. GARAGE GRD
04/06/2020	FOUND. ASBUILT

THIS SURVEY IS MADE FOR THE USE OF THE PRESENT OWNERS OF THE PROPERTY, AND ALSO THOSE WHO PURCHASE, MORTGAGE OR GUARANTEE TITLE TO WITHIN ONE (1) YEAR FROM DATE HERETO.

I, MICHAEL A. GREESON P.L.S. #2770, HEREBY CERTIFY THAT THIS SURVEY WAS MADE IN ACCORDANCE WITH THE MINIMUM STANDARDS FOR PROPERTY SURVEYS (CHAPTER A-E 7) FOR THE STATE OF WISCONSIN AND HAS BEEN PREPARED UNDER MY DIRECTION AND CONTROL AND IS CORRECT TO THE BEST OF MY KNOWLEDGE AND BELIEF.

WISCONSIN  
Michael A. Greeson  
S-2770  
East Troy  
Wis  
*Michael A. Greeson*

PLOT DATE: 04/06/2020

V2G JOB#: 2020-003