
PLAT OF SURVEY

OF

LOT 6, BLOCK 10, COOL HILL ADDITION No. 1, LOCATED IN THE SW 1/4 OF SECTION 35 AND THE SE 1/4 OF SECTION 34, TOWN 4 NORTH, RANGE 16 EAST, AND THE NW 1/4 OF SECTION 2 AND THE NE 1/4 OF SECTION 3, TOWN 3 NORTH, RANGE 16 EAST, WALWORTH COUNTY, WISCONSIN.

PREPARED FOR:

DEREK SMITH JENNIFER SMITH W 5736 LOST NATION ROAD ELKHORN, WI 53121

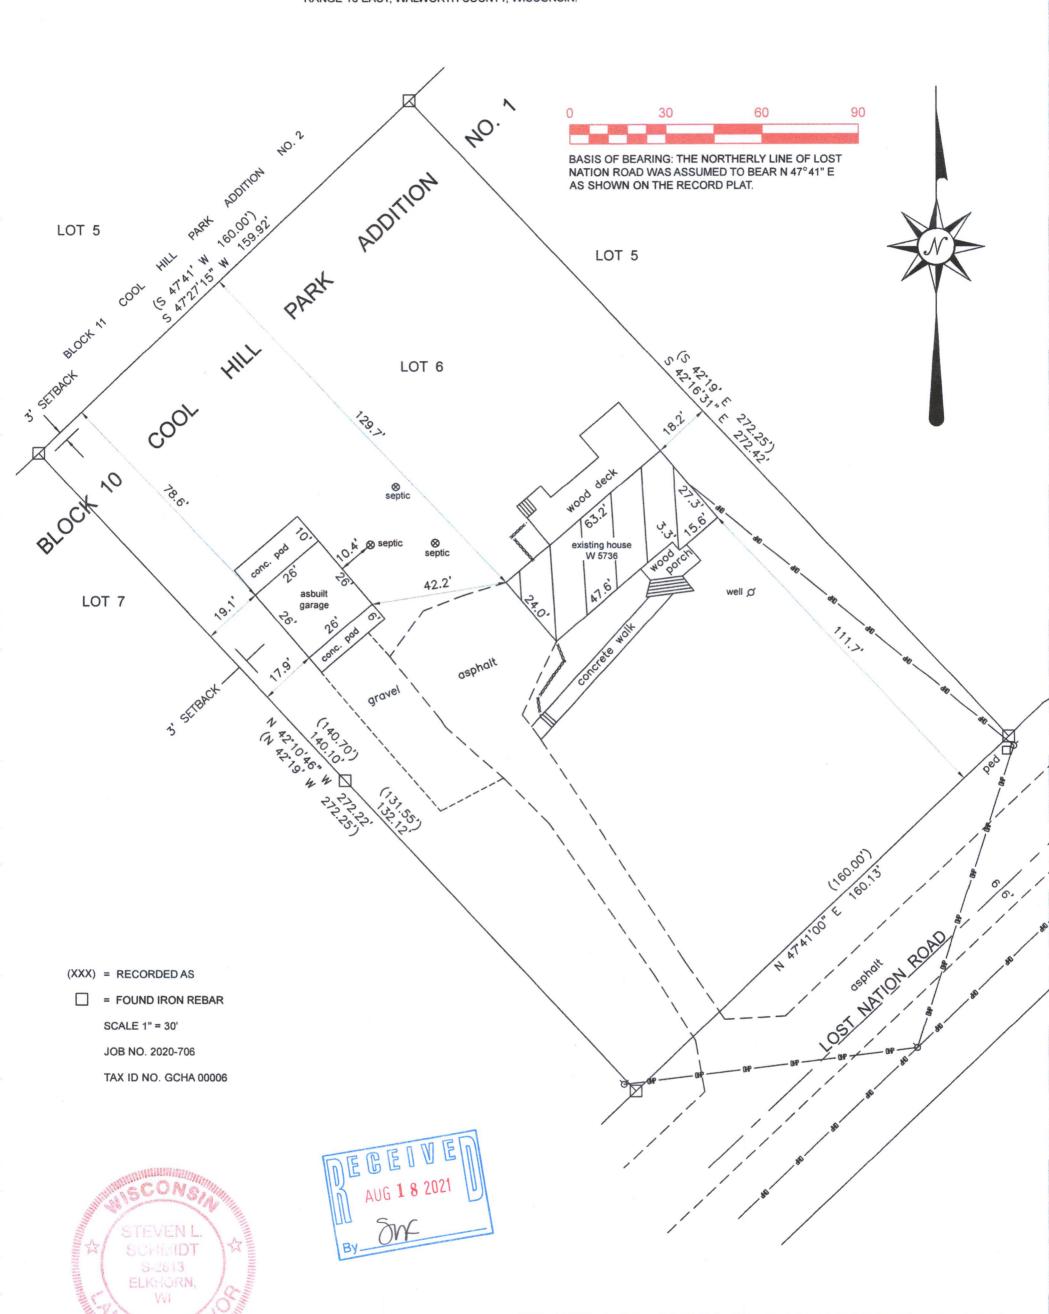

I HEREBY CERTIFY THAT I HAVE SURVEYED THE ABOVE DESCRIBED PROPERTY AND THE ABOVE MAP IS A TRUE REPRESENTATION THEREOF AND SHOWS THE SIZE AND LOCATION OF THE PROPERTY, ITS EXTERIOR BOUNDARIES, THE LOCATION AND DIMENSIONS OF ALL STRUCTURES THEREON, FENCES, APPARENT EASEMENTS, ROADWAYS, AND VISIBLE ENCROACHMENTS, IF ANY.

THIS SURVEY IS MADE FOR THE PRESENT OWNERS OF THE PROPERTY, AND THOSE WHO PURCHASE, MORTGAGE, OR GUARANTEE THE TITLE THERETO WITHIN ONE YEAR FROM THE DATE HEREOF.

DATED THIS 13TH DAY OF AUGUST 2020

REVISED DECEMBER 20, 2020 TO SHOW ASBUILT GARAGE.

GCHA-Le

STEVEN L SCHMIDT S - 2813 Wisconsin Professional Land Surveyor

(original if signed in red)

316-2485