


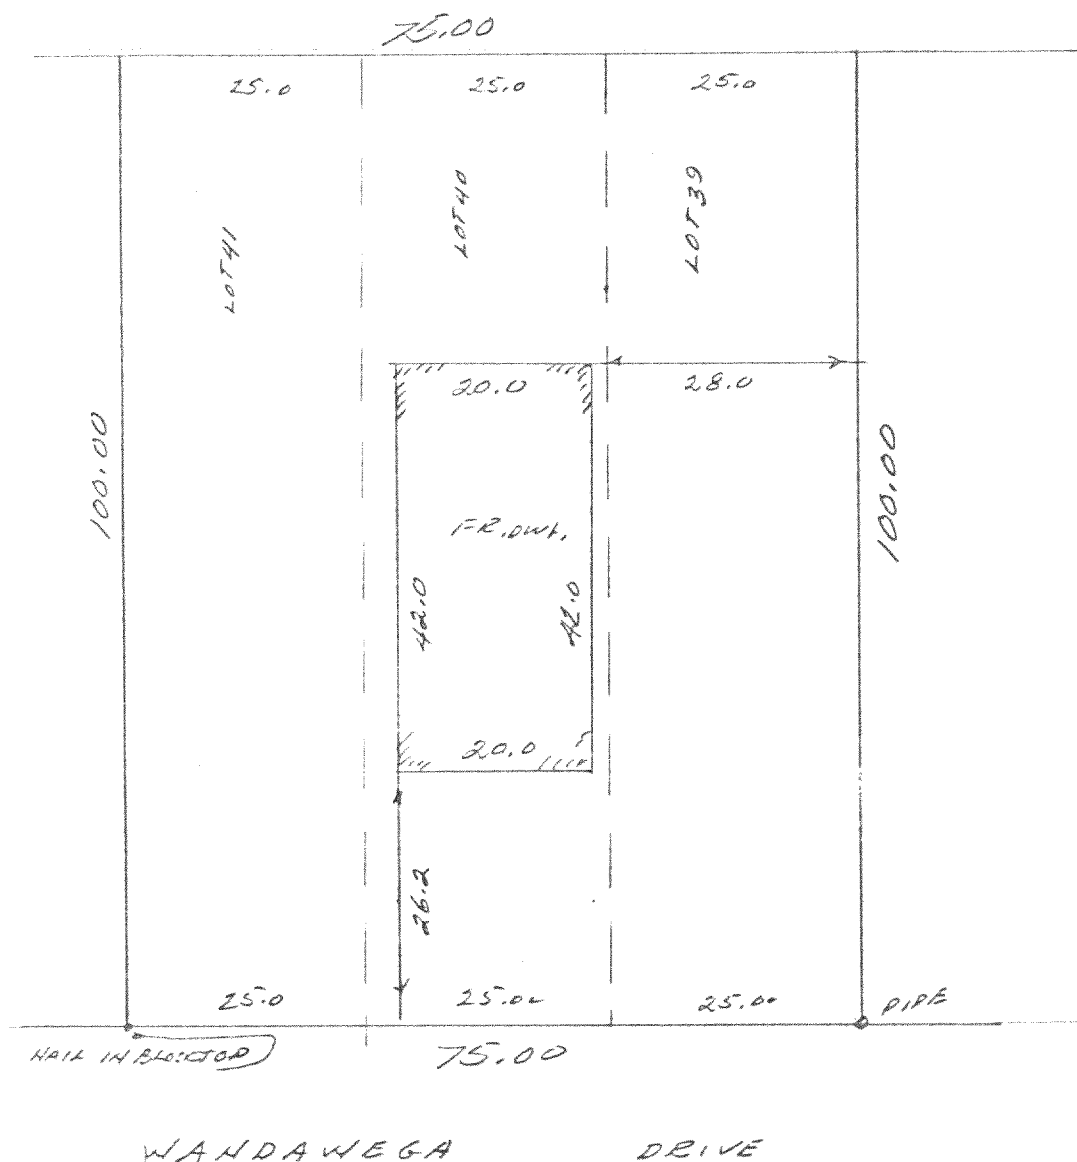

LOTS 39, 40 AND 41 IN BLOCK 100
OF LAKE WANDAWEGA IN
THE TOWN OF SUGAR CREEK
STATE OF WISCONSIN.

Survey for:

Name: JOSEPH S. STORTS JR

Address of survey: _____

Part of _____ Quarter of
Section 1 Town 3 N.R. 16 E.

SCALE 1"=20'

Ref: _____

Date of survey, 4-1-78

SURVEY NO. 4551-1

6LW-214

SURVEY CERTIFICATE

I CERTIFY THAT I HAVE SURVEYED THE ABOVE DESCRIBED (PROPERTY) AND THE ABOVE MAP IS A TRUE REPRESENTATION THEREOF AND SHOWS THE SIZE AND LOCATION OF THE PROPERTY, ITS EXTERIOR BOUNDARIES, THE LOCATION AND DIMENSIONS OF ALL VISIBLE STRUCTURES THEREON, FENCES, APPARENT EASEMENTS AND ROADWAYS AND VISIBLE ENCROACHMENTS, IF ANY.

THIS SURVEY IS MADE FOR THE EXCLUSIVE USE OF THE PRESENT OWNERS OF THE PROPERTY, AND ALSO THOSE WHO PURCHASE, MORTGAGE, OR GUARANTEE THE TITLE THERETO WITHIN ONE (1) YEAR FROM DATE HEREOF, AND AS TO THEM I WARRANT THE ACCURACY OF SAID SURVEY AND MAP.

Harold M. Schneider
HAROLD M. SCHNEIDER

316-250